



**CITY OF SUPERIOR
SEWER PLAN**

Contract let April 3, 1891
 " completed Aug. 20, 1891
 Joseph Wolf, Contractor
 P. S. McHugh, Inspector
 E. B. Banks, City Engineer

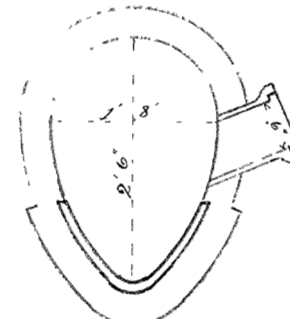


Section of 18" x 26" Sewer

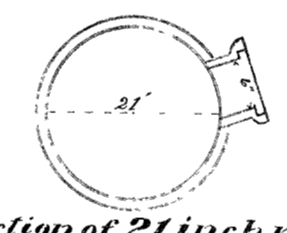

Section of 21 inch pipe

Scale: { Horizontal 1" = 60'
 Vertical 1" = 4'
 Section 1" = 2'

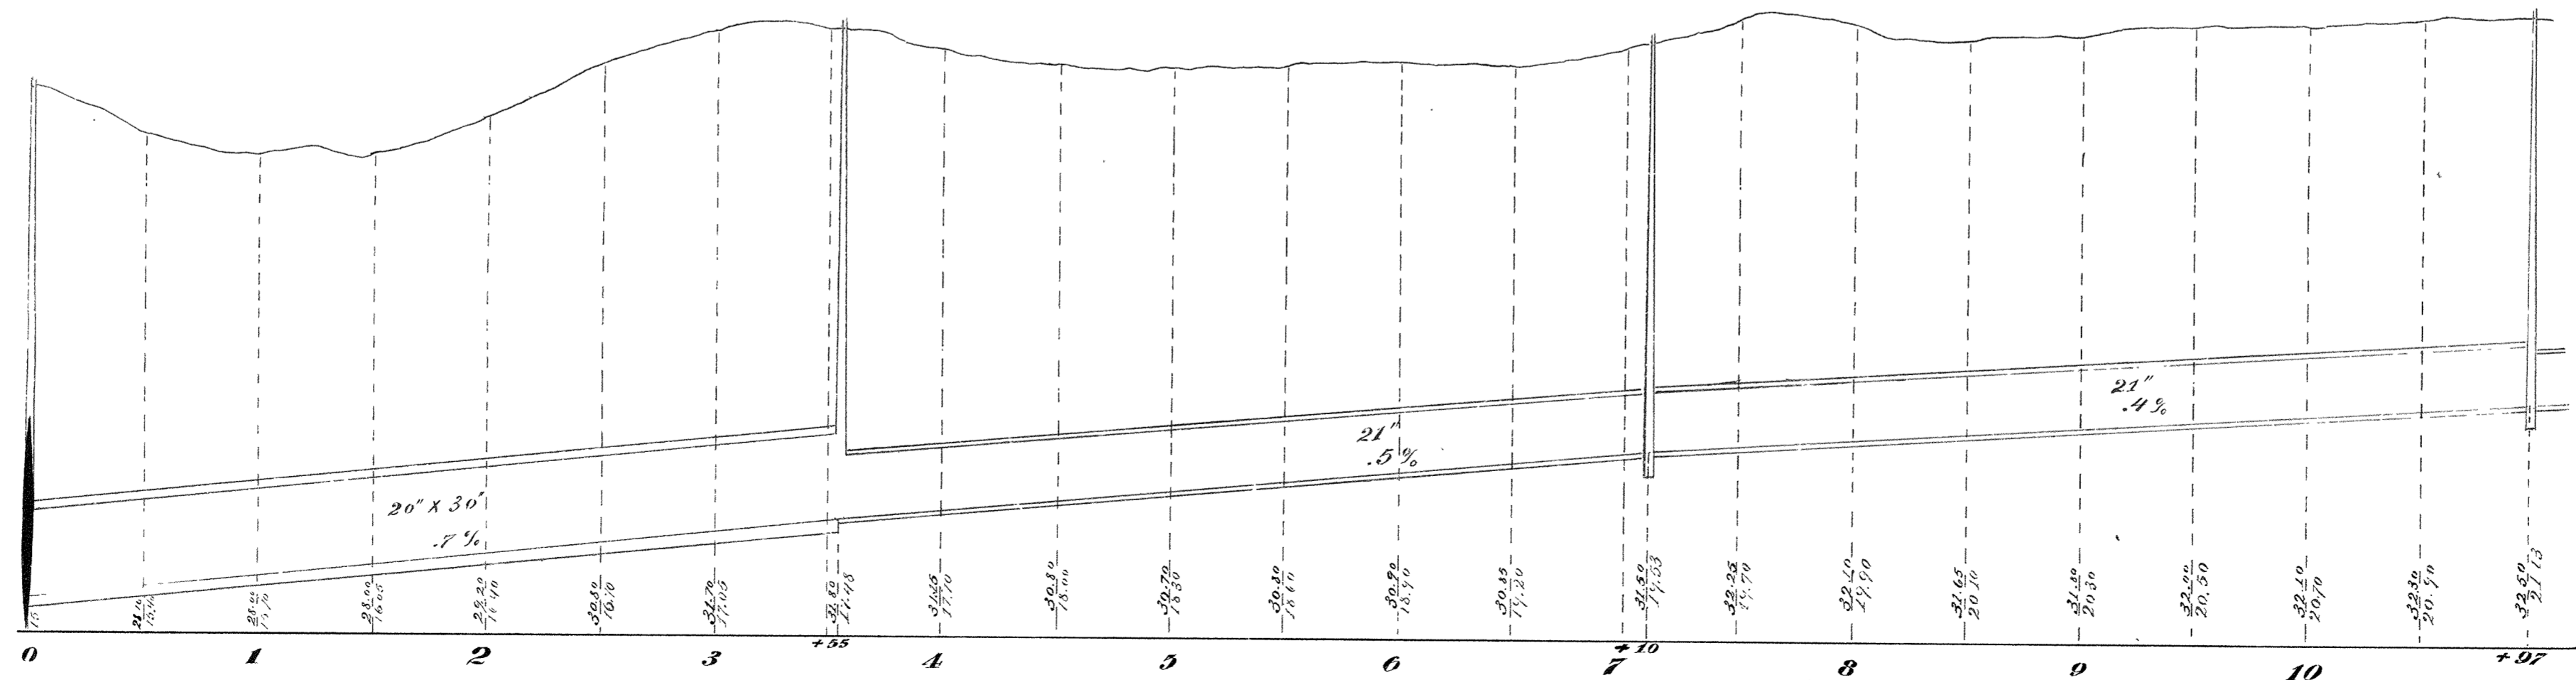

Profile of Sewer in Alley betw. Cumming & Baxter Aves. from Broadway to 13th St.

Base line 14' above City datum

2 A-40