


**CITY OF SUPERIOR
SEWER PLAN**

Contract let April 16, 1891
 Completed Nov. 1, 1891
 Joseph Wolf, Contractor
 W. R. Russell, Inspector
 E. B. Banks, City Engineer



Scale { Horizontal 1 inch = 60 ft.
 Vertical 1 inch = 4 ft.
 Sectional 1 inch = 2 ft.

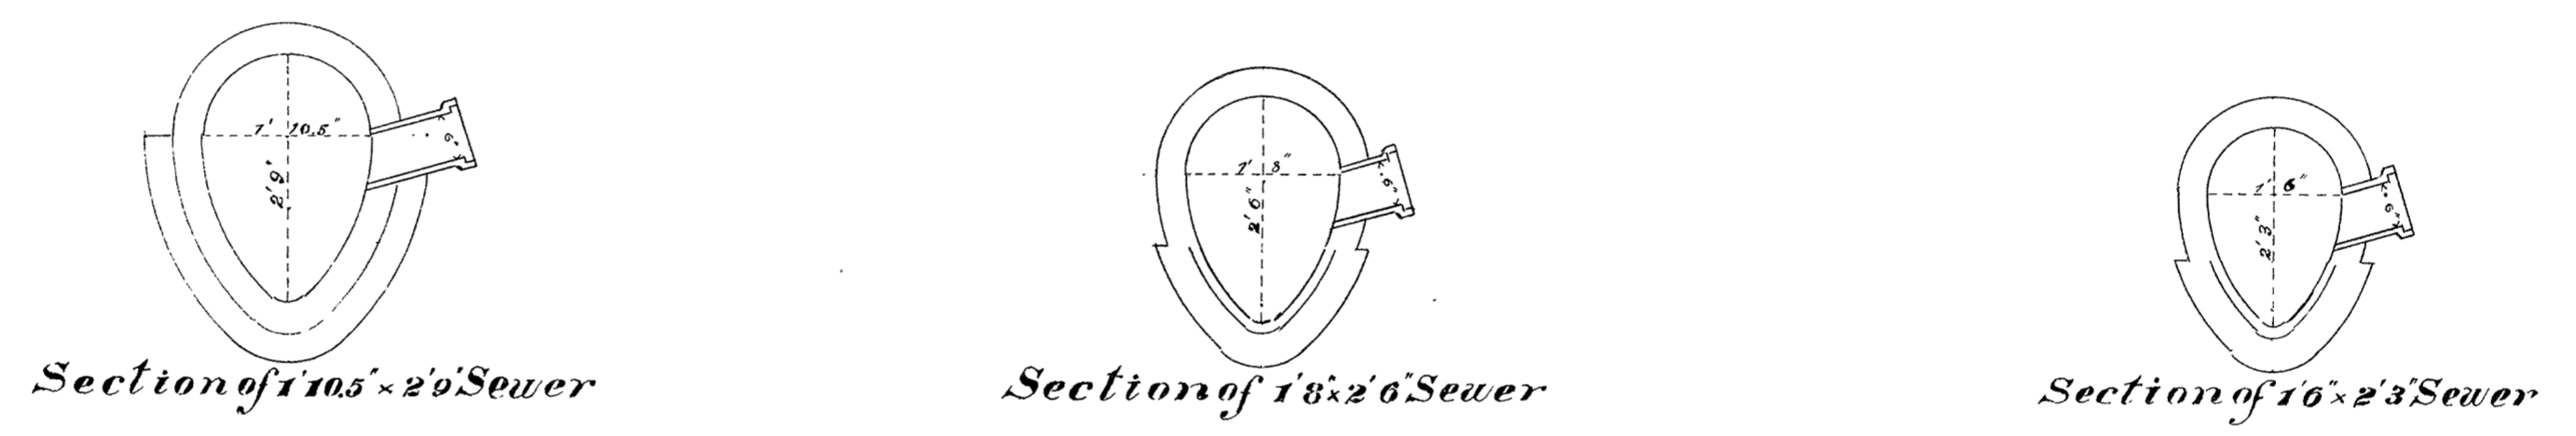