


CITY OF SUPERIOR SEWER PLAN


HORIZONTAL SCALE: 1 IN. = 60 FT.
VERTICAL SCALE: 1 IN. = 4 FT.

CONTRACT NO. 1241

Contract let Aug 22, 1910.
Contract completed Nov. 26, 1910.
Andrew Johnson Contractor.
Andrew Solin Inspector.
E. B. Banks City Engineer.

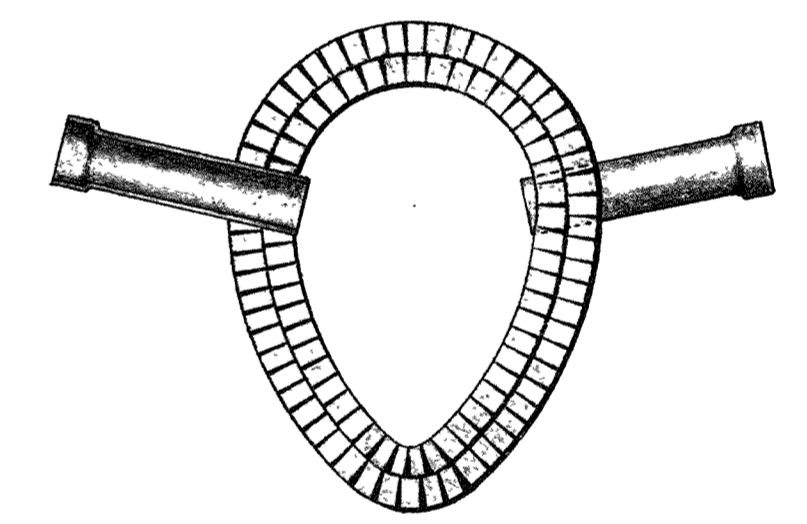

SECTION OF
2'-6" X 3'-9" SEWER.
1/2 IN. = 1 FT.

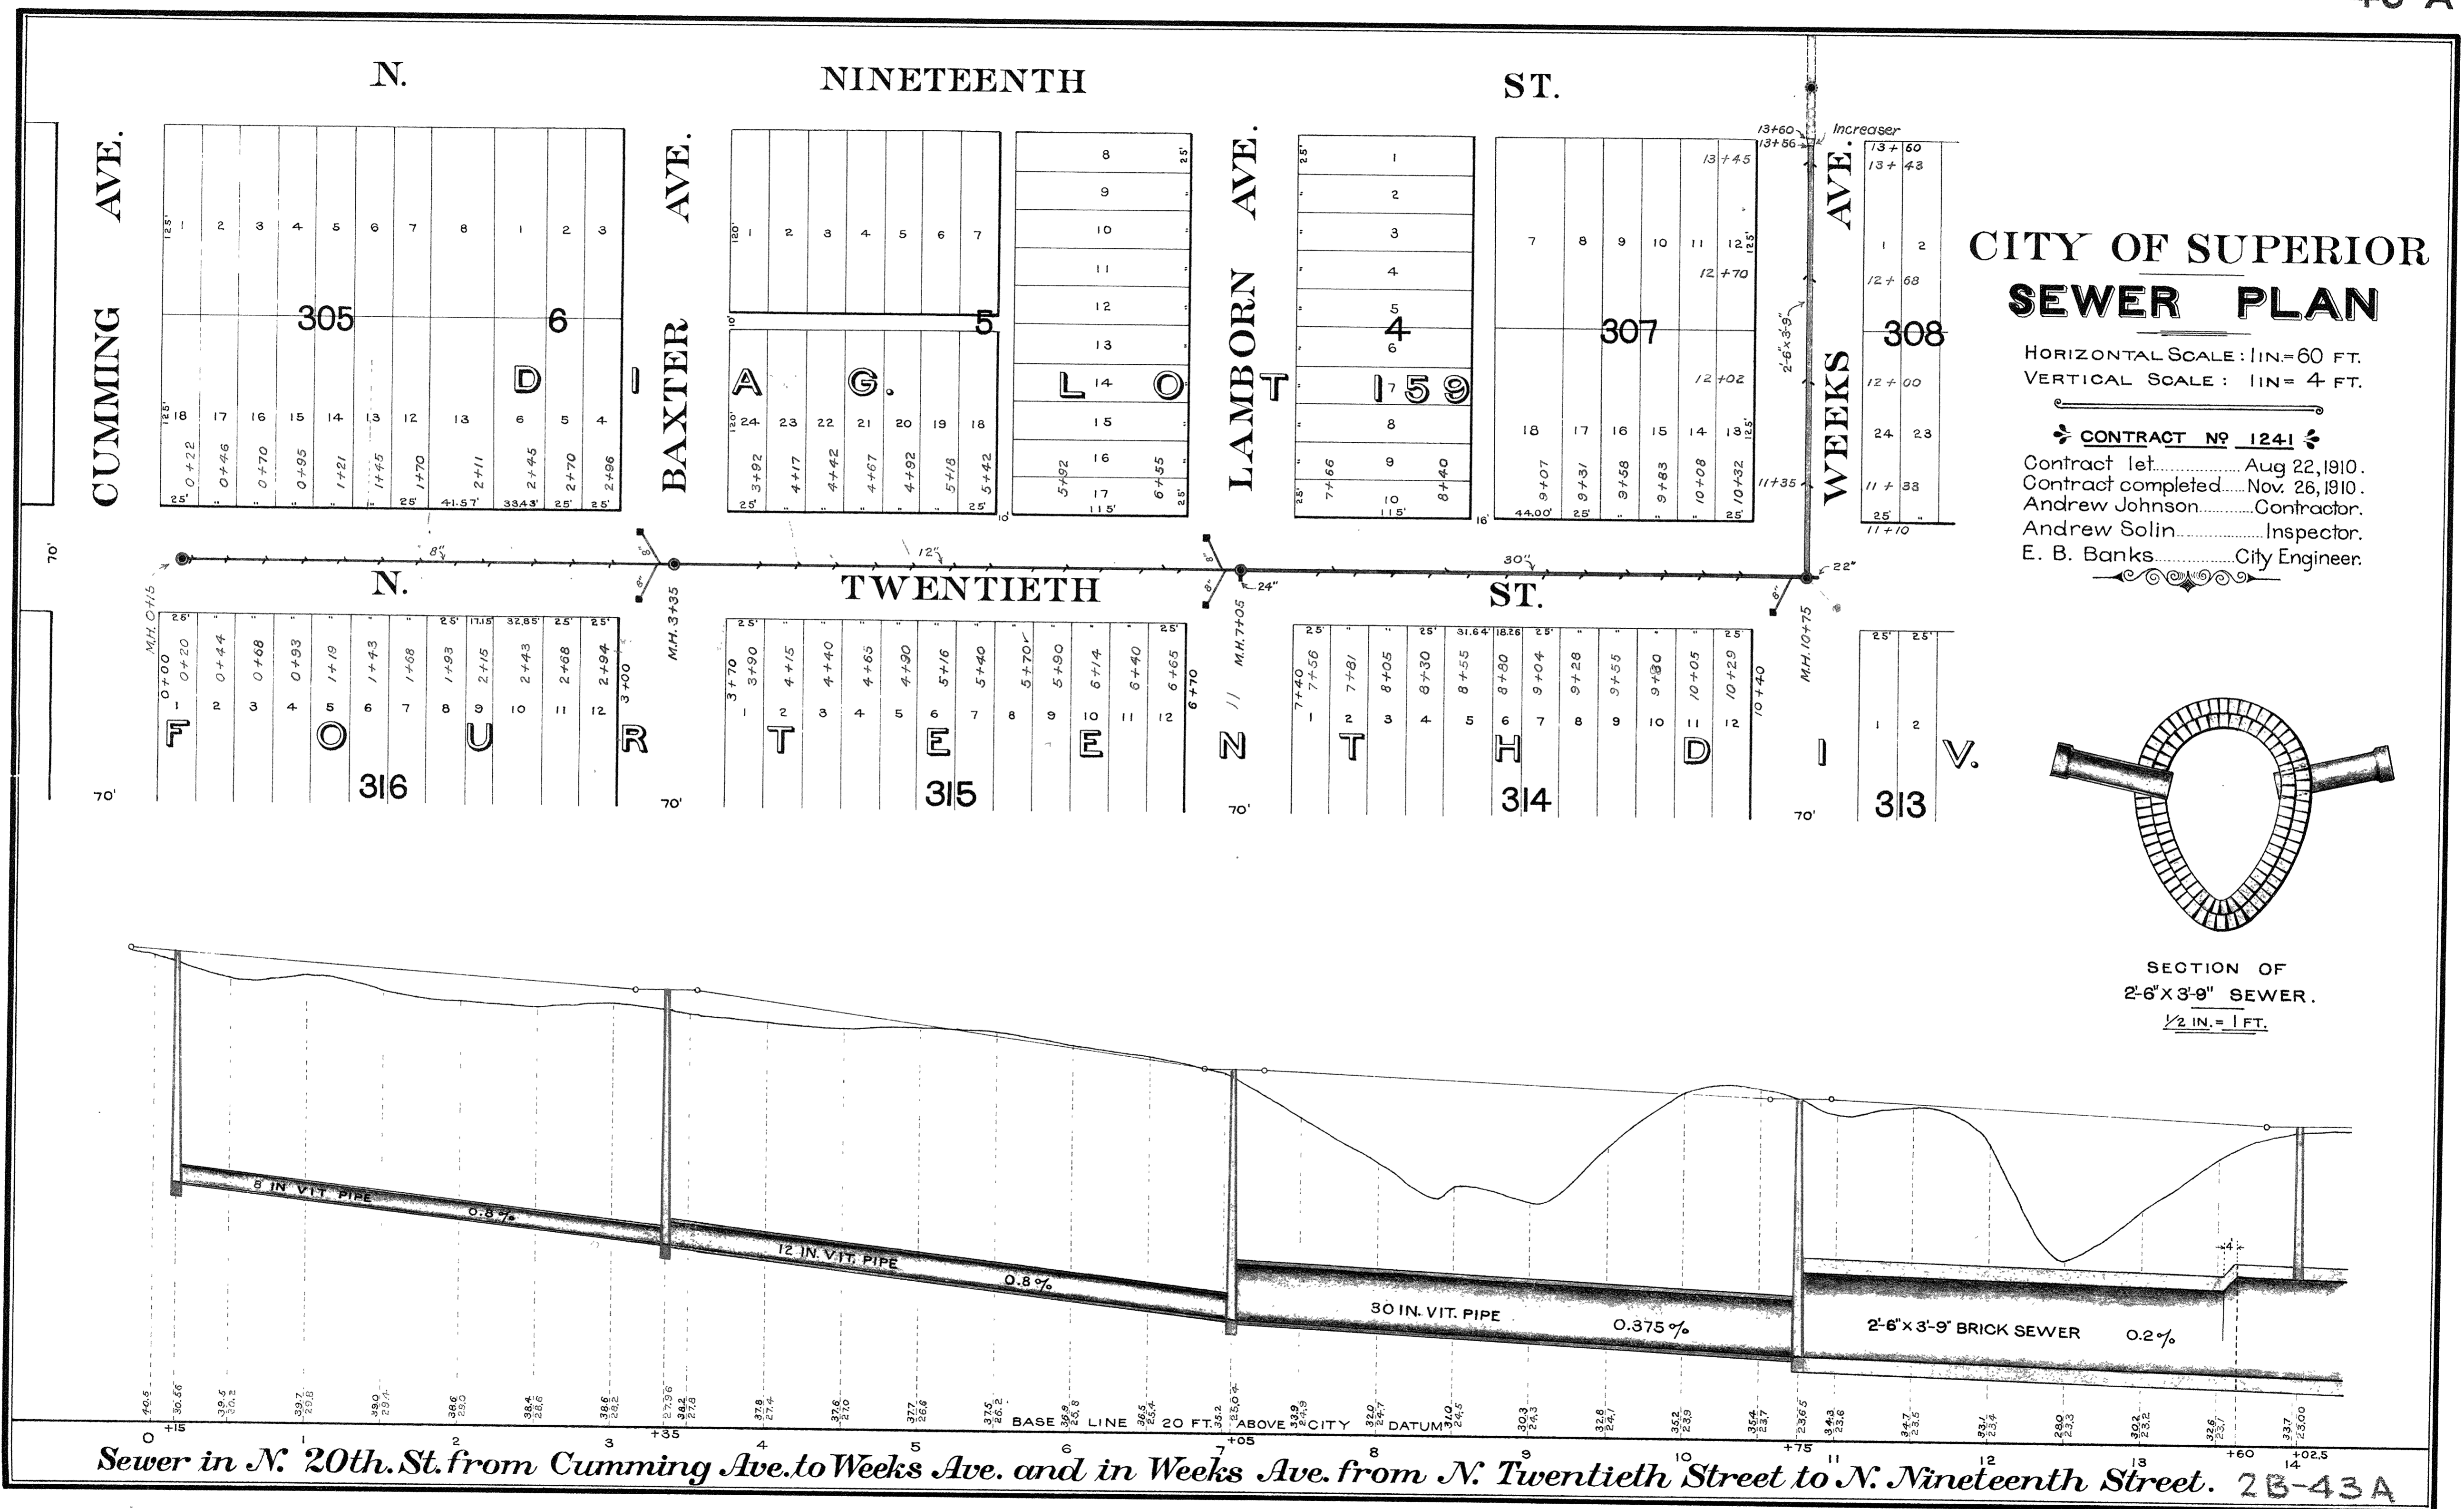

Sewer in N. 20th. St. from Cumming Ave. to Weeks Ave. and in Weeks Ave. from N. Twentieth Street to N. Nineteenth Street. 2B-43A