


CITY OF SUPERIOR


1894

SEWER PLAN


Contract let May 26 1890  
 completed Sept  
 Forrestal Bros. Contractor-failed.  
 Earnshaw & Stevenson, Inspectors  
 E. B. Banks, City Engr.

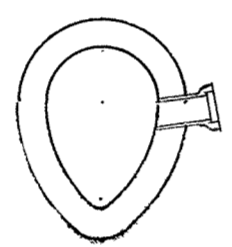


Section of 22x33" Sewer

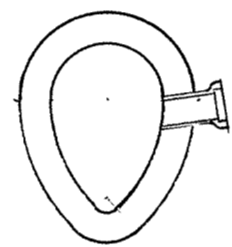

Section of 24x36" Sewer

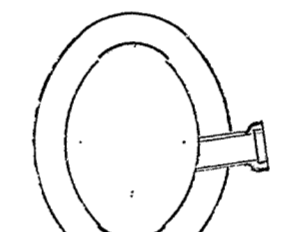


Section of 28x40" Sewer

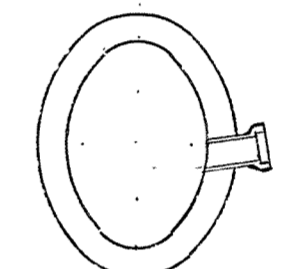

Section of 30x43" Sewer

Scale: Horizontal 60'-1"  
 Vertical 4'-1"  
 Section 4'-1"

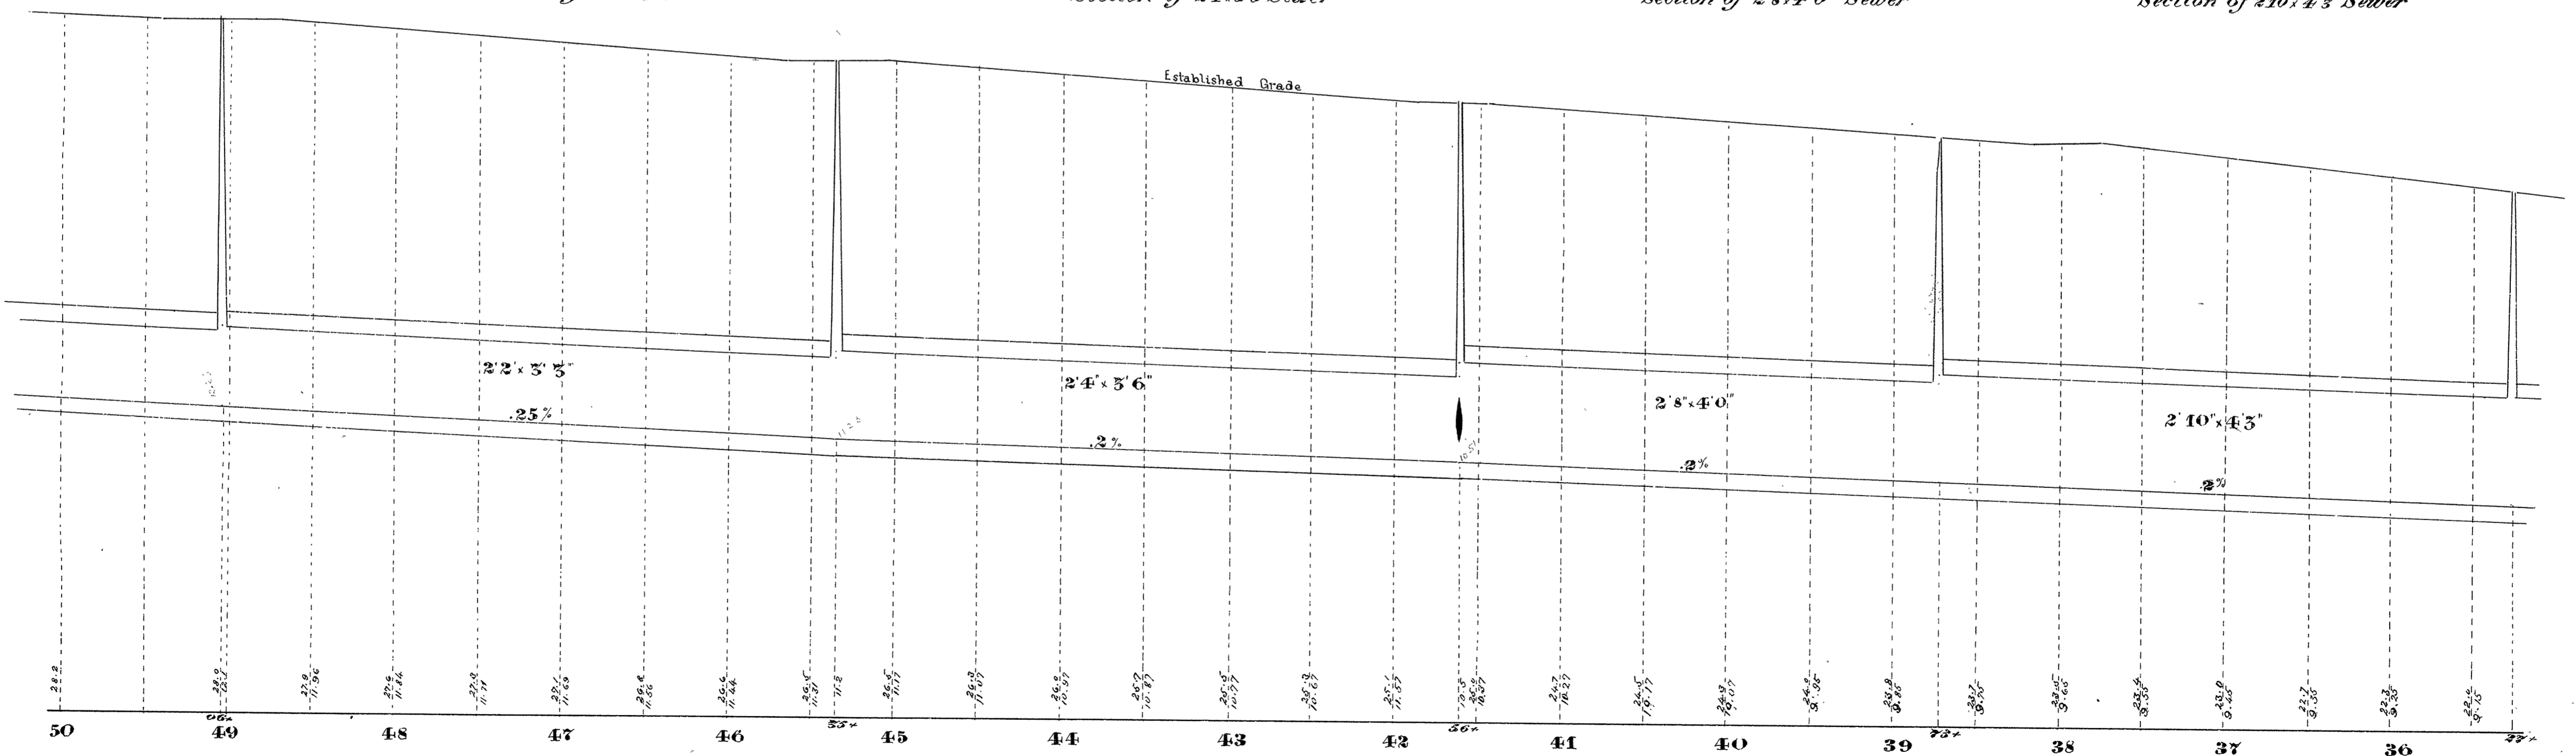

Plan & Profile of Sewer in Winter St. from Fisher Ave. to Baxter Ave.

2B-44