

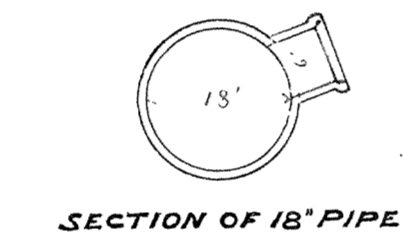


1901
CITY OF SUPERIOR
SEWER PLAN
 CONTRACT LET JUNE 17TH 1901
 COMPLETED AUG 6TH 1901
 CONT. 632 STACK BROS.
 CONTRA.
 FRANK RICHARDSON INSPECTOR
 E. B. BANKS CITY ENGR.

1902
 CONTRACT LET FROM ST. 15+26.5 TO ST. 18+01.5 AUG. 29
 COMPLETED OCT. 15TH 1902
 CONT. 699 MAGNUS PETERSON
 CONTRA.
 FRANK RICHARDSON
 INSPECTOR
 HOWARD THOMAS
 CITY ENGR.

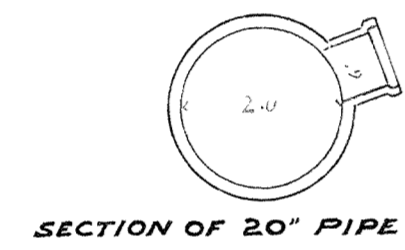

SCALE { HORIZONTAL ... 1" = 60'
 VERTICAL 1" = 4'
 SECTIONS 1" = 2'

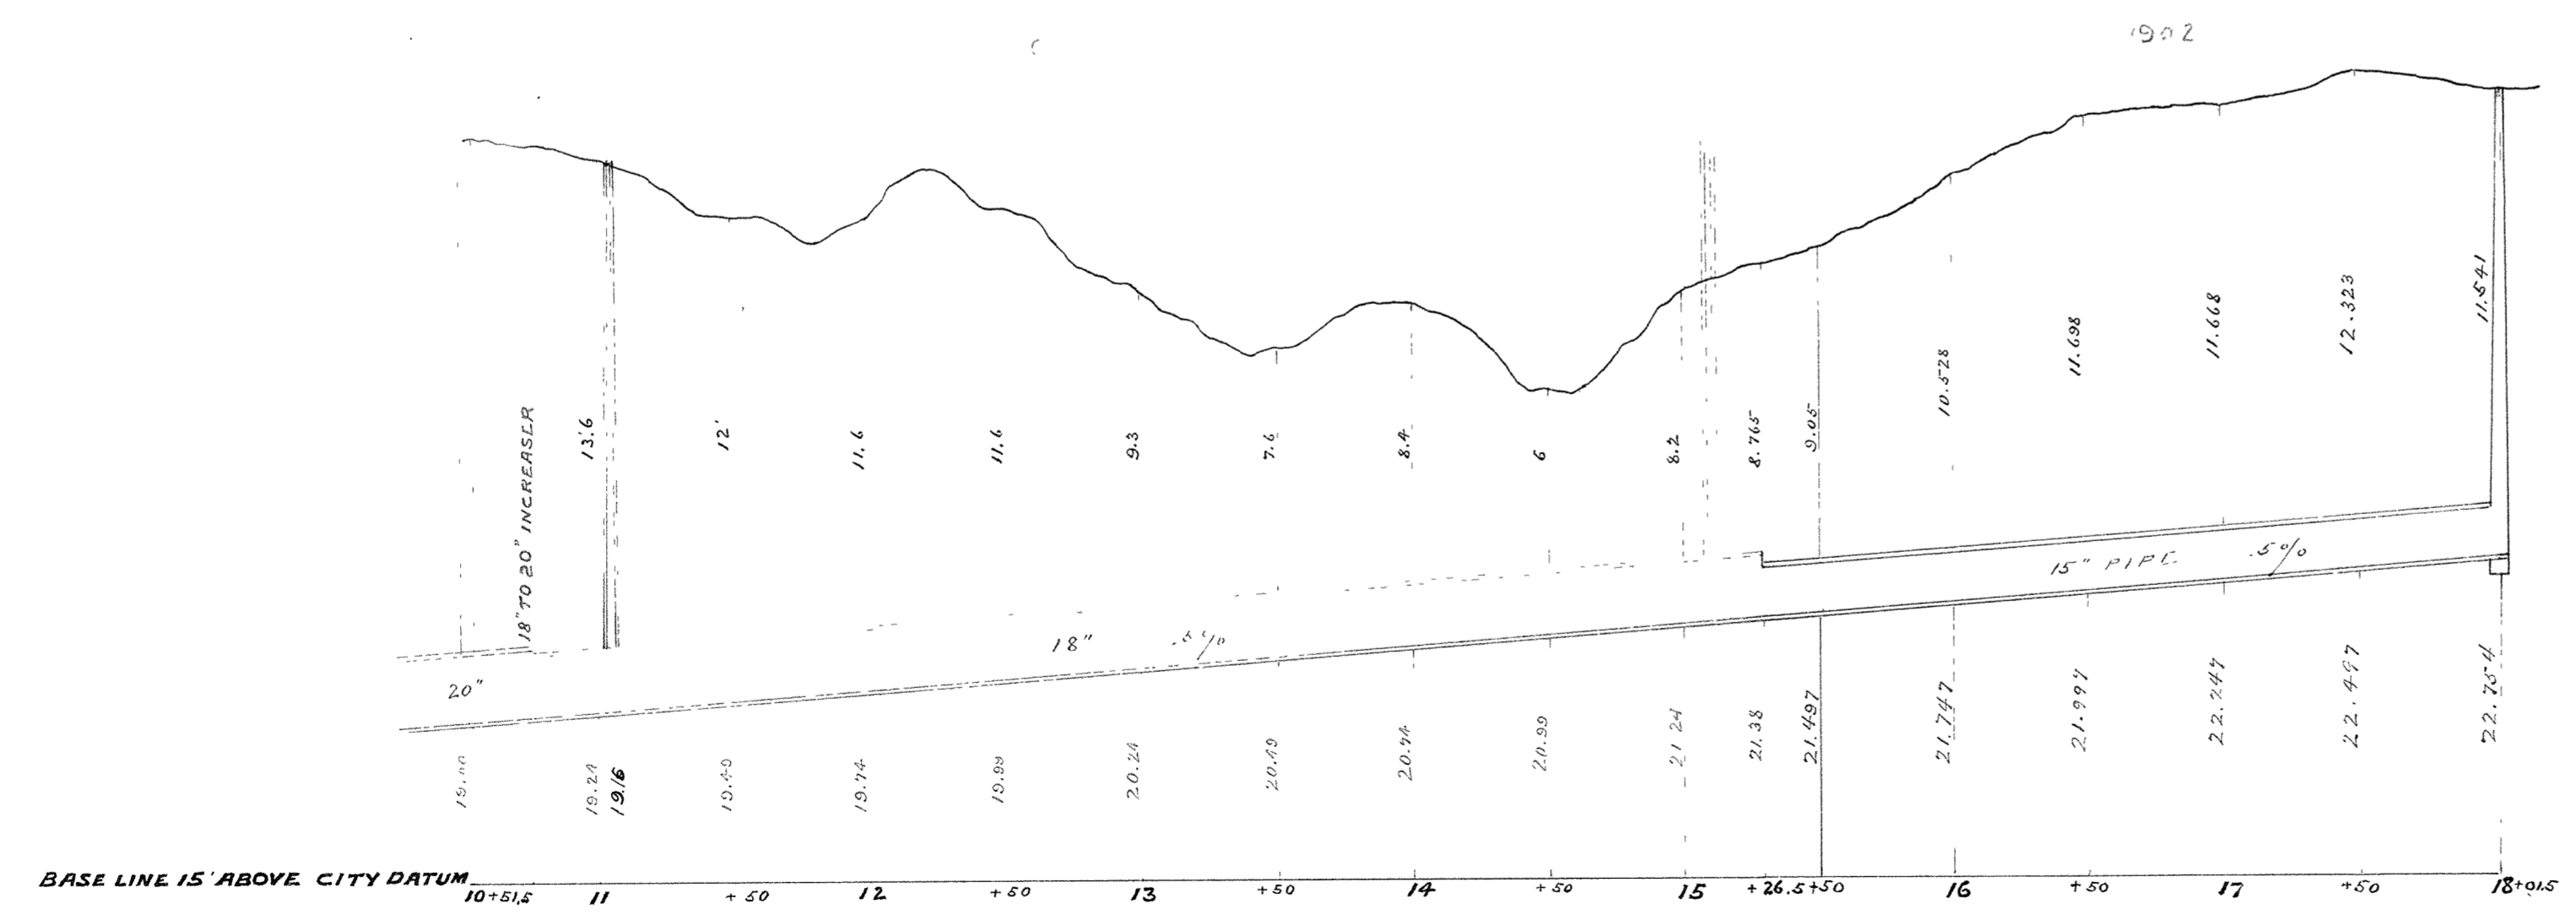

2B-46