




1893
CITY OF SUPERIOR
SEWER PLAN

Contract let April 3, 1891
 completed July 14, 1891
 Joseph Wolf, Contractor
 Finlay McKenzie, Inspector
 E. B. Banks, City Engineer

Scale: { Horizontal 60' = 1"
 Vertical 4' = 1"
 Section 2' = 1"

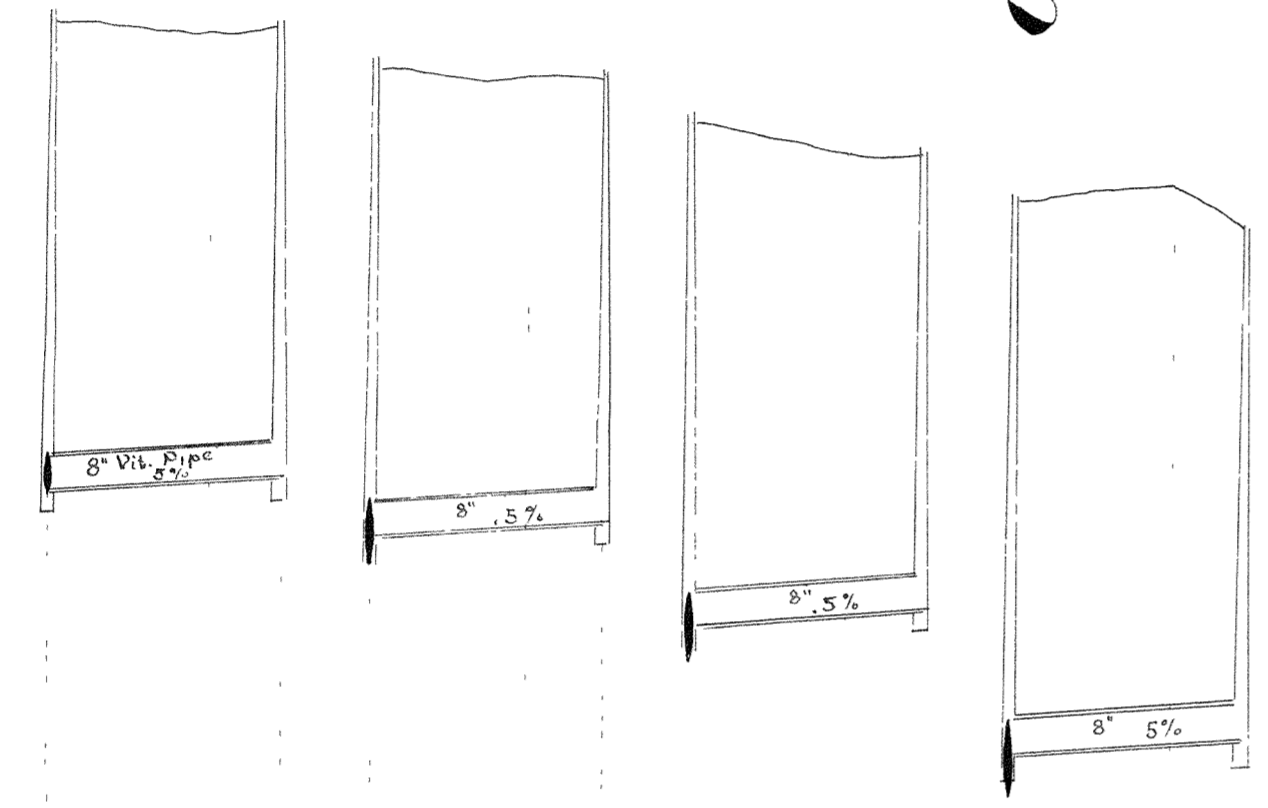

Base line 14' above datum
 Profile from StoB
 Profile from CoD
 Profile from KwP
 Profile from GtoH

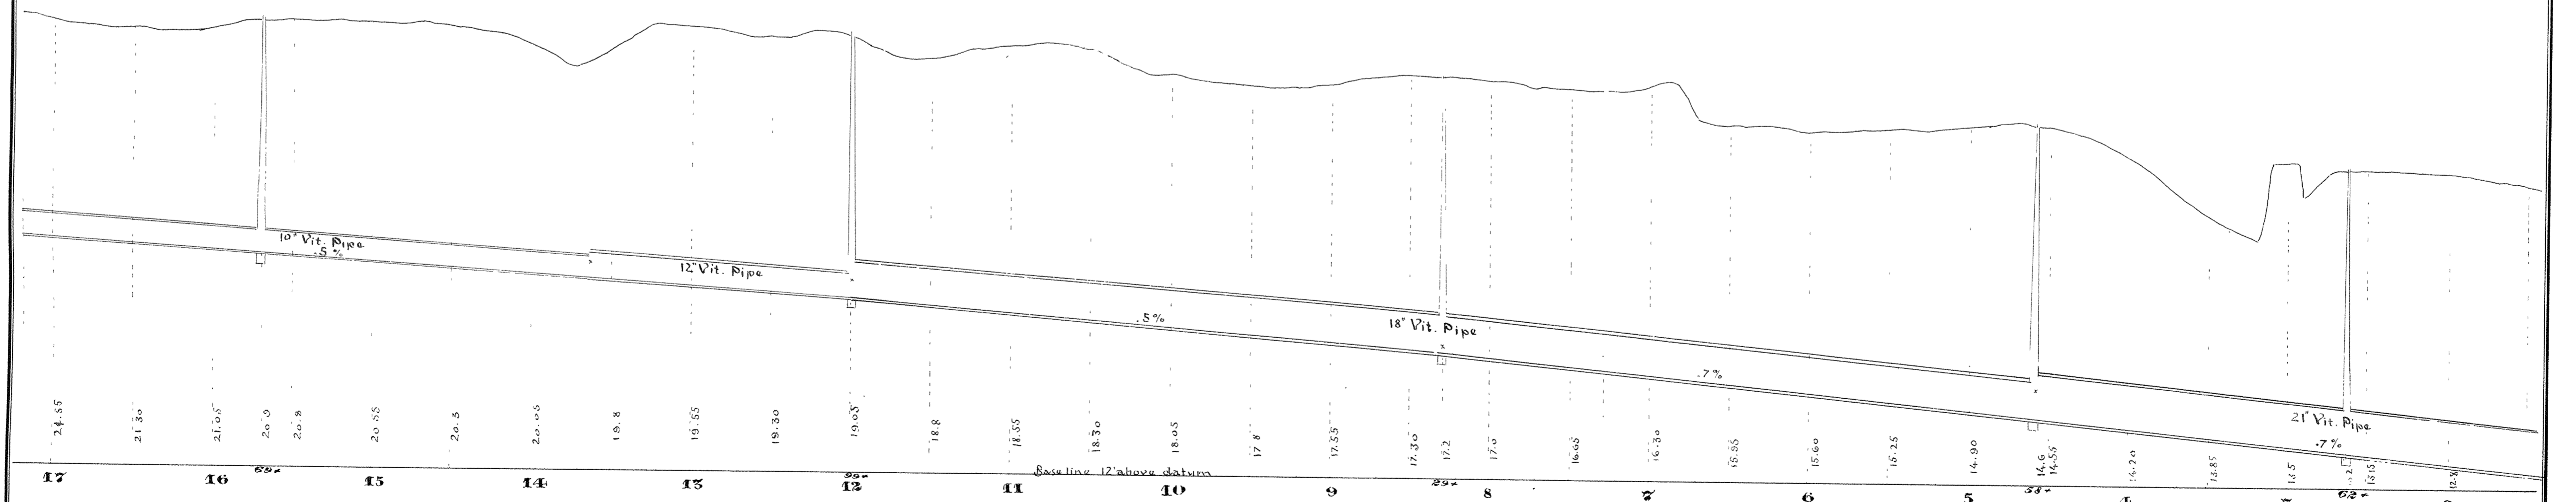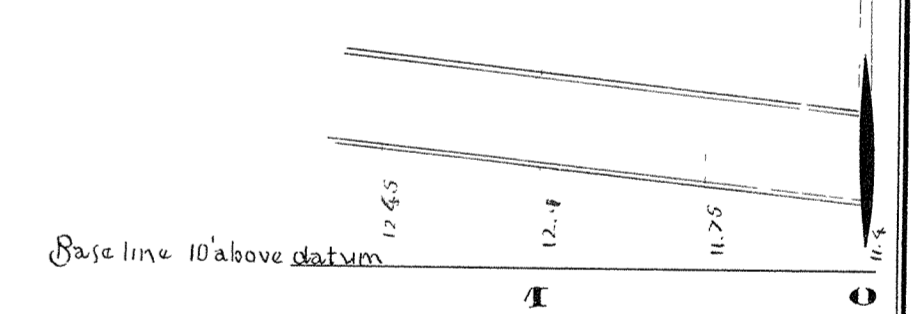

Plan & Profile of Sewer in Alley North of Broadway from Weeks to Hammond Avenue

2B-50