
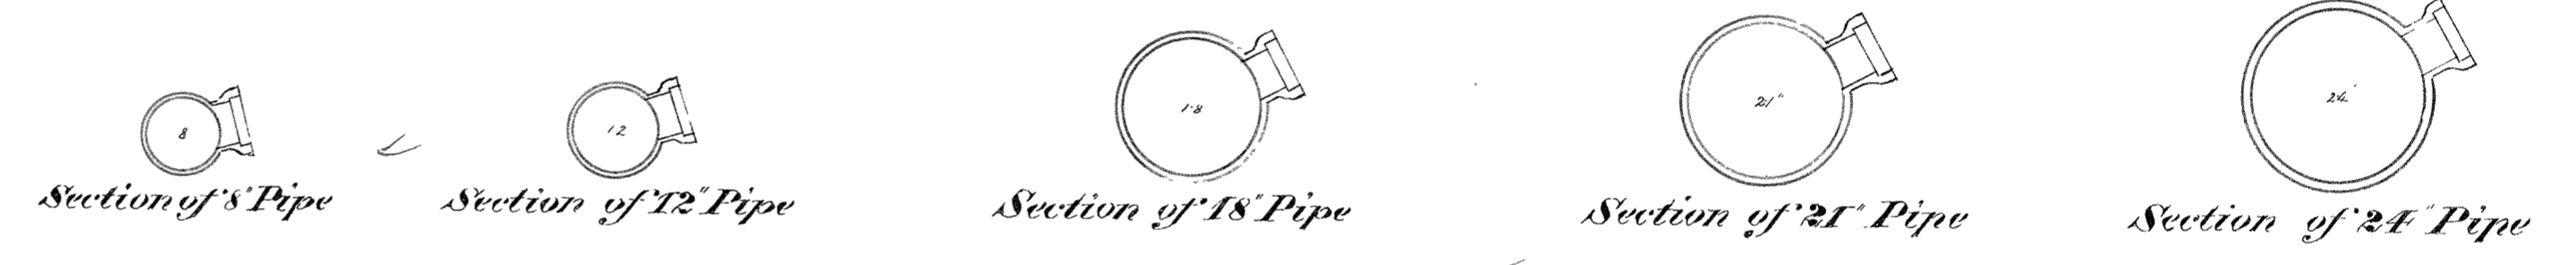


BROADWAY


1894

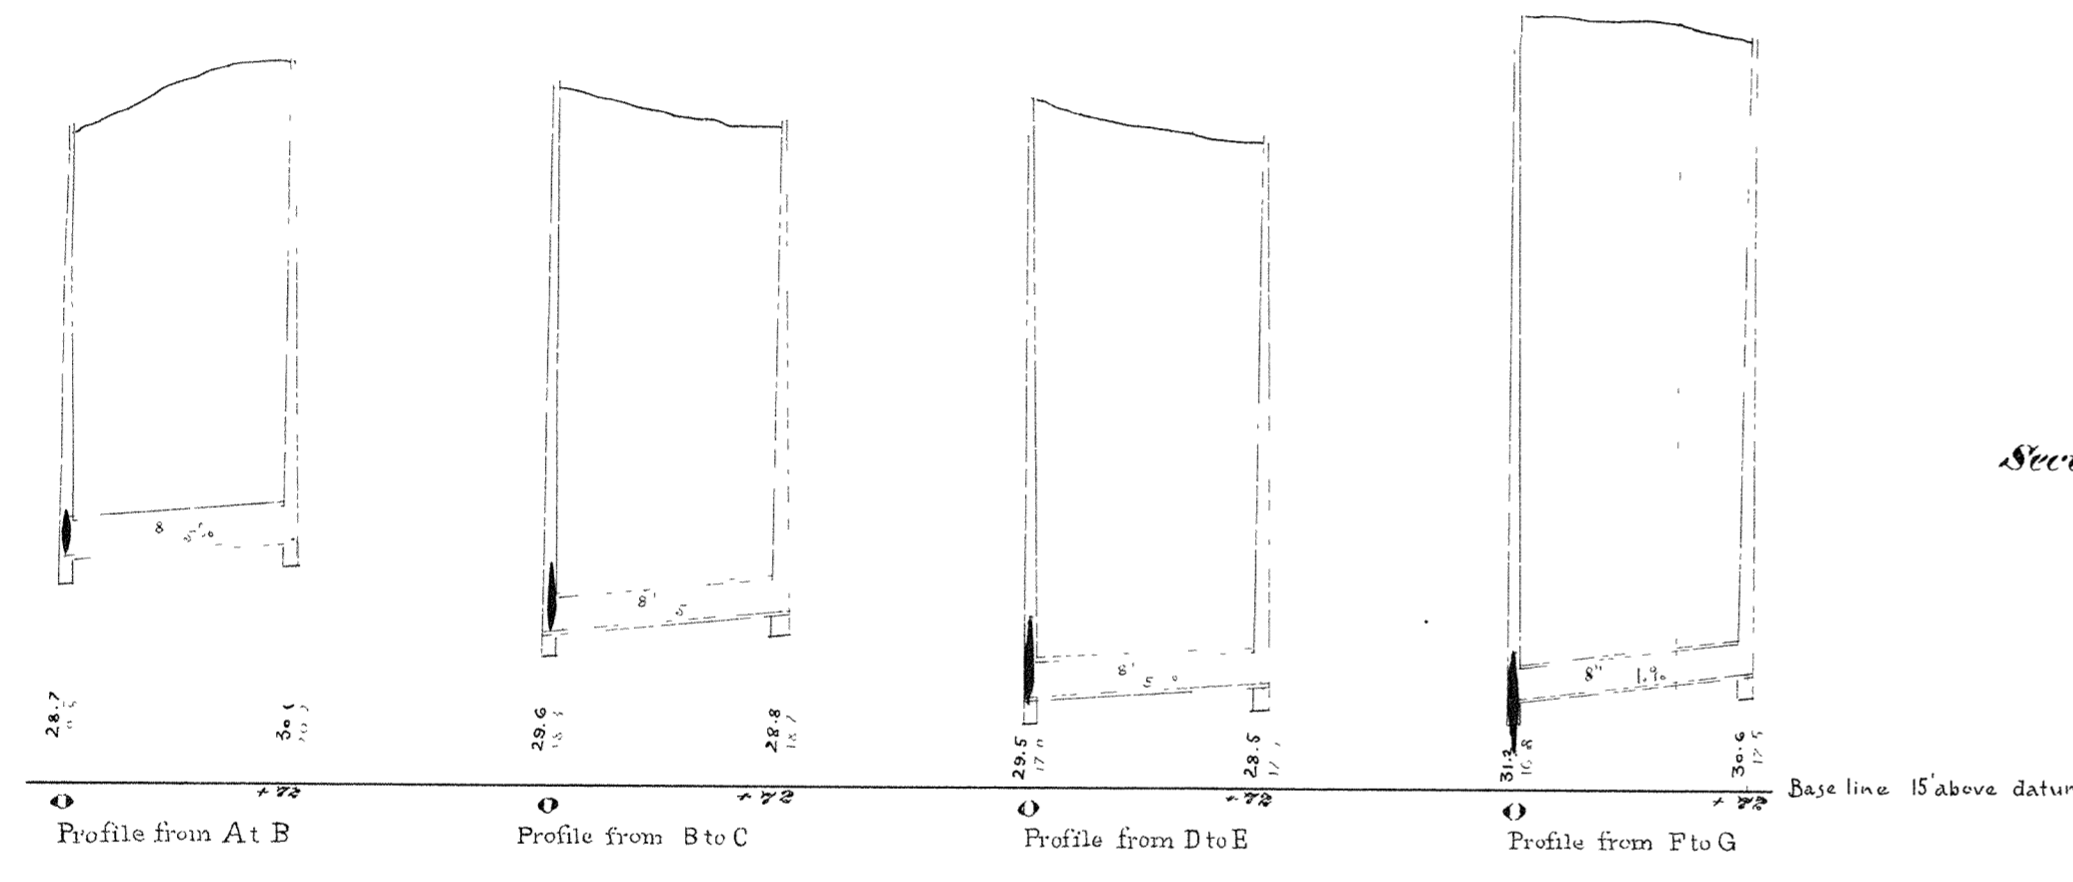

CITY OF SUPERIOR
SEWER PLAN

Contract let April 3, 1891
completed July 14, 1891
Joseph Wolf Contractor
Finlay McKingie & I. J. Cummins, Inspts.
E. B. Banks, City Engineer

Scale: { Horizontal 60' = 1"
Vertical 4' = 1"
Section 4' = 1"

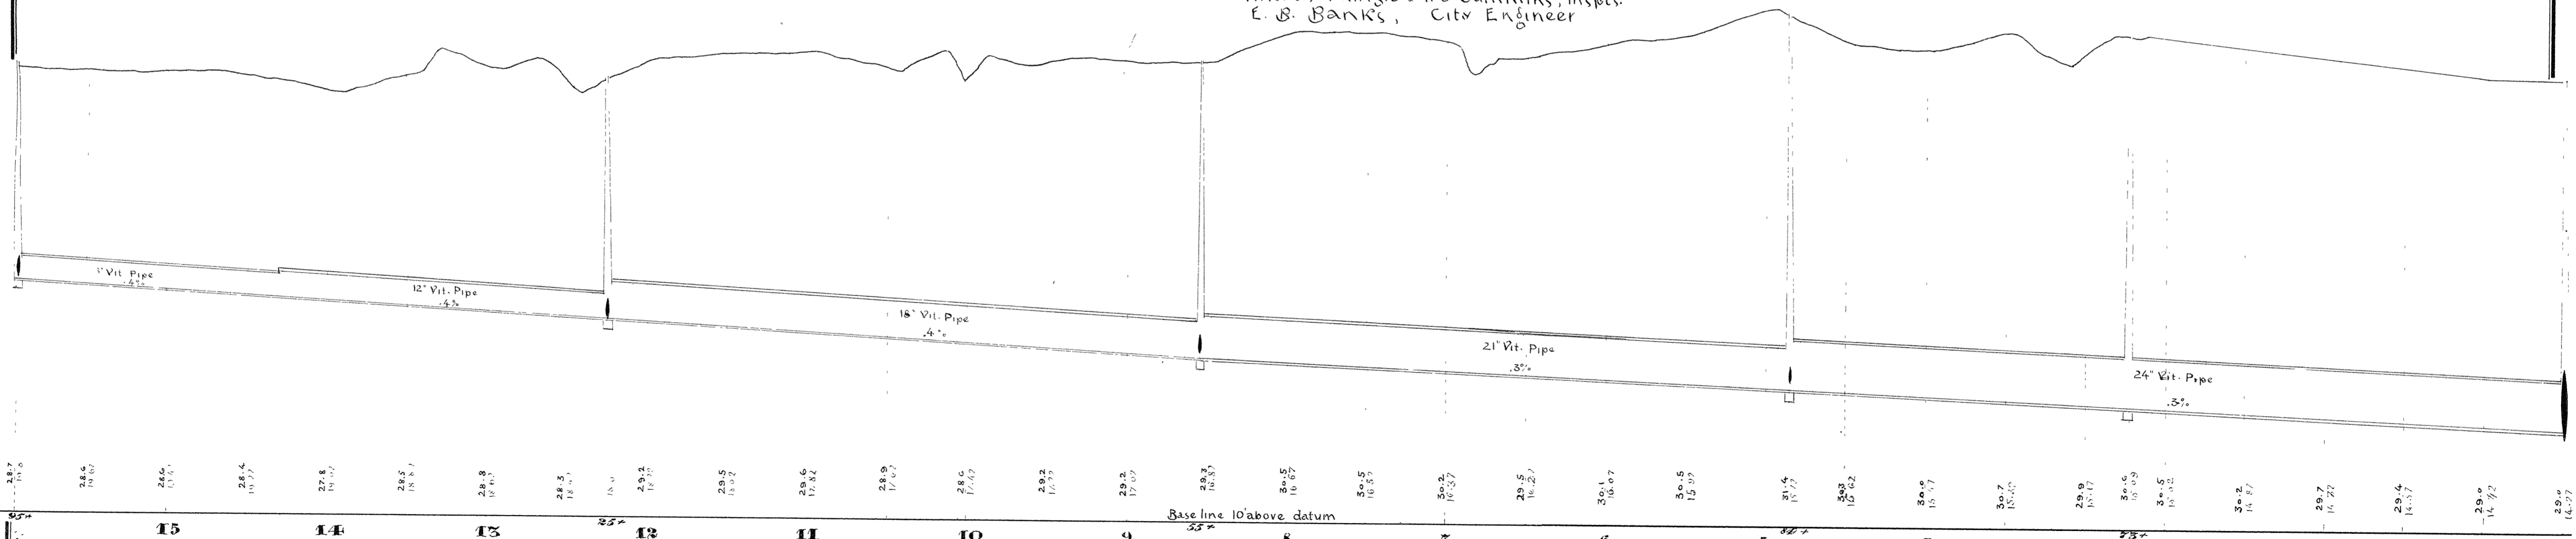

Plan & Profile of Sewer in Alley South of Broadway from Hammond to Tower Ave.

2B-51