



**CITY OF SUPERIOR**  
**SEWER PLAN**  
 Contract let May 30, 1892  
 " completed Nov. 10, 1892  
 Kirkland & Starke, Contractor  
 John Extrom, Inspector  
 E. B. Banks, City Engr.

1893

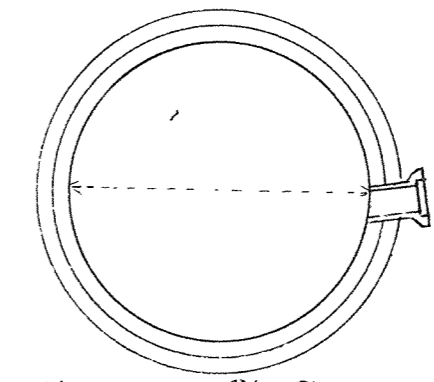

Scale: - { Horizontal 1" = 60'  
 Vertical 1" = 4'  
 Section 1" = 4'

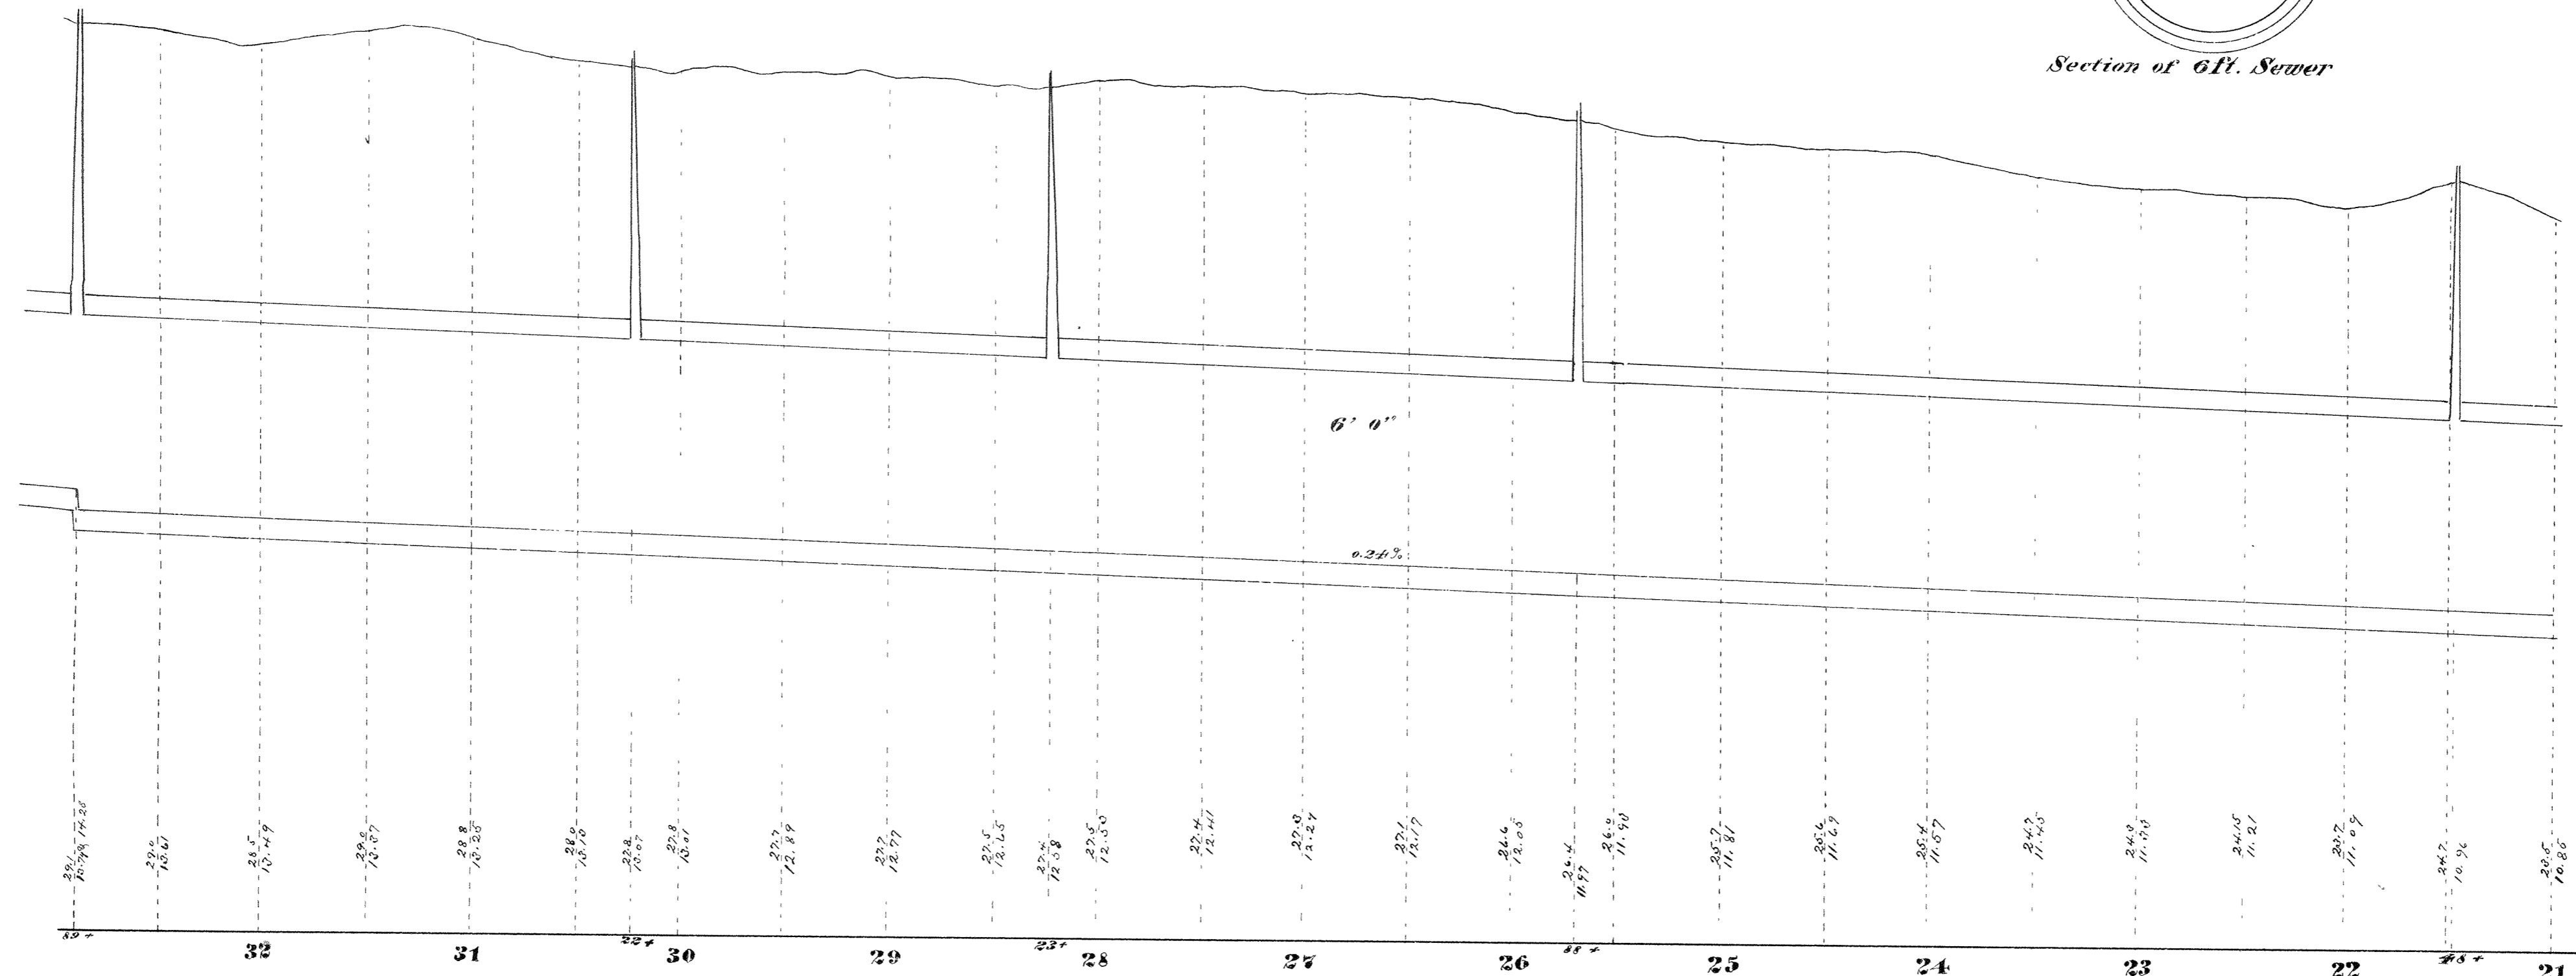

Plan & Profile of Sewer in Alley betw. Cypress and Birch Ave. from 13<sup>th</sup> St. to Alley So. Belknap

2B-54