



CITY OF SUPERIOR


SEWER PLAN

Contract let May 26, 1890
 completed July 1, 1891
 Kirkland & Clarke, Contractor
 Earnshaw & Stevenson, Inspectors
 E. B. Banks, Civil Engineer


Note: - Connections, left out, are not reported

Scale { Horizontal 1 inch = 60 ft.
 Vertical 1 " = 4 "
 Section 1 " = 2 "


1892

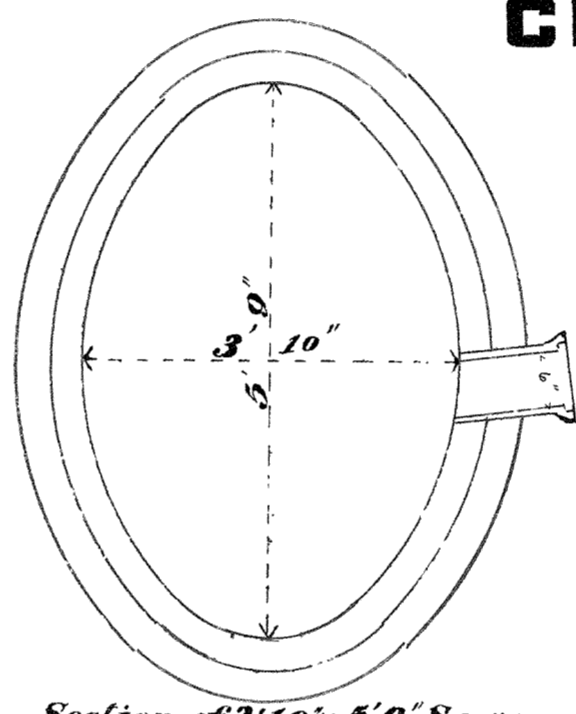

Section of 3'10" x 5'0" Sewer

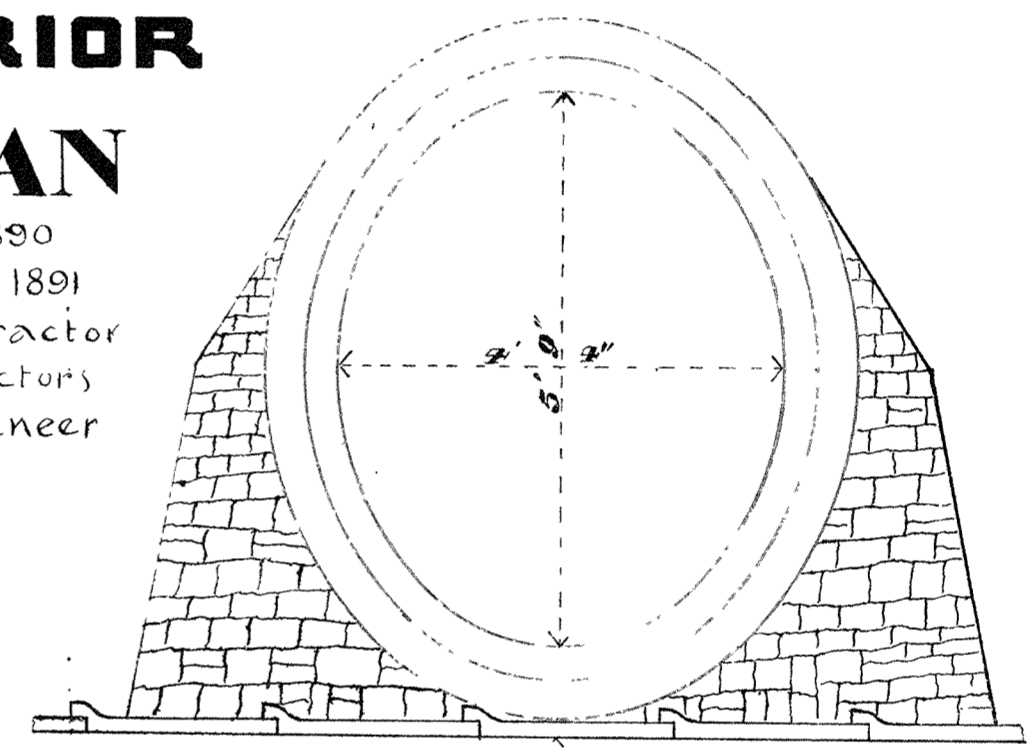

Section of 4'4" x 5'0" Sewer

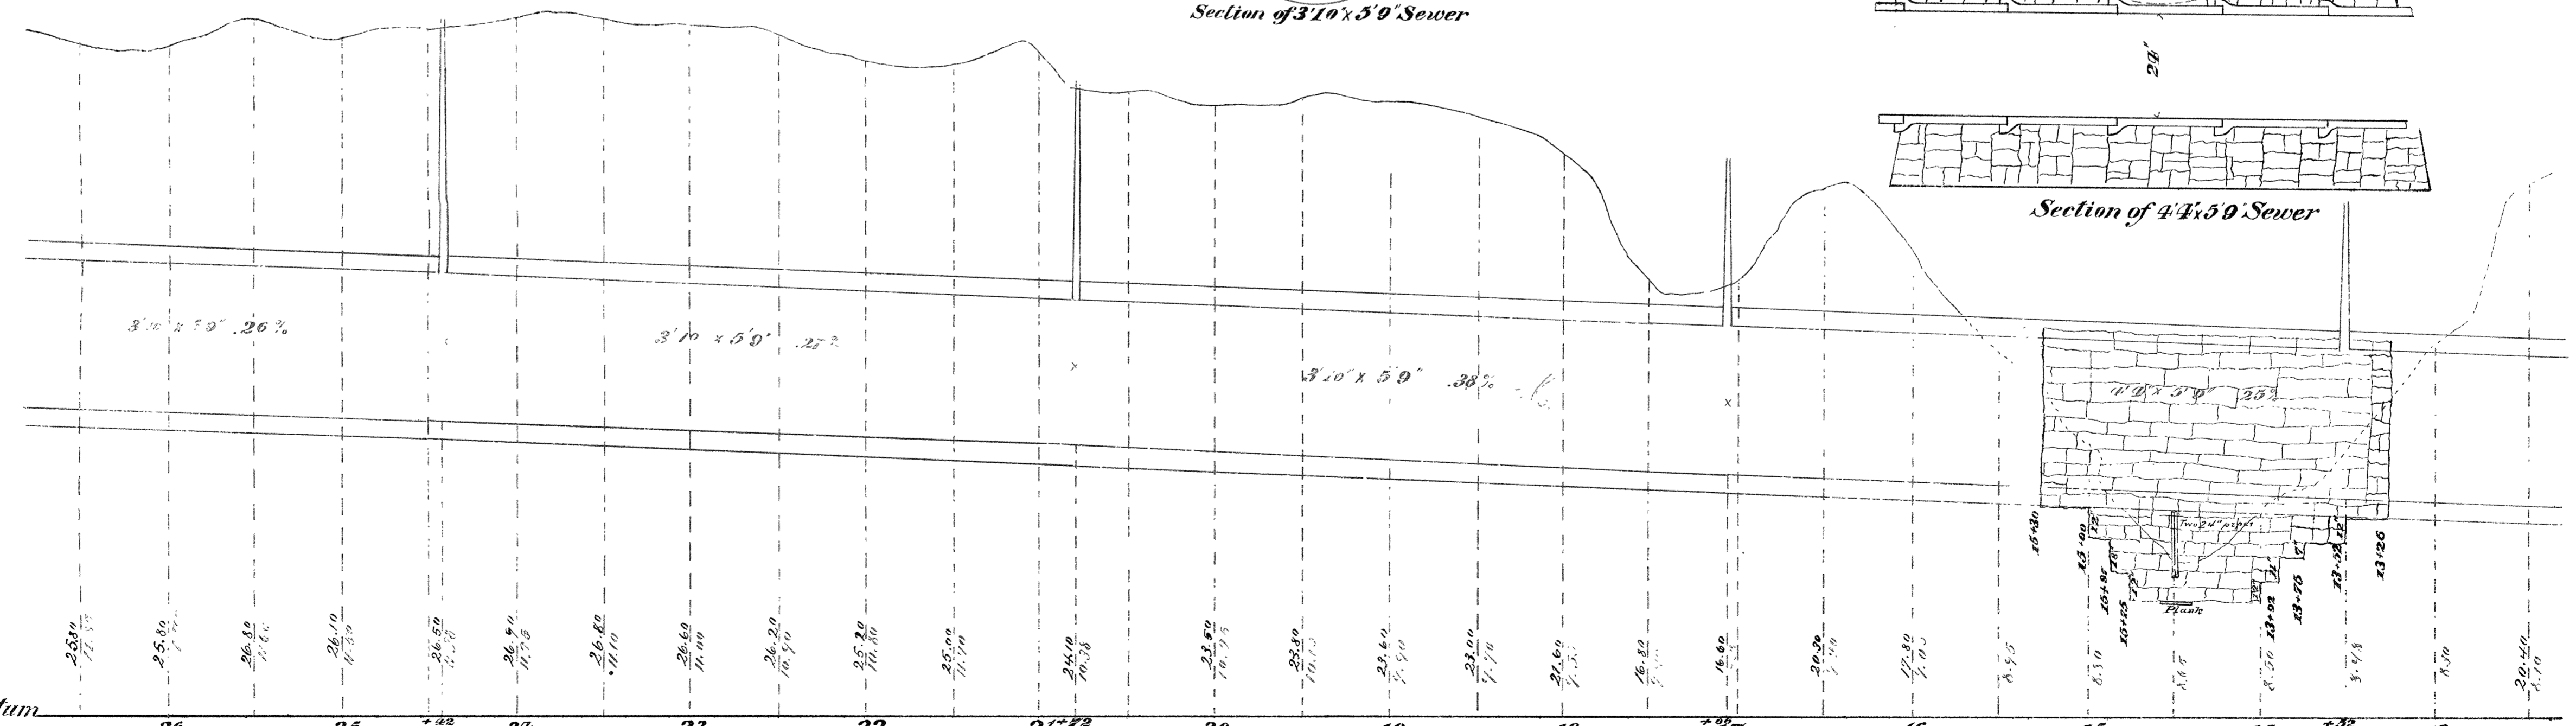

City datum

Profile of Sewer in Alley south of Broadway from Birch Ave. to Weeks Ave.

2B-56