





### CITY OF SUPERIOR

### SEWER PLAN

Contract let Aug. 6, 1892  
 " Completed Oct. 1, 1892  
 Wolf & King, Contractor  
 W. G. Coleman, Inspector  
 A. S. Cooper, City Engineer

1892

Scale: { Horizontal 60' = 1"  
 Vertical 4' = 1"  
 Section 4' = 1"

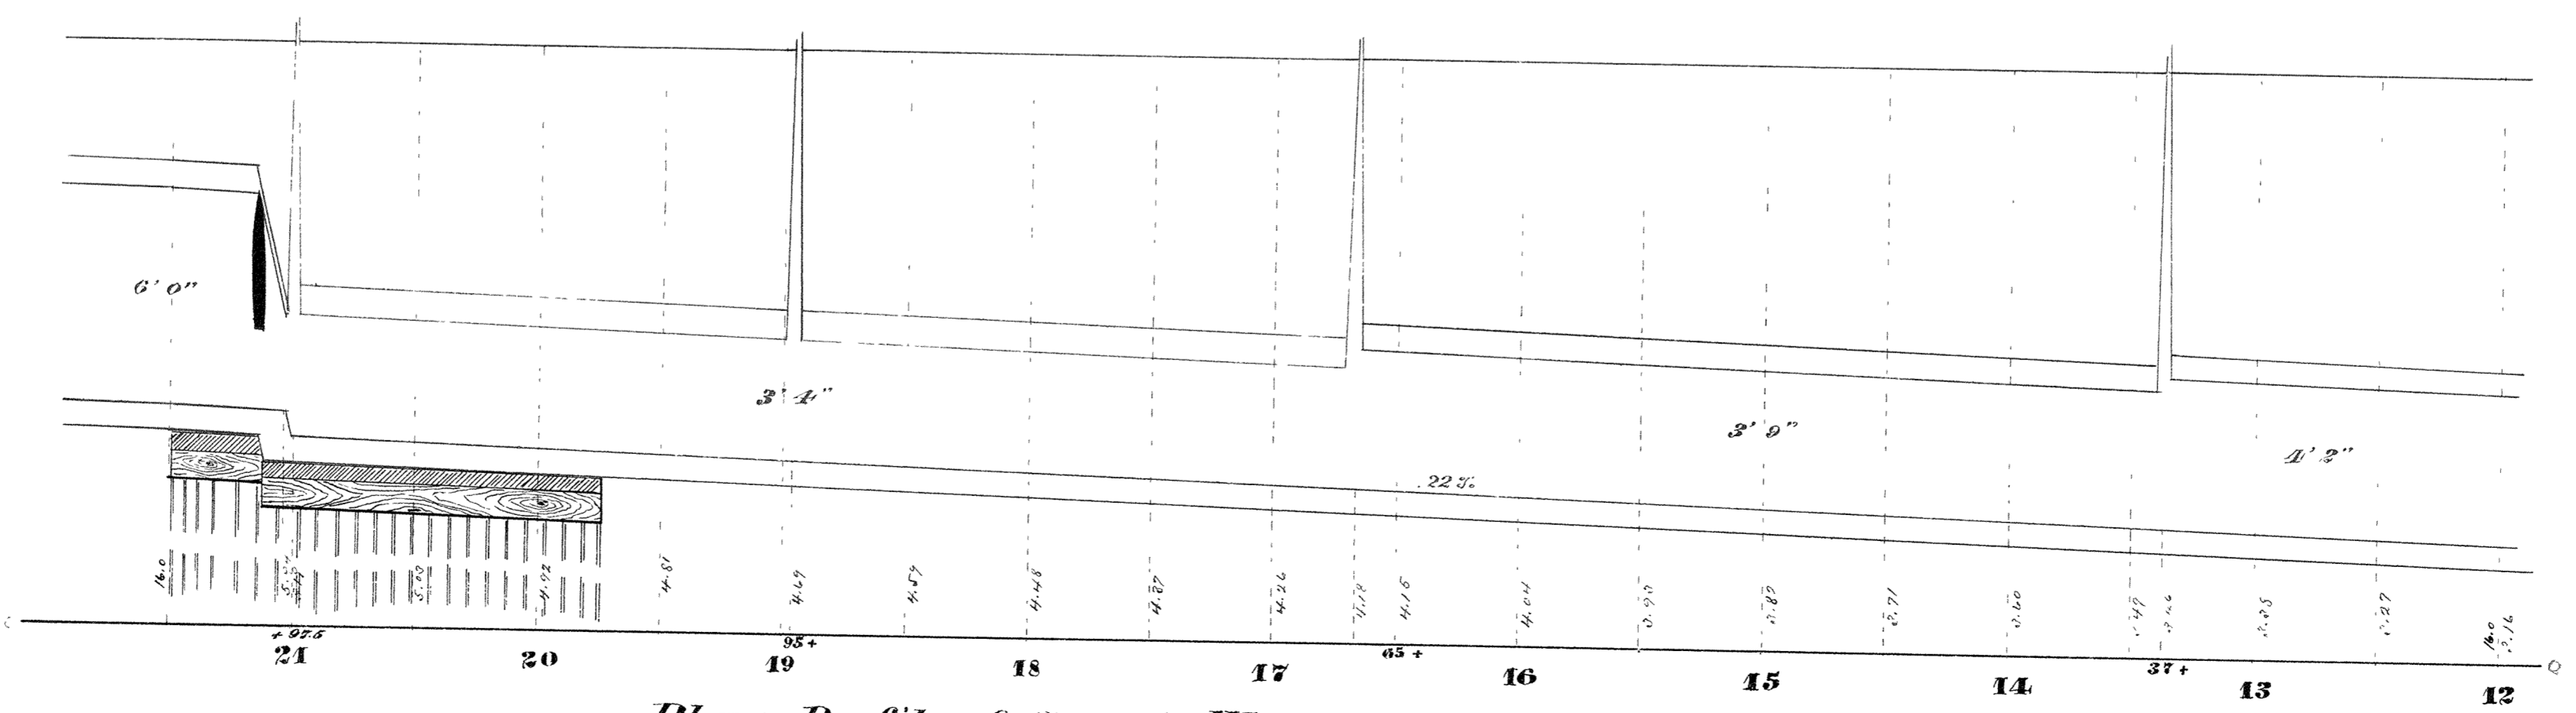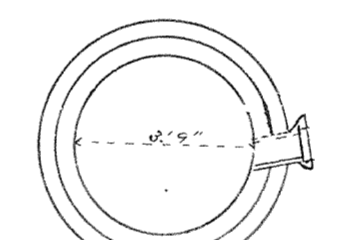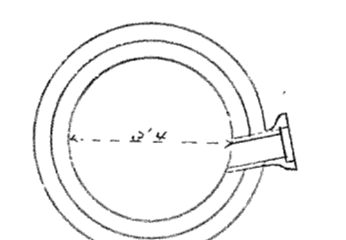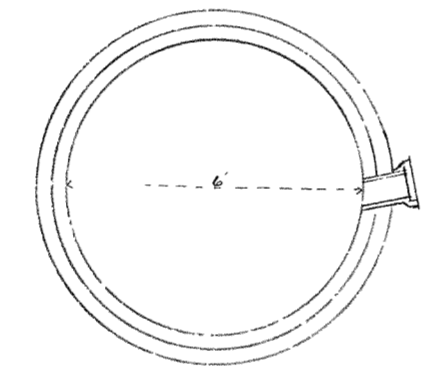

Plan & Profile of Sewer in Winter St. from Elm St. to Poplar Ave.

2B-59