
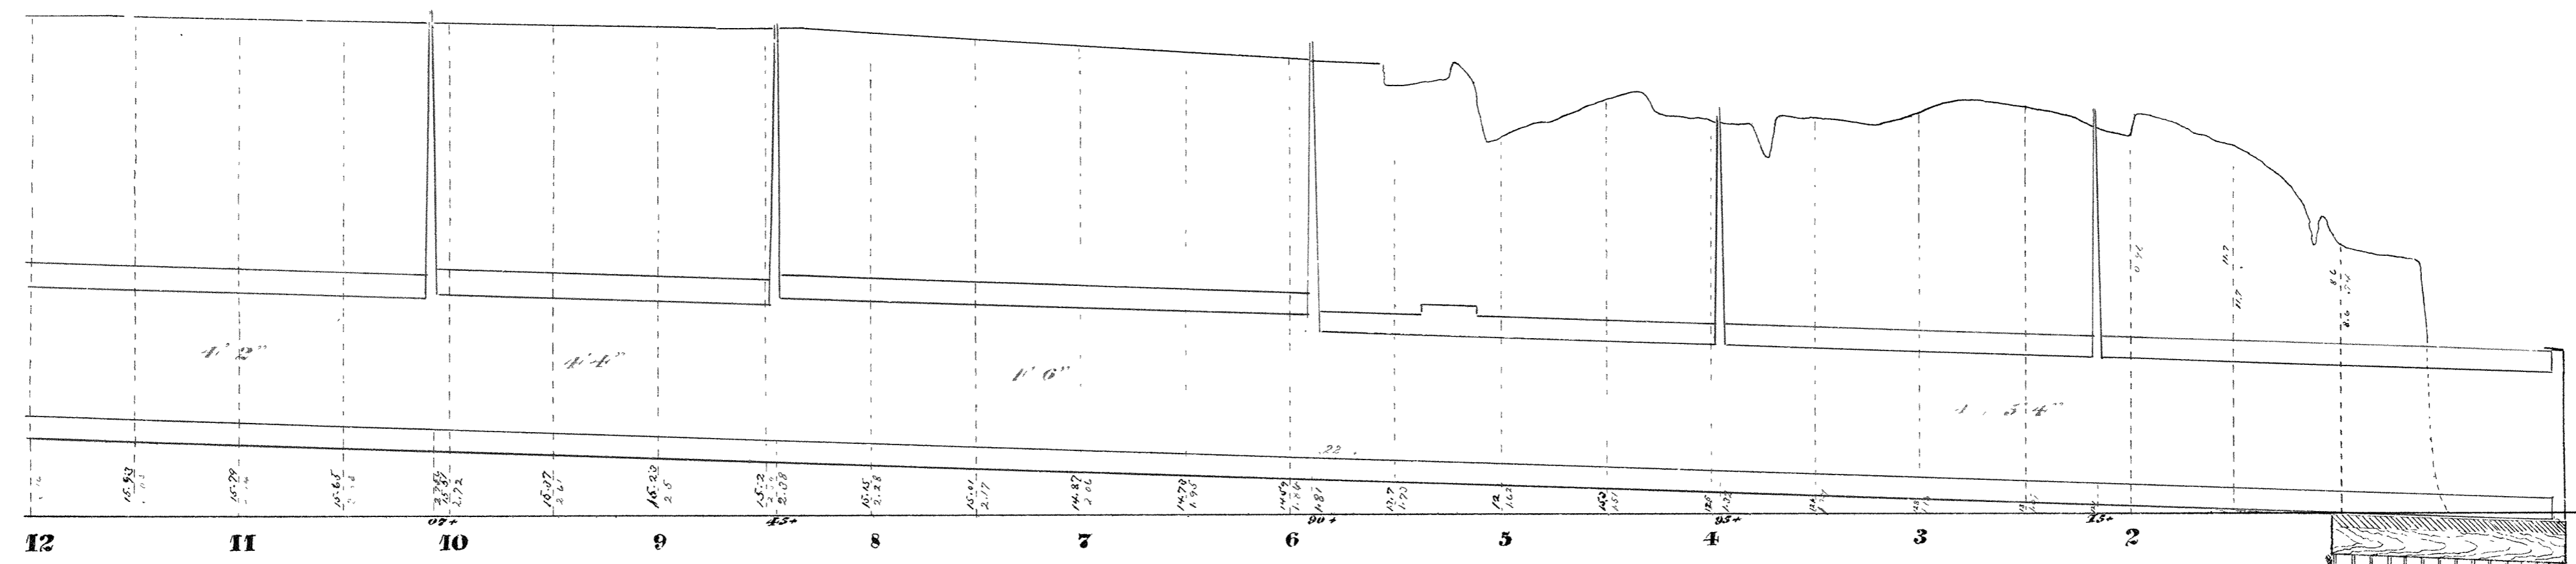
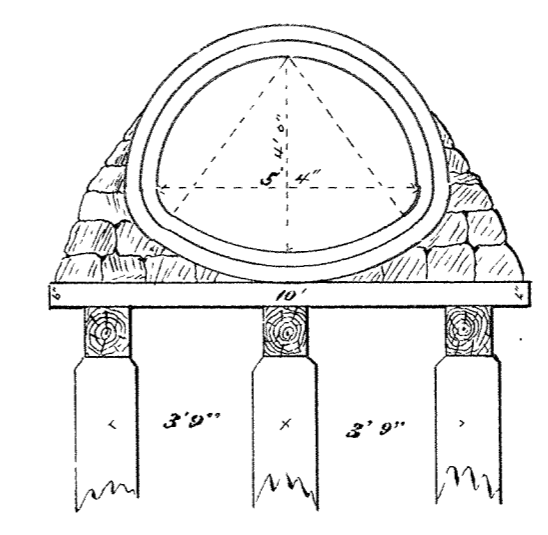
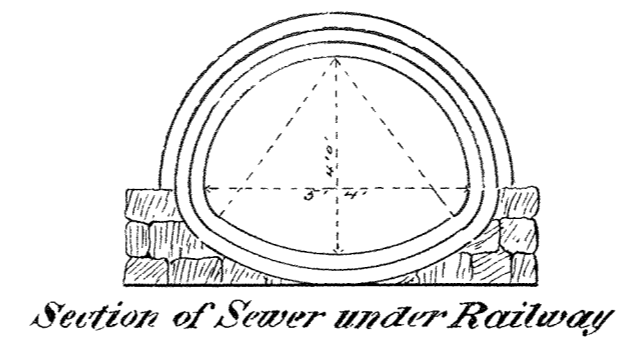
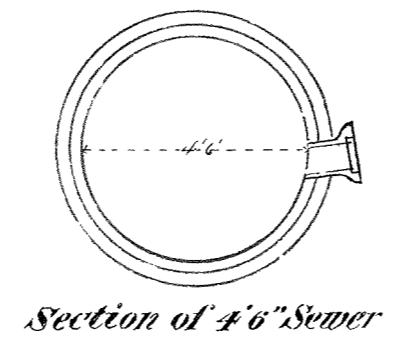
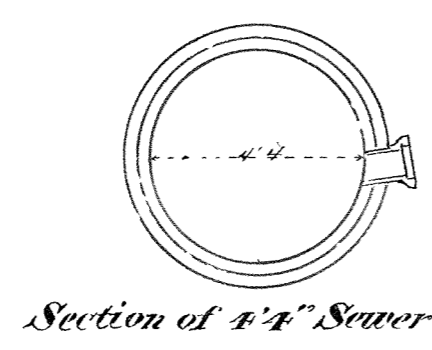


**CITY OF SUPERIOR
SEWER PLAN**

Contract let Aug. 6, 1892
 completed Oct. 1, 1892
 Wolf & King Contractor
 W. G. Coleman, Inspector
 A. S. Cooper, City Engineer

1892

Scale: { Horizontal 60' = 1"
 Vertical 4' = 1"
 Section 4' = 1"

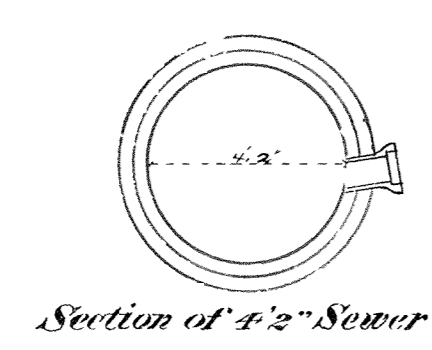

Plan & Profile of Sewer in Winter St. from Bay of Superior to Elm St.

2B-60