



**CITY OF SUPERIOR**  
**SEWER PLAN 1894**

Contract let April 3, 1891  
 " completed July 14, 1891  
 Joseph Wolf, Contractor  
 M. Conroy, Inspector  
 E. B. Banks, City Engineer

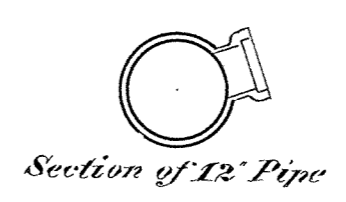

Scale: Horizontal 60' = 1"  
 Vertical 4' = 1"  
 Section 2' = 1"

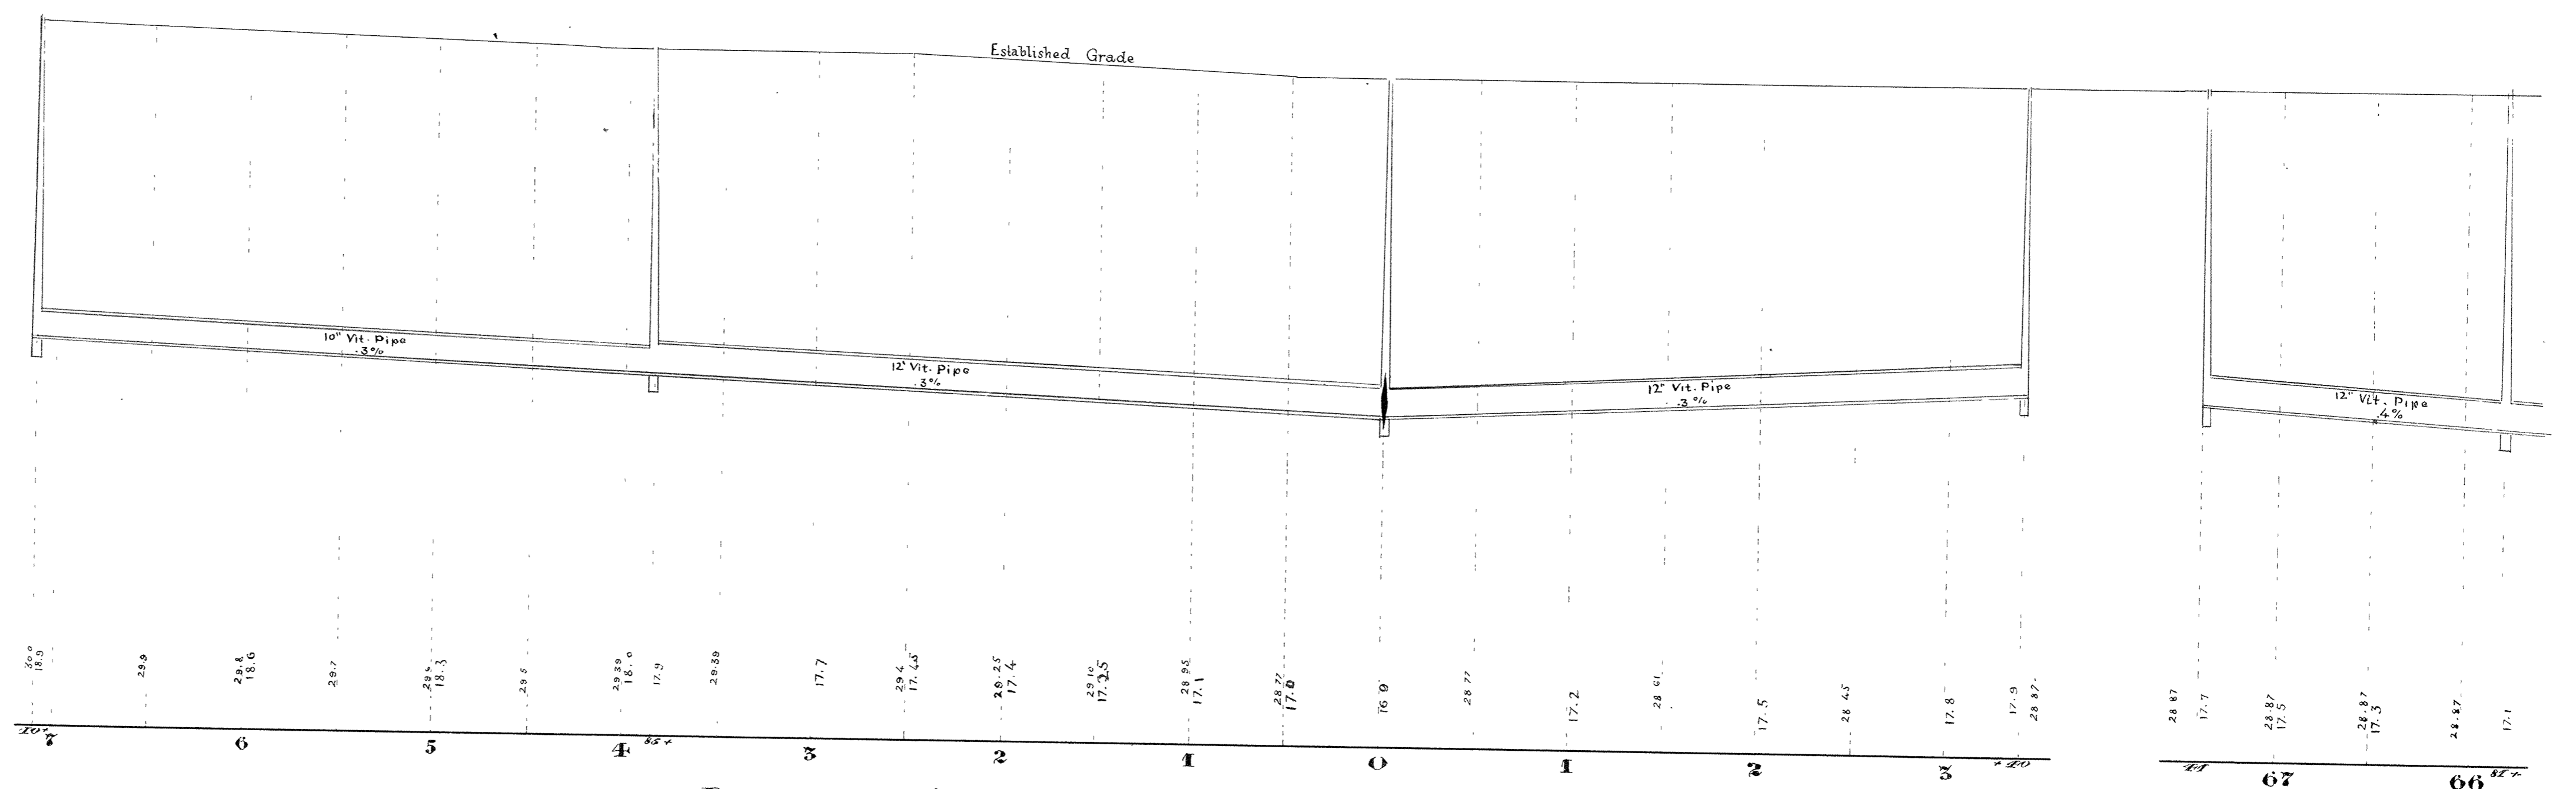

Baseline 5' above datum

*Plan & Profile of Sewer in Winter St. from Ogdren to Oakes Ave.*