

CITY OF SUPERIOR

SEWER PLAN

Contract (180000 to 181000) let Sept. 25 - 1895

James Burke Contractor Dec 20-95

H. H. Smith Inspector

Contract (181000 to 182000) let Nov. 21 1895


Z. M. Powers Contractor Jan 2 1896

F. Russell, Inspector


A. T. Thomas, City Engr.

1896


Scale: { Horizontal 60' = 1'
Vertical 40' = 1'

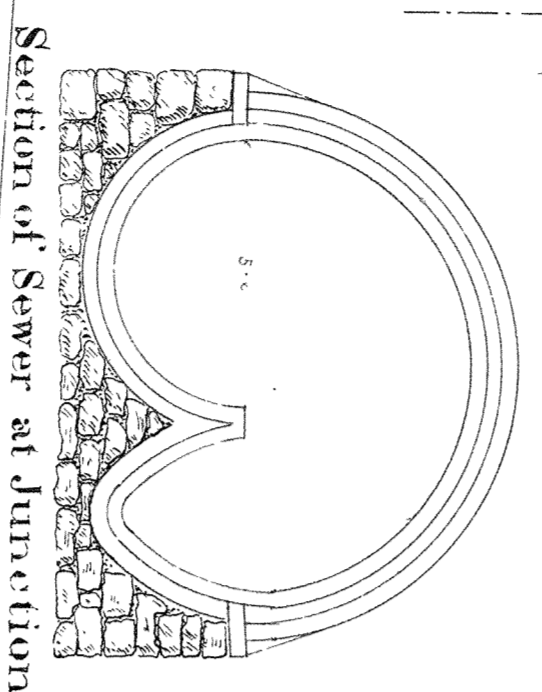



Section of 30" x 4'9" Sewer

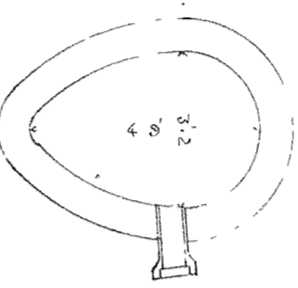

Section of 30" x 4'6" Sewer

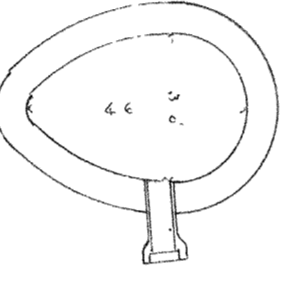

Section of 24" x 4'3" Sewer

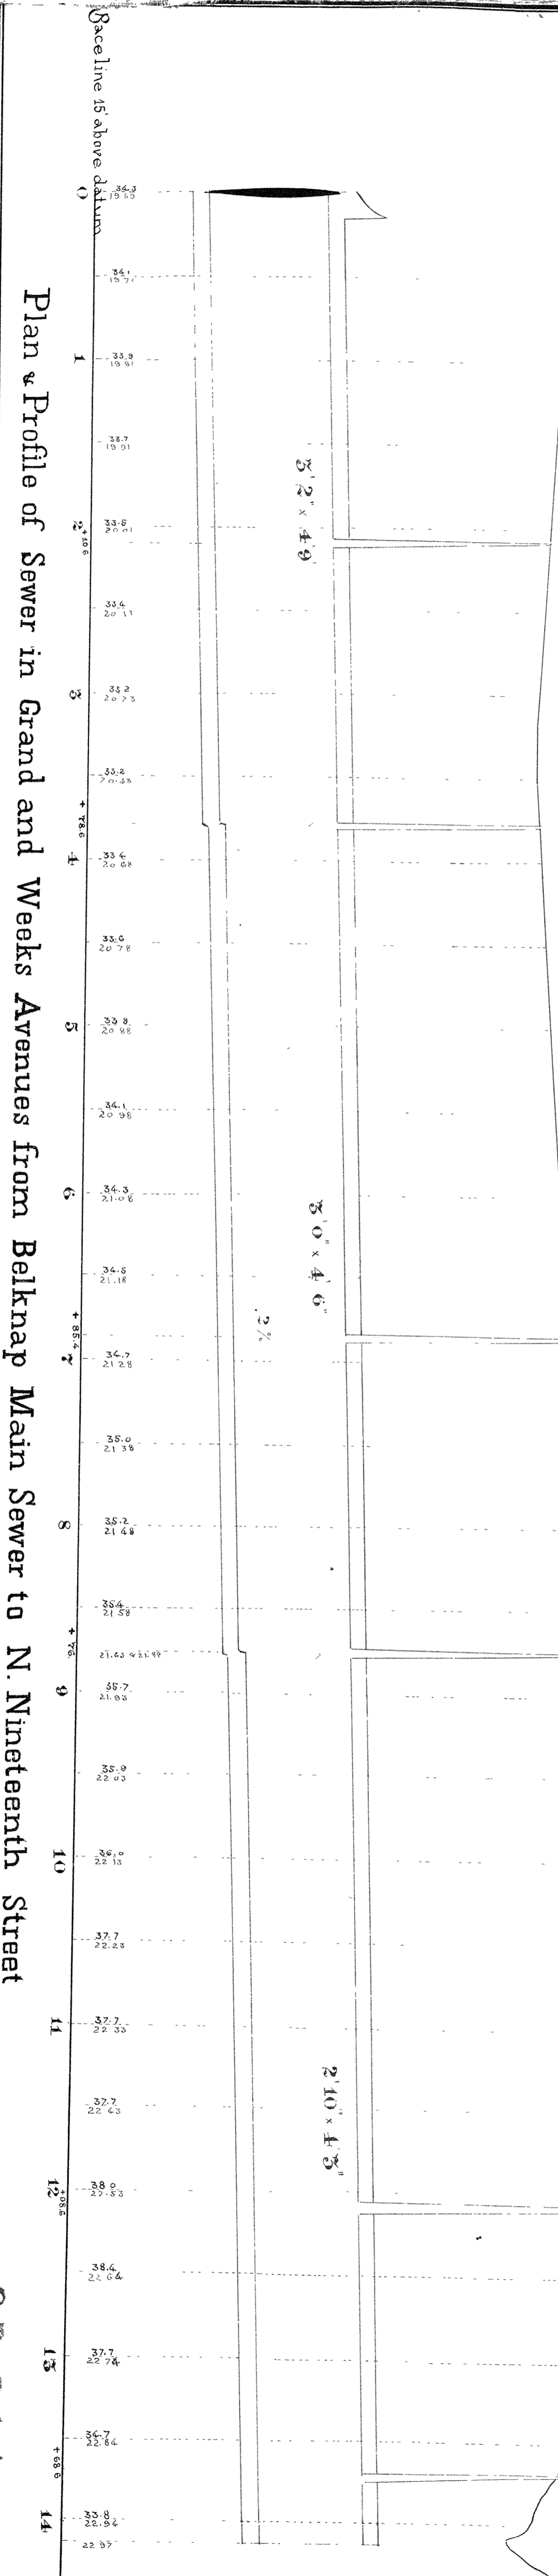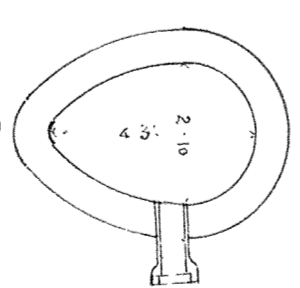

Plan & Profile of Sewer in Grand and Weeks Avenues from Belknap Main Sewer to N. Nineteenth Street

2B-64A