


**CITY OF SUPERIOR,
SEWER PLAN.**

HORIZONTAL SCALE: 1 IN. = 60 FT.
VERTICAL SCALE: 1 IN. = 4 FT.

CONTRACT NO 1116
Contract let..... August 26, '08.
Contract completed..... October 14, '08.
Peterson & Holm..... Contractors.
Andrew Solin..... Inspector.
E. B. Banks..... City Engineer.

CONTRACT NO 1431
Contract let..... July 8-14.
Contract completed..... Sept. 10-14.
Jacobsen & Co..... Contractors.
J. B. Graham..... Inspector.
E. B. Banks..... City Engineer.

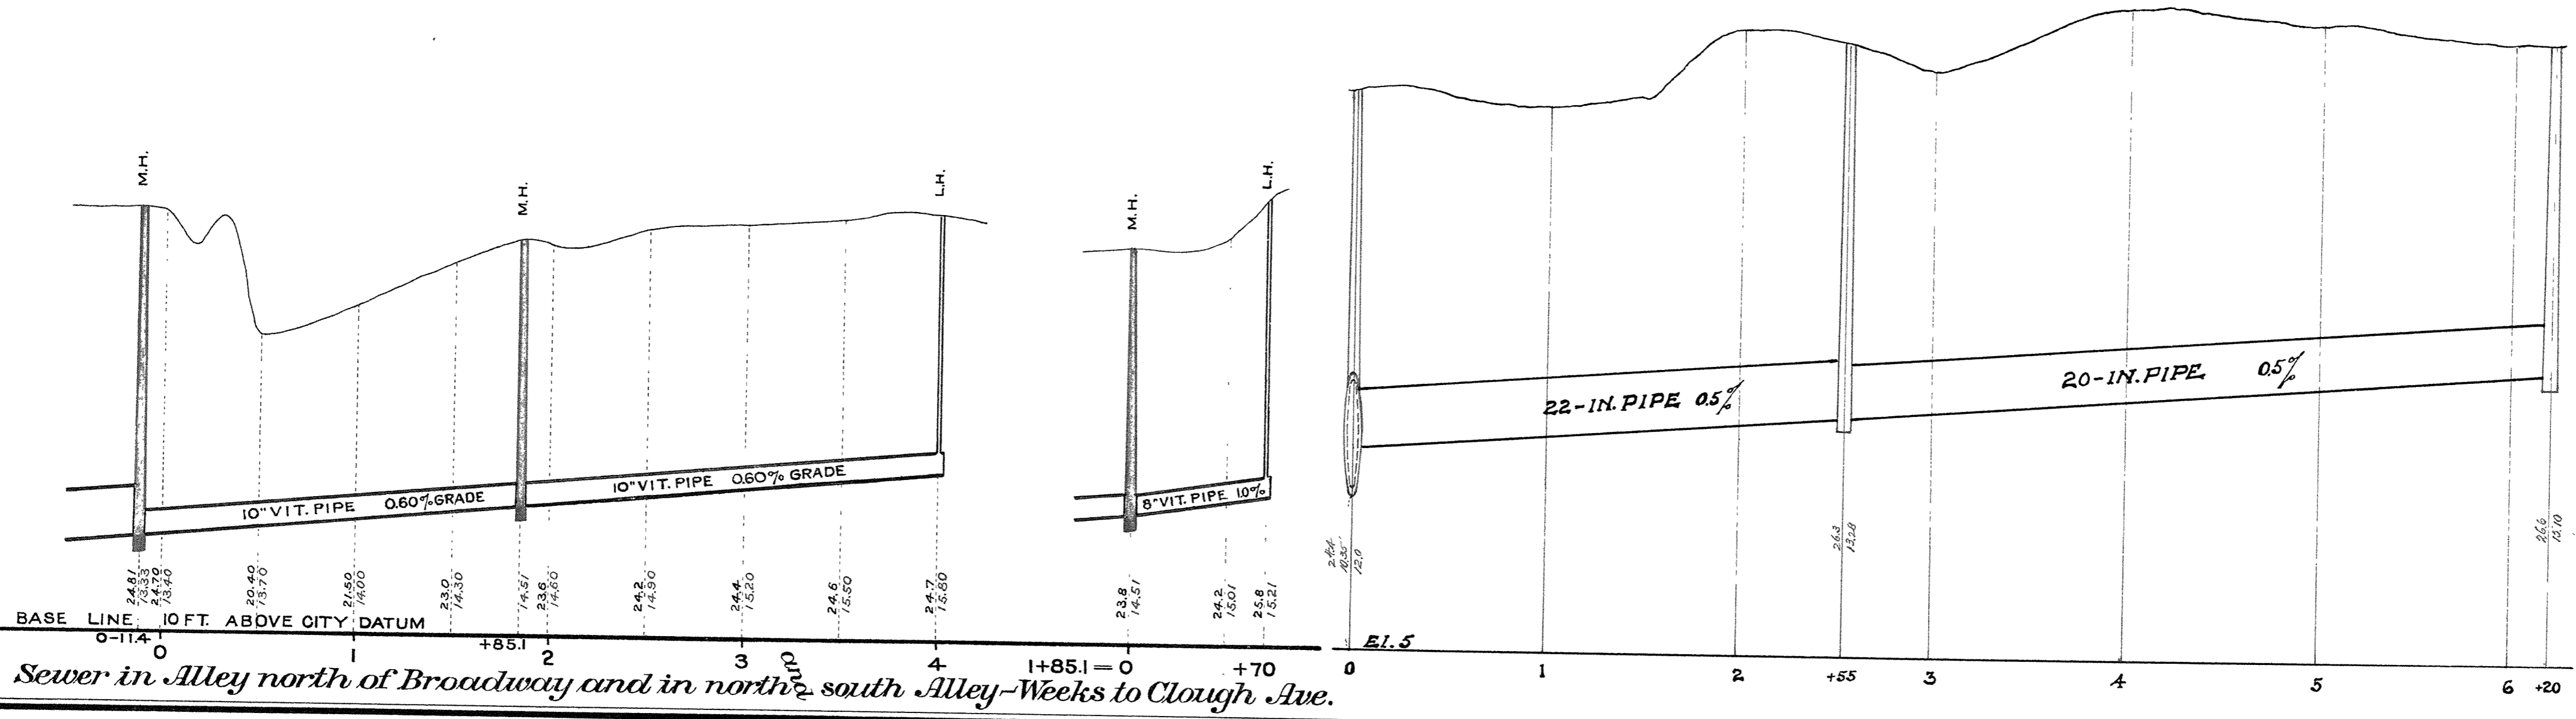

2 B-69