



### CITY OF SUPERIOR SEWER PLAN.

Horizontal Scale: 1 inch = 60 feet.  
Vertical Scale: 1 inch = 4 feet.

CONTRACT NO 1293  
 Contract let..... July 13, 1911.  
 Contract completed..... Oct. 18, 1911.  
 John Anderson..... Contractor.  
 J. B. Graham..... Inspector.  
 E. B. Banks..... City Engineer.

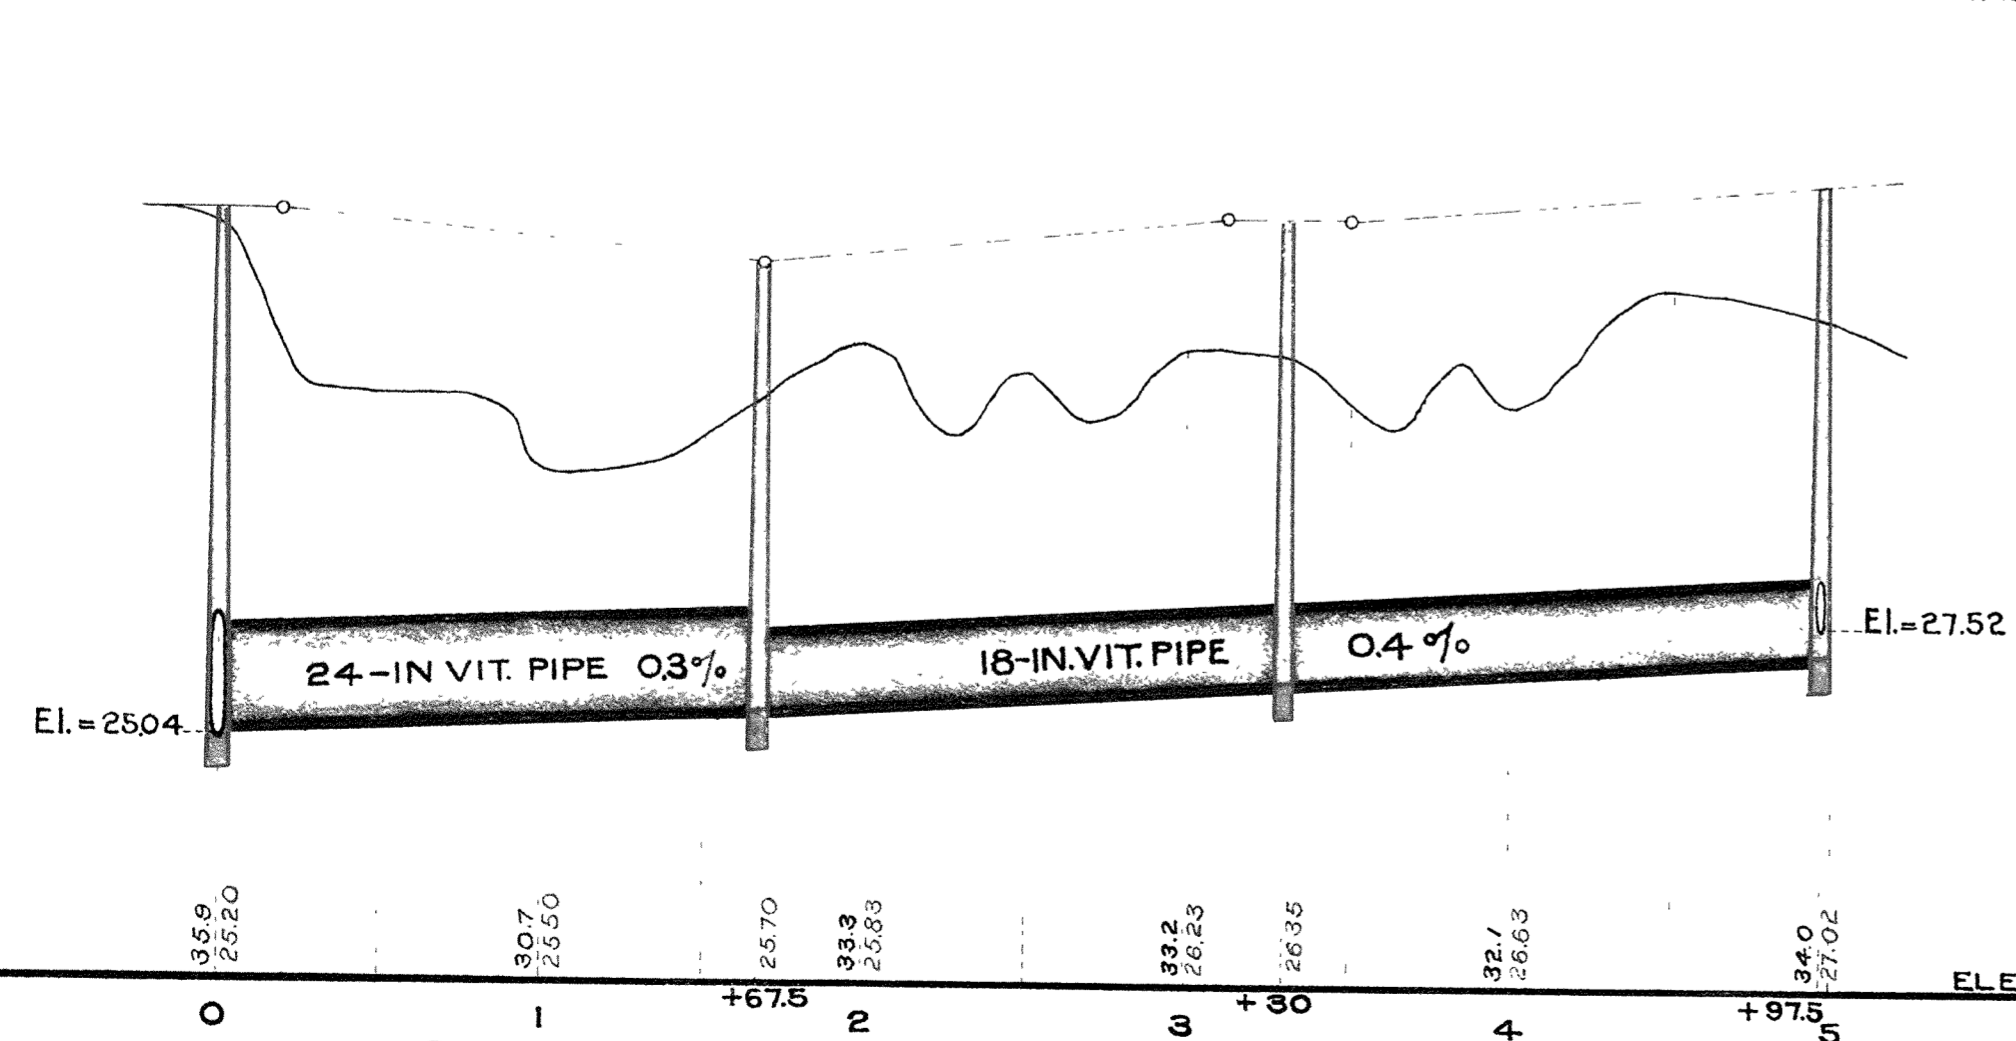

Sewer in Lamborn Avenue.

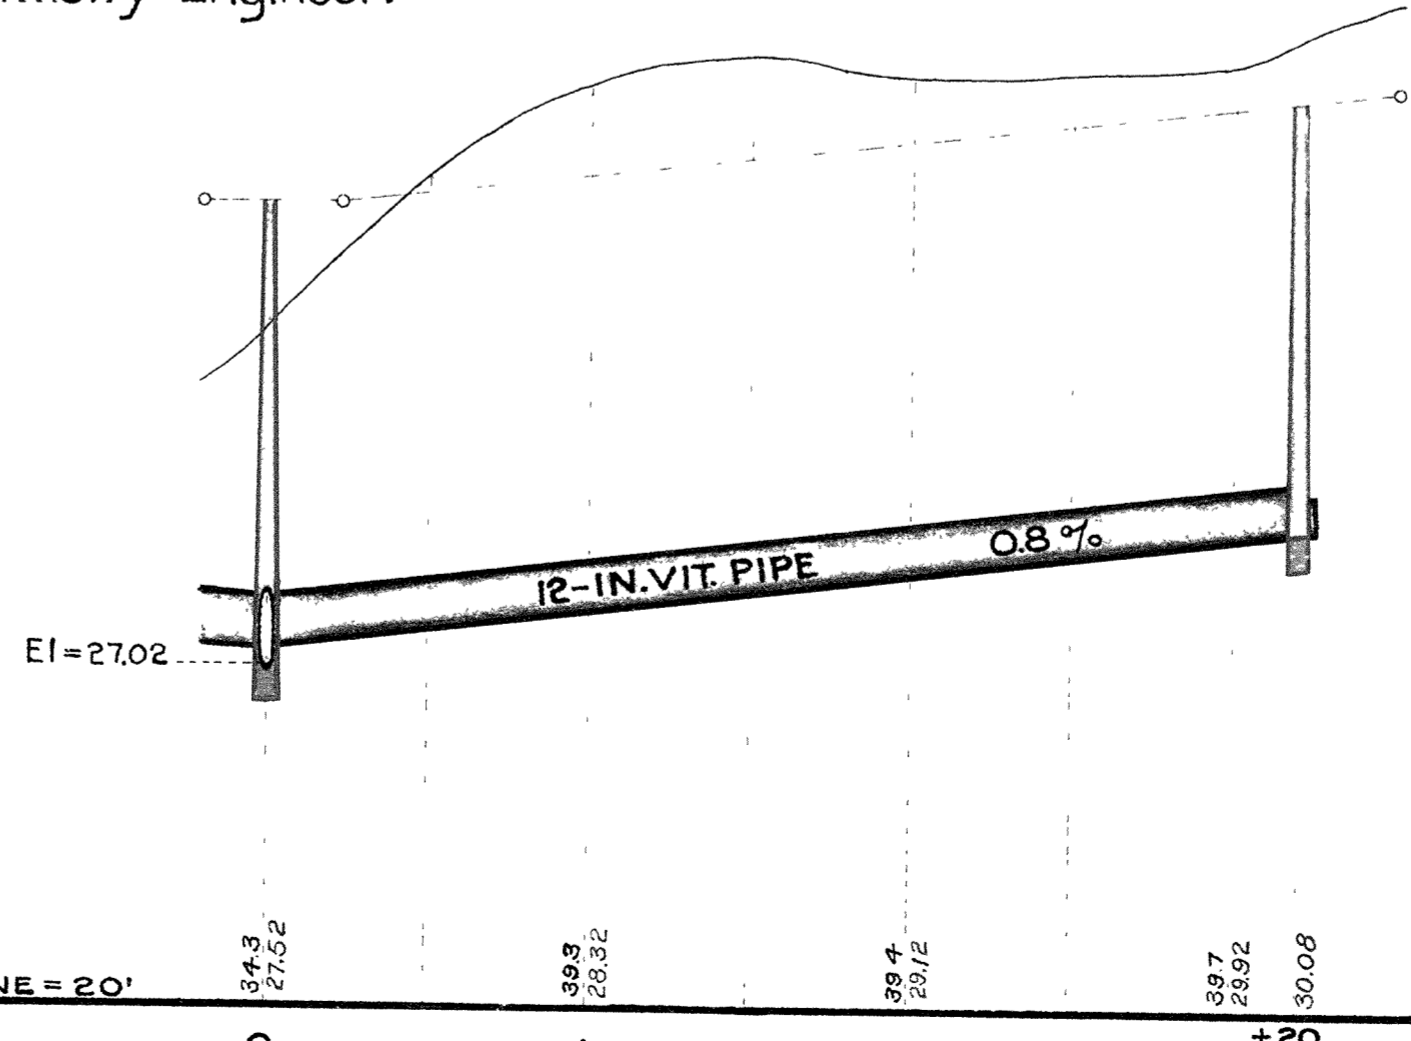

Sewer in Alley between Lincoln and N. 21st. St.

2B-71