

W.P. NO. 9540 JAN. 1940
STORM WATER SEWER 14TH ST. - NORTH 12TH ST.



STATION	SURFACE EL.	SEWER GRADE	REMARKS
6 + 15.5	618.00	61	STD. END WALL DIS.
6 + 86.9	621.22	613.50 DIS. N.	21" R.C.P. M.H.
6 + 86.9	"	613.56 IN. S.	21" R.C.P.
10 + 78	624.44	615.34 DIS. N.	21" R.C.P. M.H.
10 + 78	"	615.34 IN. S.	18" VIT. T. (LAID IN 1912)
15 + 04.7	627.23	617.77 DIS. N.	18" VIT. T. M.H.

CONTRACT NO 1327
SANITARY IN 13TH ST.

STATION	SURFACE EL.	SEWER GRADE	REMARKS
0 + 02		10" VIT. T. M.H.	(SEE PL. 2B-54 FOR N.A.S.)
3 + 06.91		10" VIT. T. M.H.	SEE M.H. 10+84.30 THIS PL.

WORK PROGRESS ADM. W.P. NO. 9540 CITY OF SUPERIOR
SANITARY EXTENSION & RE-CONNECT'N FROM M.H. 8+41.9 TO M.H. 15+24.20 & SEWER PLAN
STORM WATER SEPARATION FROM END-WALL 6+15.5 TO M.H. 15+04.70-USED HORIZONTAL SCALE 1"=60'
EXISTING 18" PIPE FROM M.H. 10+78 TO M.H. 15+04.70 VERTICAL SCALE 1"=4'

CONTRACT NO. 1327
JOB STARTED JAN. 1940 CONTRACT LET JUNE 17 1912
JOB COMPLETED 1940 CONTRACT COMPLETED AUG. 15 1912
SANITARY ENGINEER H. DANN JOHN ANDERSON CONTRACTOR
CITY ENGINEER L. B. BARTLETT E. B. BANKS INSPECTOR CITY ENGR.

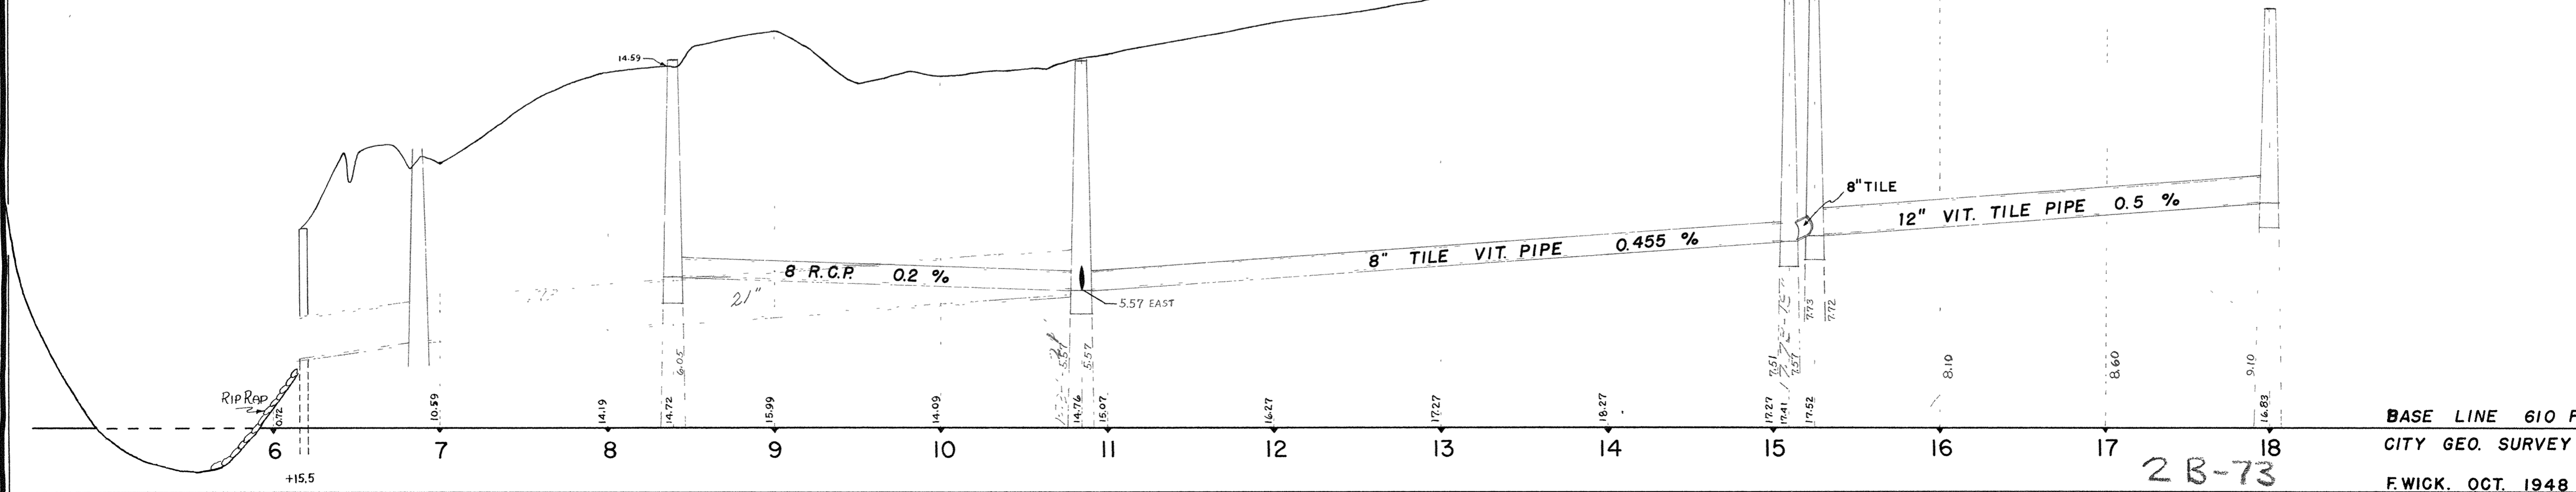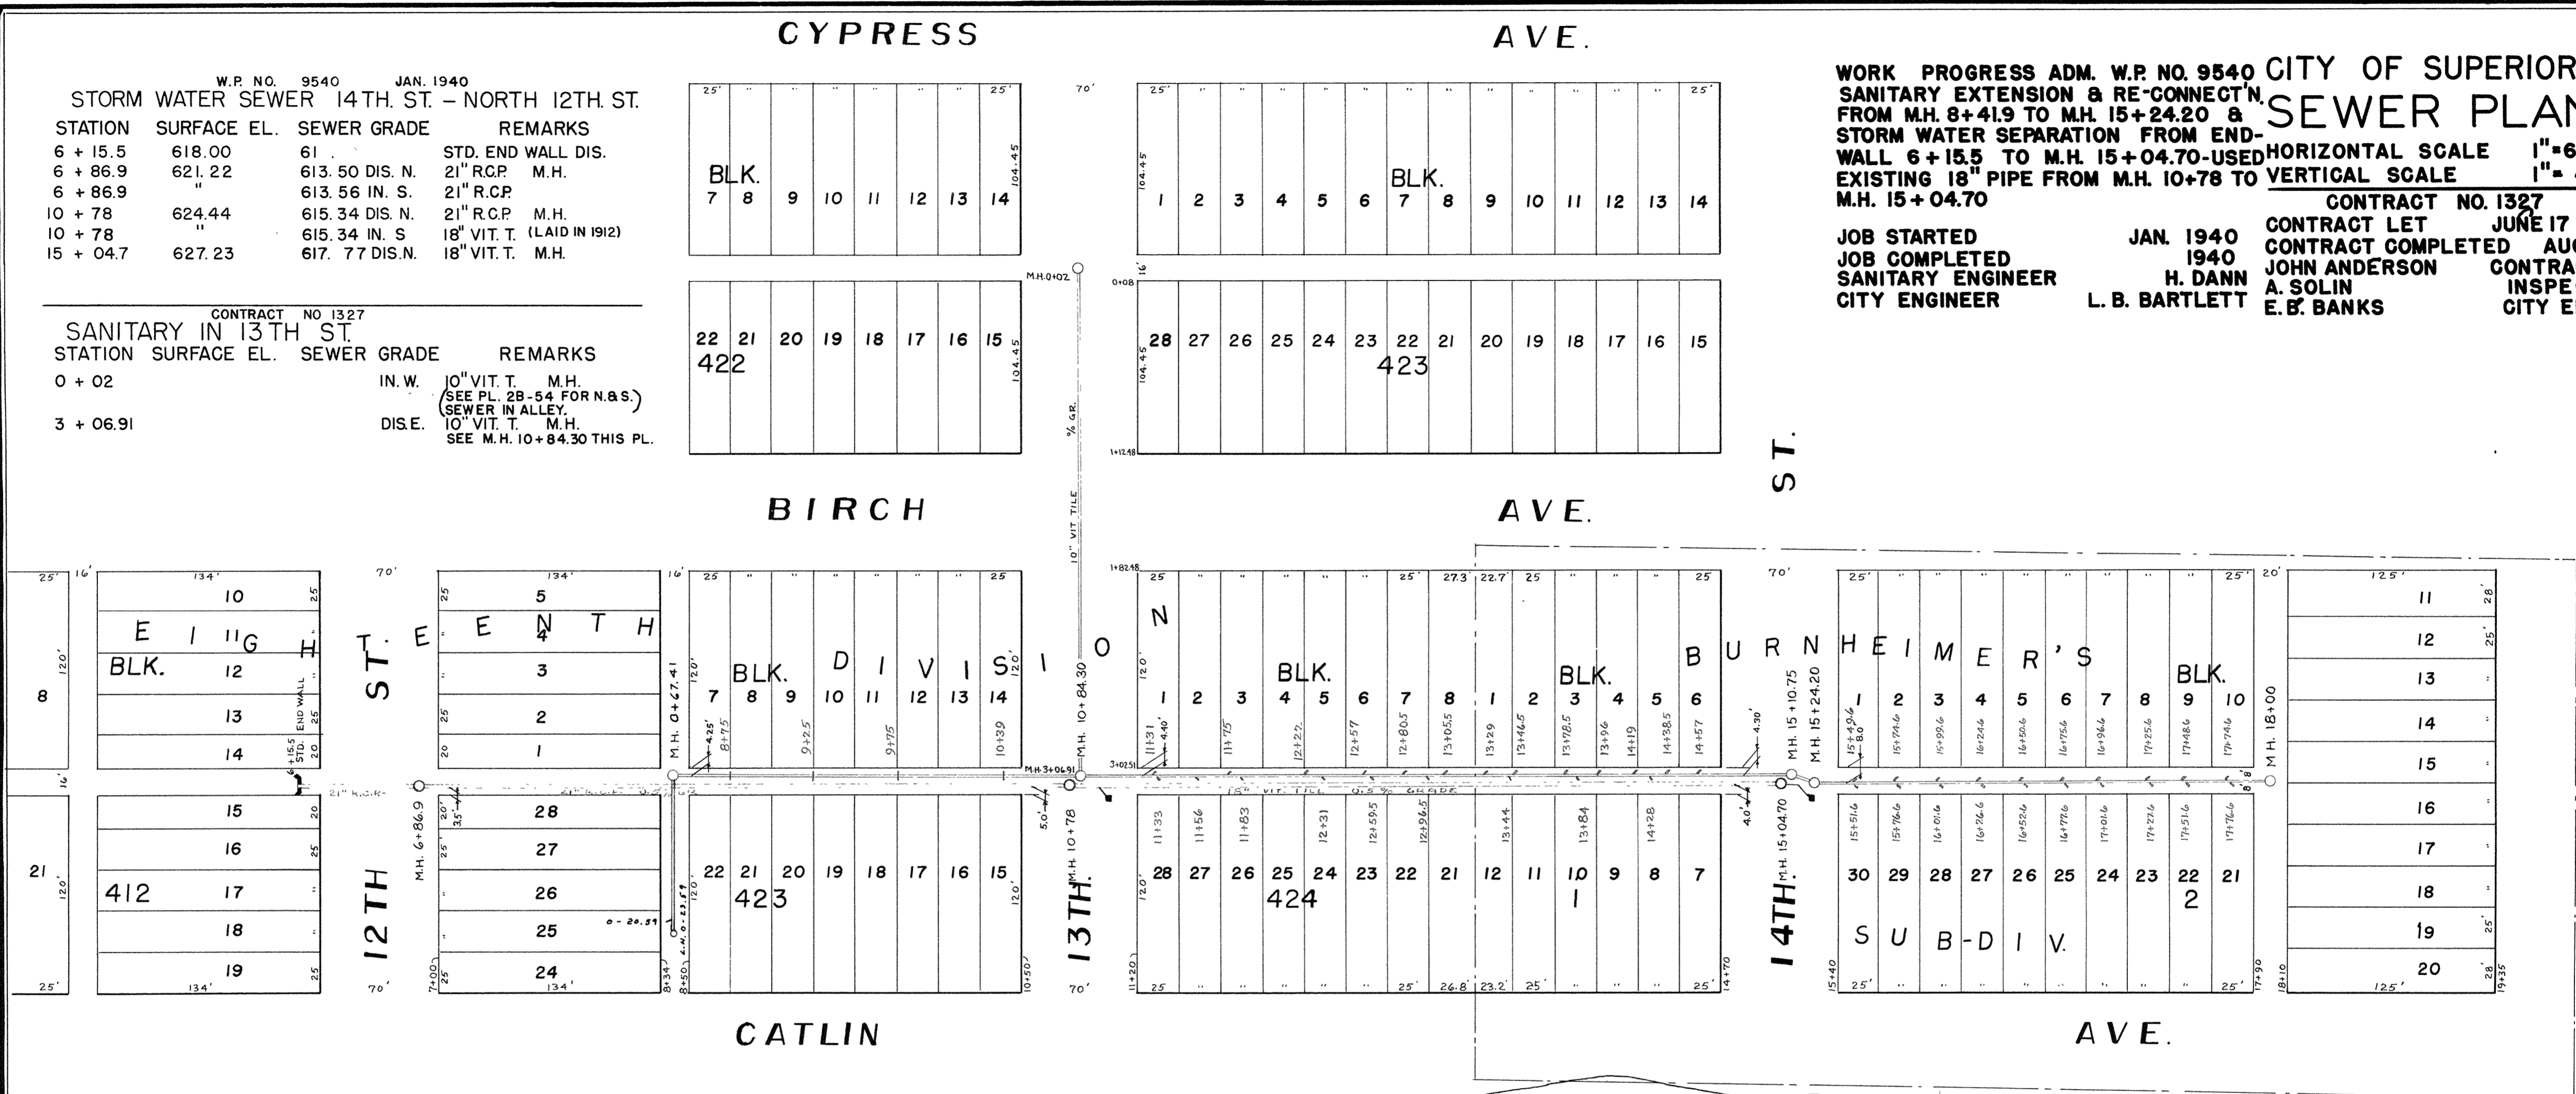

BASE LINE 610 FT.
CITY GEO. SURVEY DATUM
F. WICK, OCT. 1948

2B-73