


**BLOCK No 308**  
 Sewer In Block No. 308 Between  
 Weeks Ave. & Clough Ave. Was  
 Placed By Rene Laque, The Owner,  
 On May 12, 1928.

### CITY OF SUPERIOR SEWER PLAN

Horizontal Scale: lin. = 60ft.  
 Vertical Scale : lin. = 4 ft.

➤ CONTRACT N° 1369 ◀  
 Contract let June 5, 13. Blk. 298  
 Contract completed Dec. 1, 13. ---  
 Russell Const. Co. Contractors Blk. 298  
 J. B. Graham Inspector  
 E. B. Banks City Engineer.

**CONTRACT N° 1777**  
 Contract Let July 3, 1929 - Blk. 309-310  
 Contract Completed Sept. 4<sup>th</sup> 1929.  
 Superior Plumbing & Heating Co. Contractors.  
 Byron Kimball Inspector.  
 E. B. Banks City Engineer.

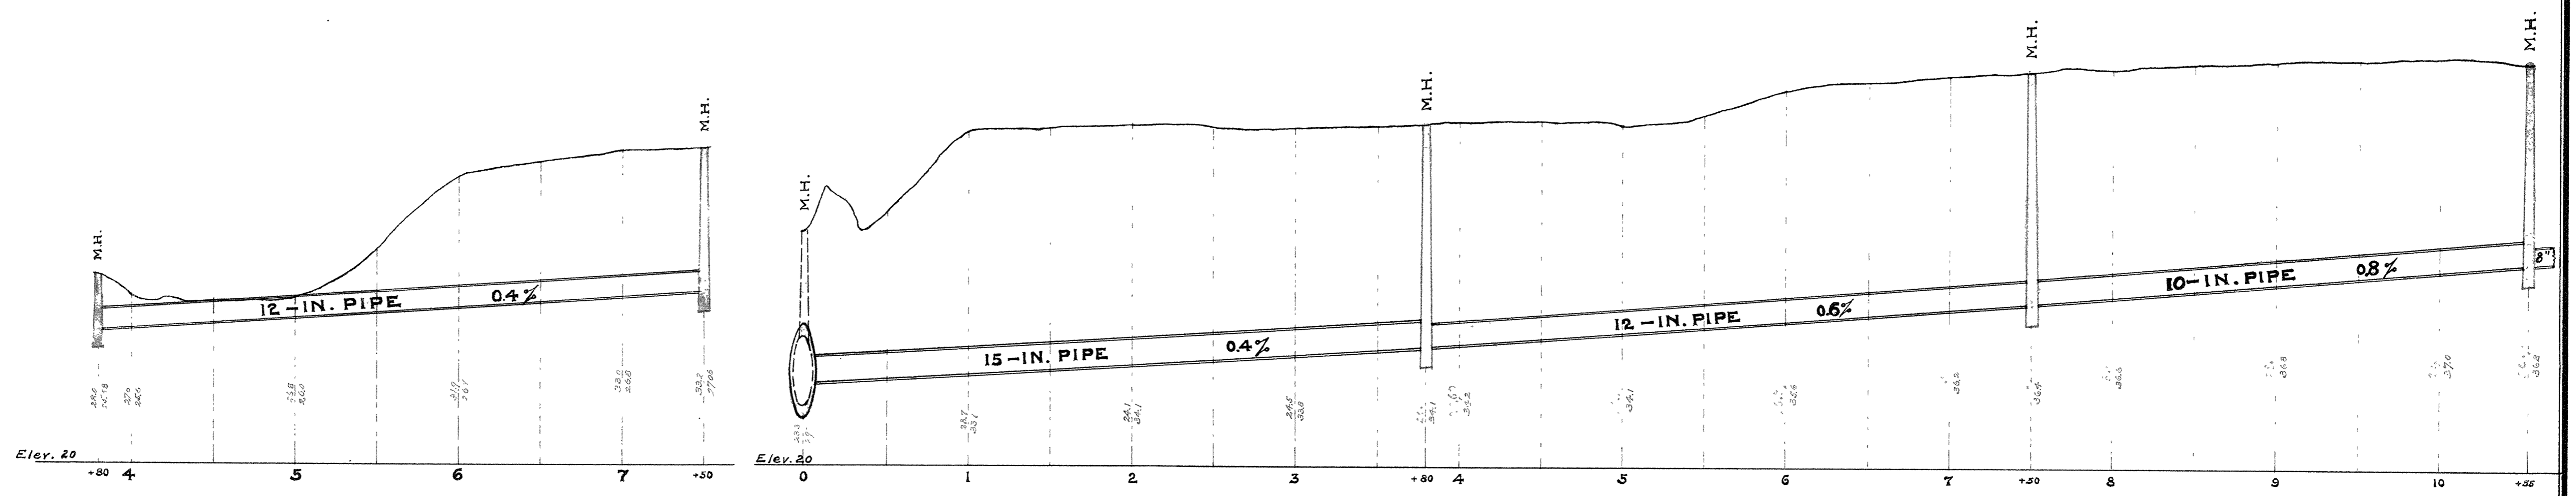

2B-74