


**CITY OF SUPERIOR
SEWER PLAN.**

Horizontal Scale: lin. = 60 ft.
Vertical Scale : lin. = 4 ft.

CONTRACT N^o 1369
Contract let June 5, 13.
Contract completed Dec. 1, 13.
Russell Constr. Co. Contractors
J. B. Graham Inspector.
E. B. Banks City Engineer.

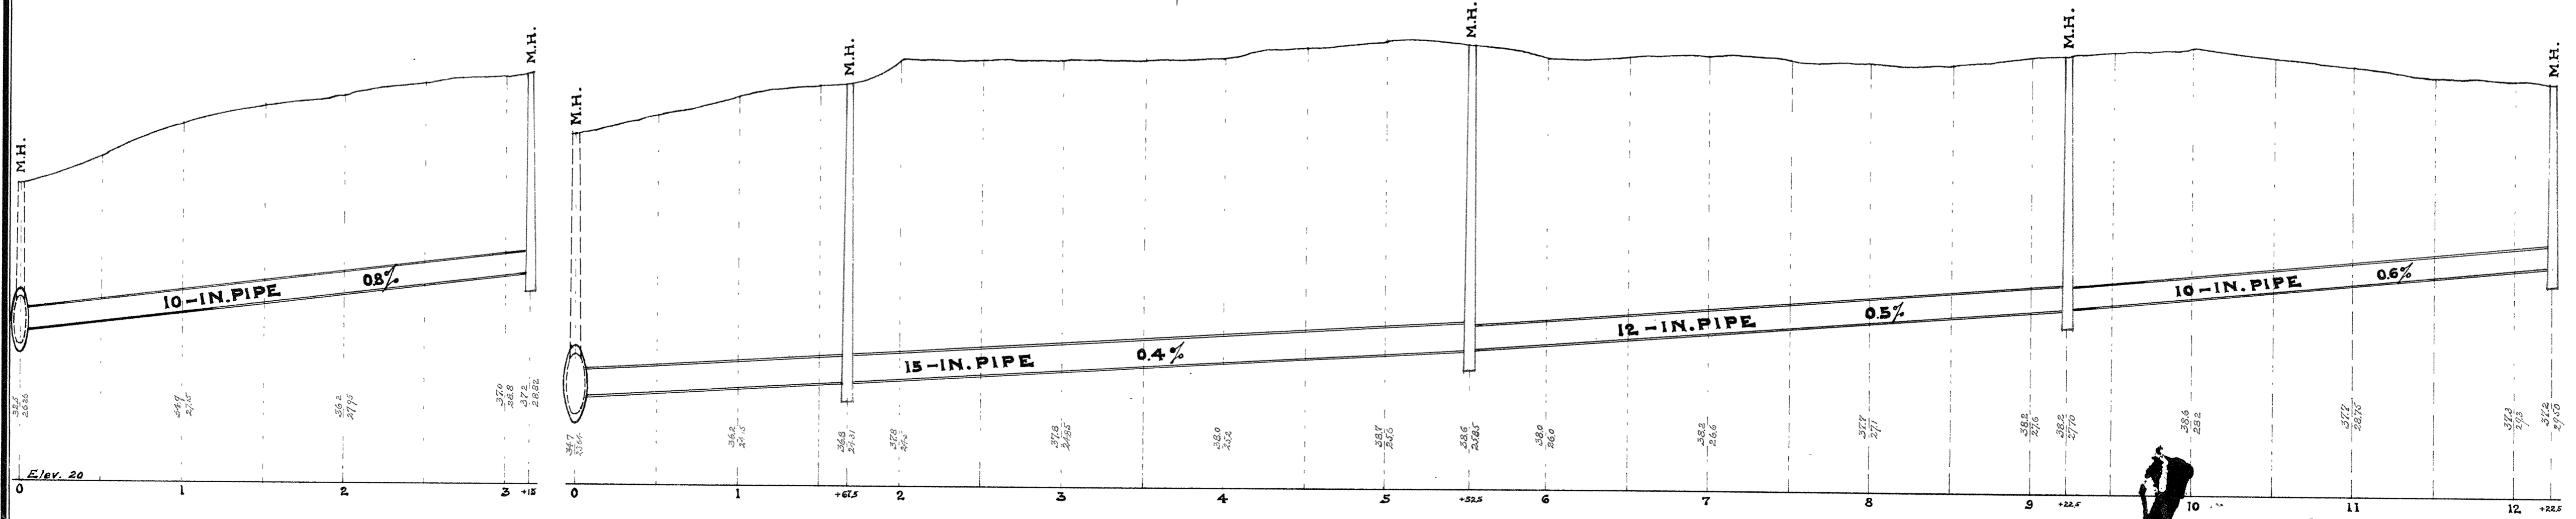

2B-76