


# CITY OF SUPERIOR SEWER PLAN

Horizontal Scale: 1 in. = 100 ft.  
 Vertical Scale: 1 in. = 4 ft.  
 CONTRACT No 1450  
 Contract let Dec. 31, 14.  
 Contract completed March 15, 15.  
 Smith Bros. & Jacobsen Contractors  
 Andrew Solin Inspector  
 E. B. Banks City Engineer

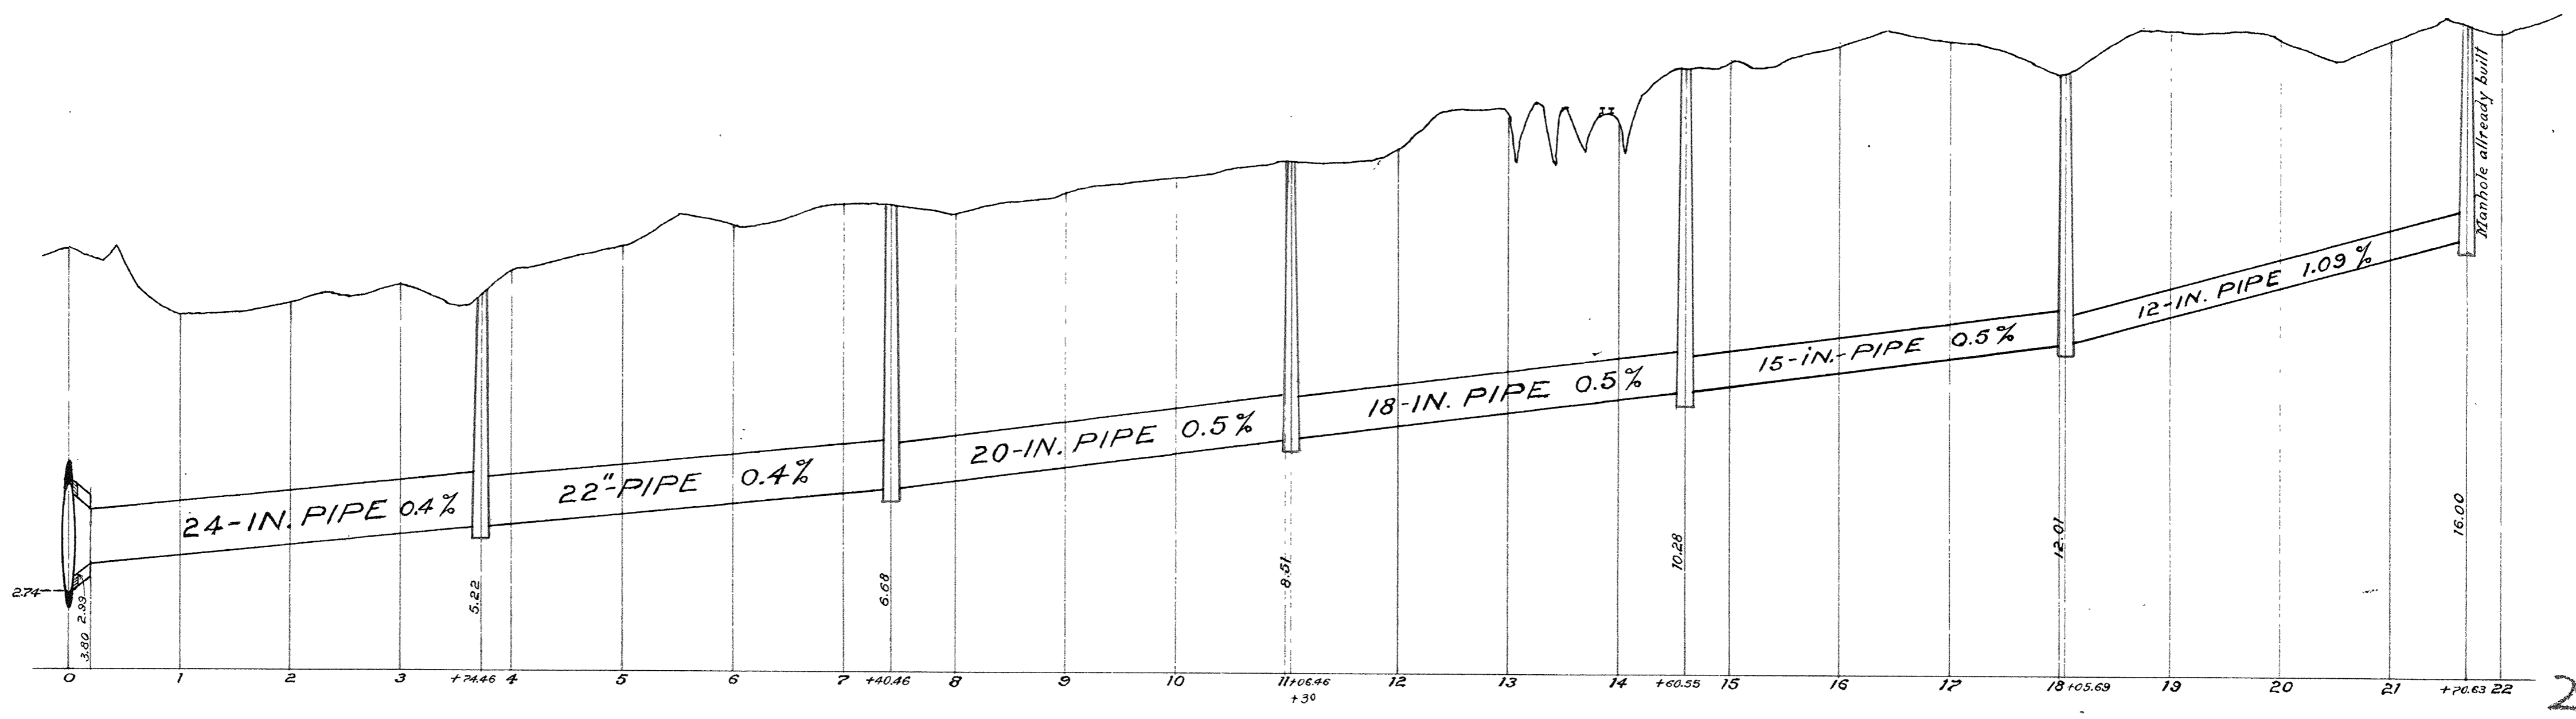

2B-77