
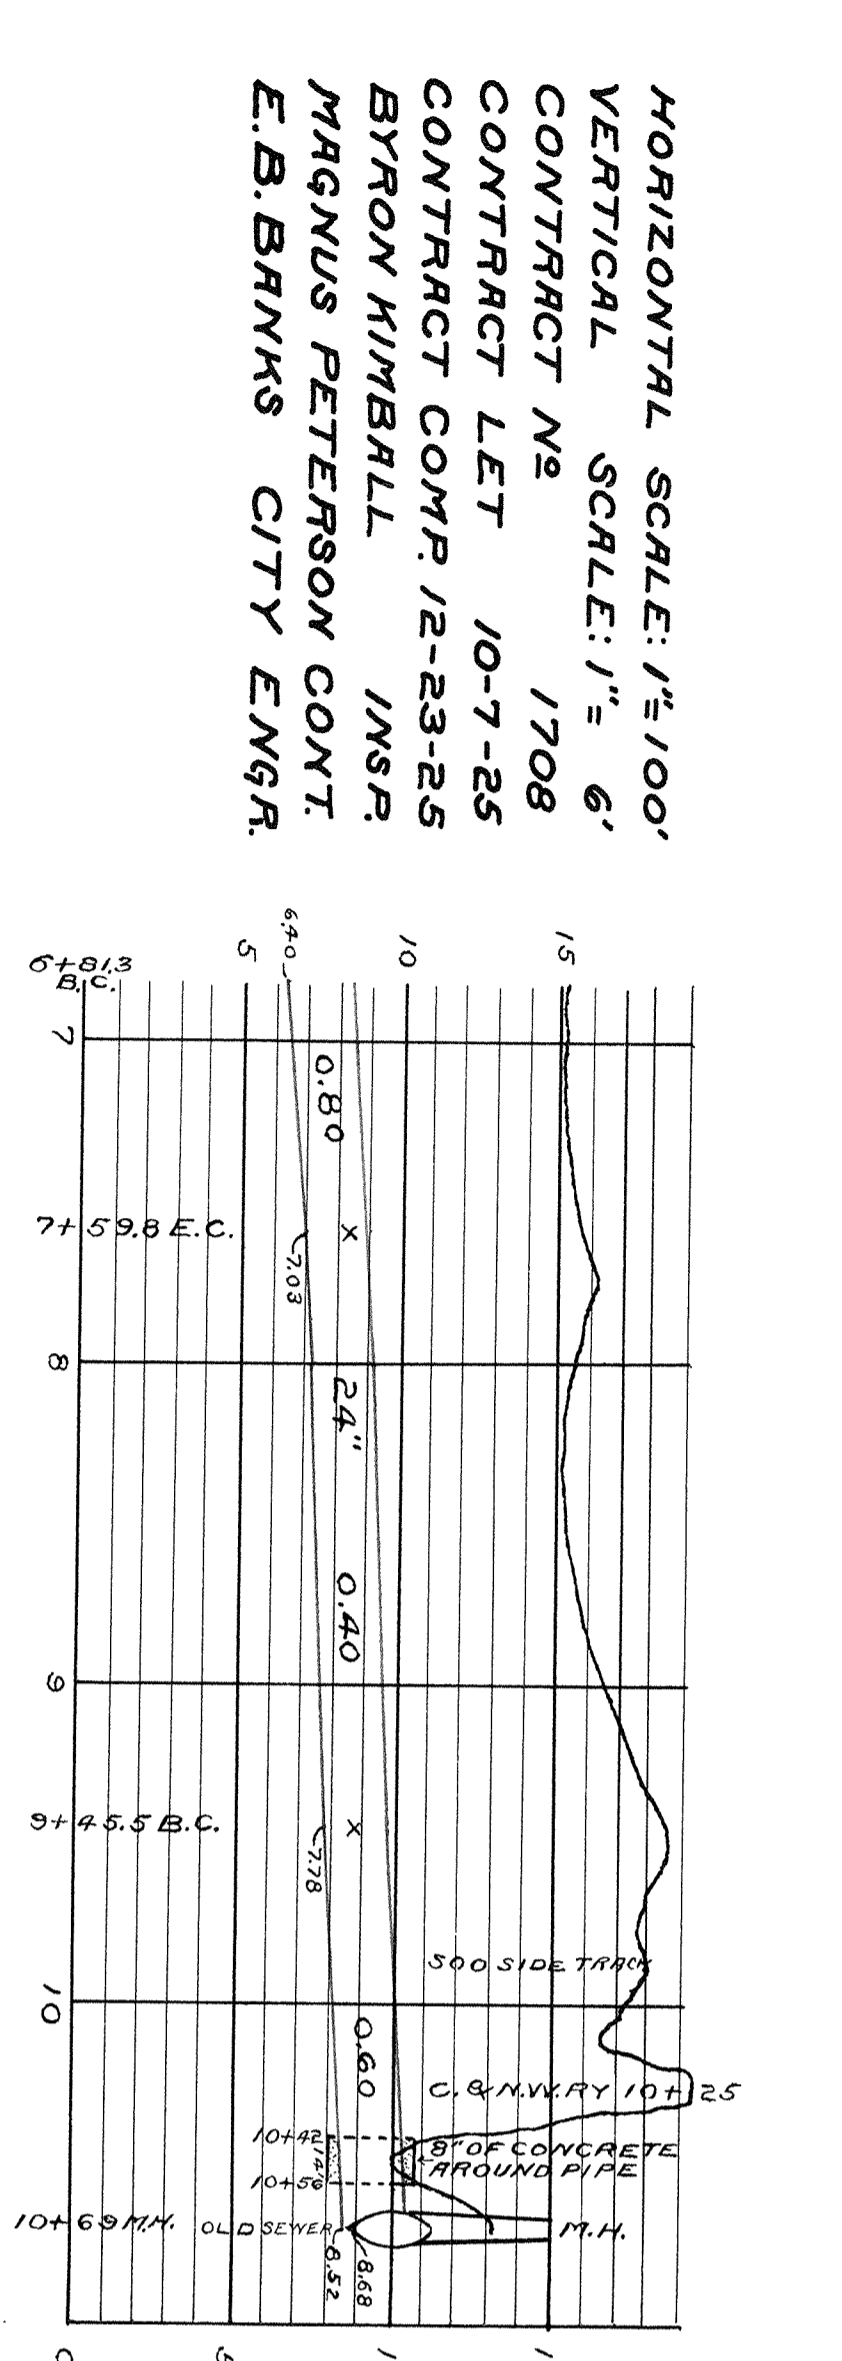
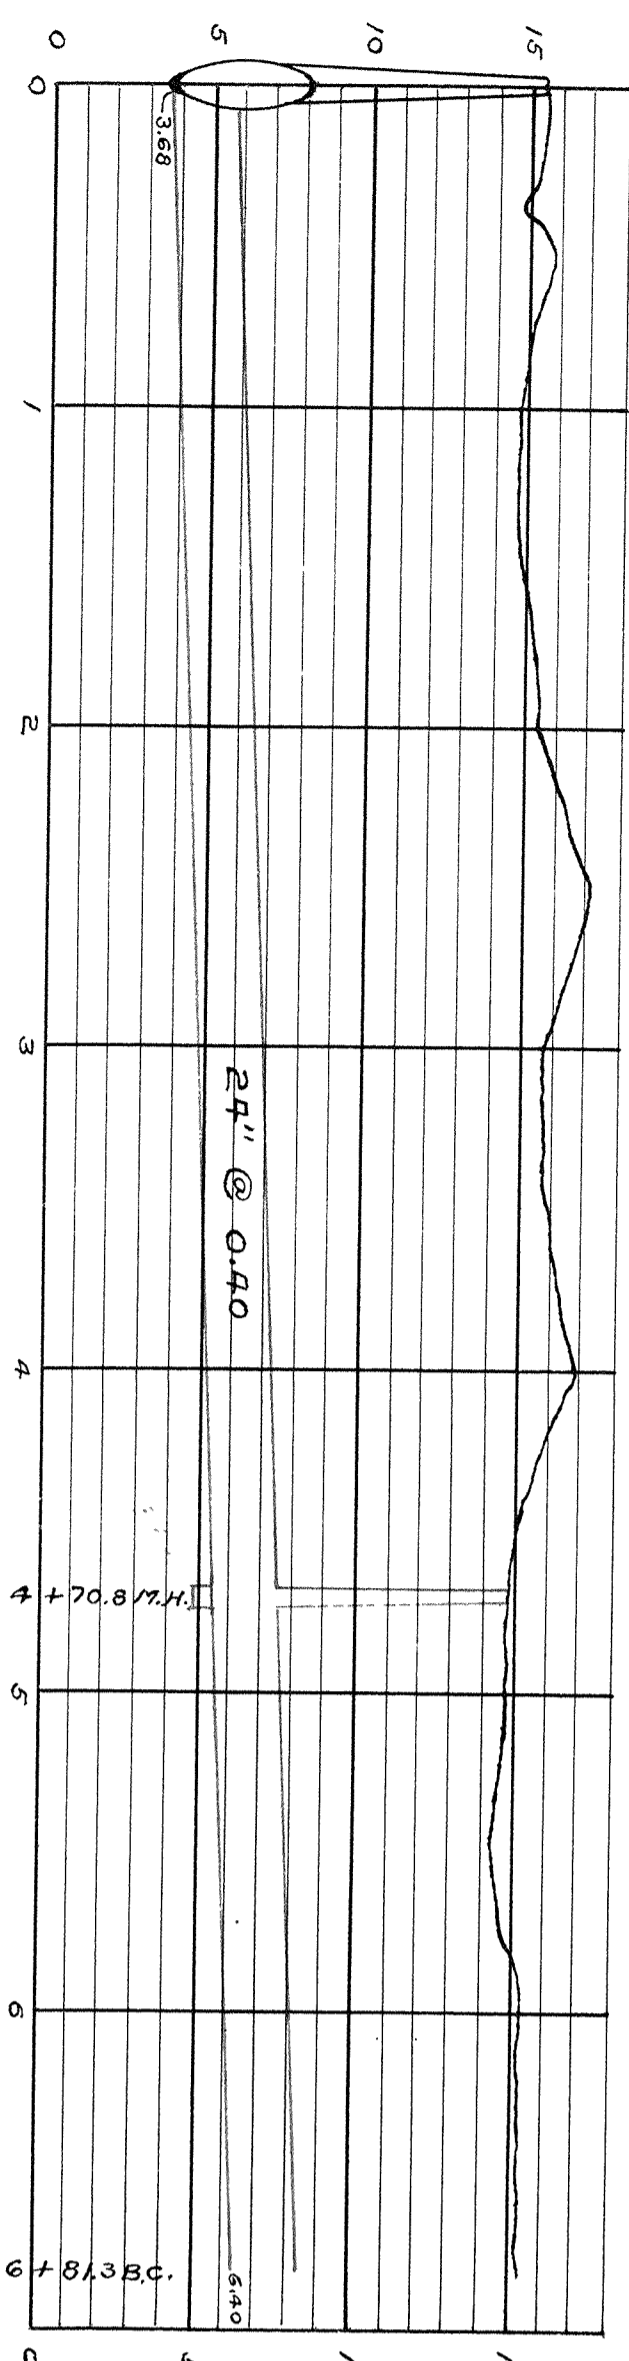


ELM AVE.

WINTER ST.

BROADWAY

CONAN AVE.

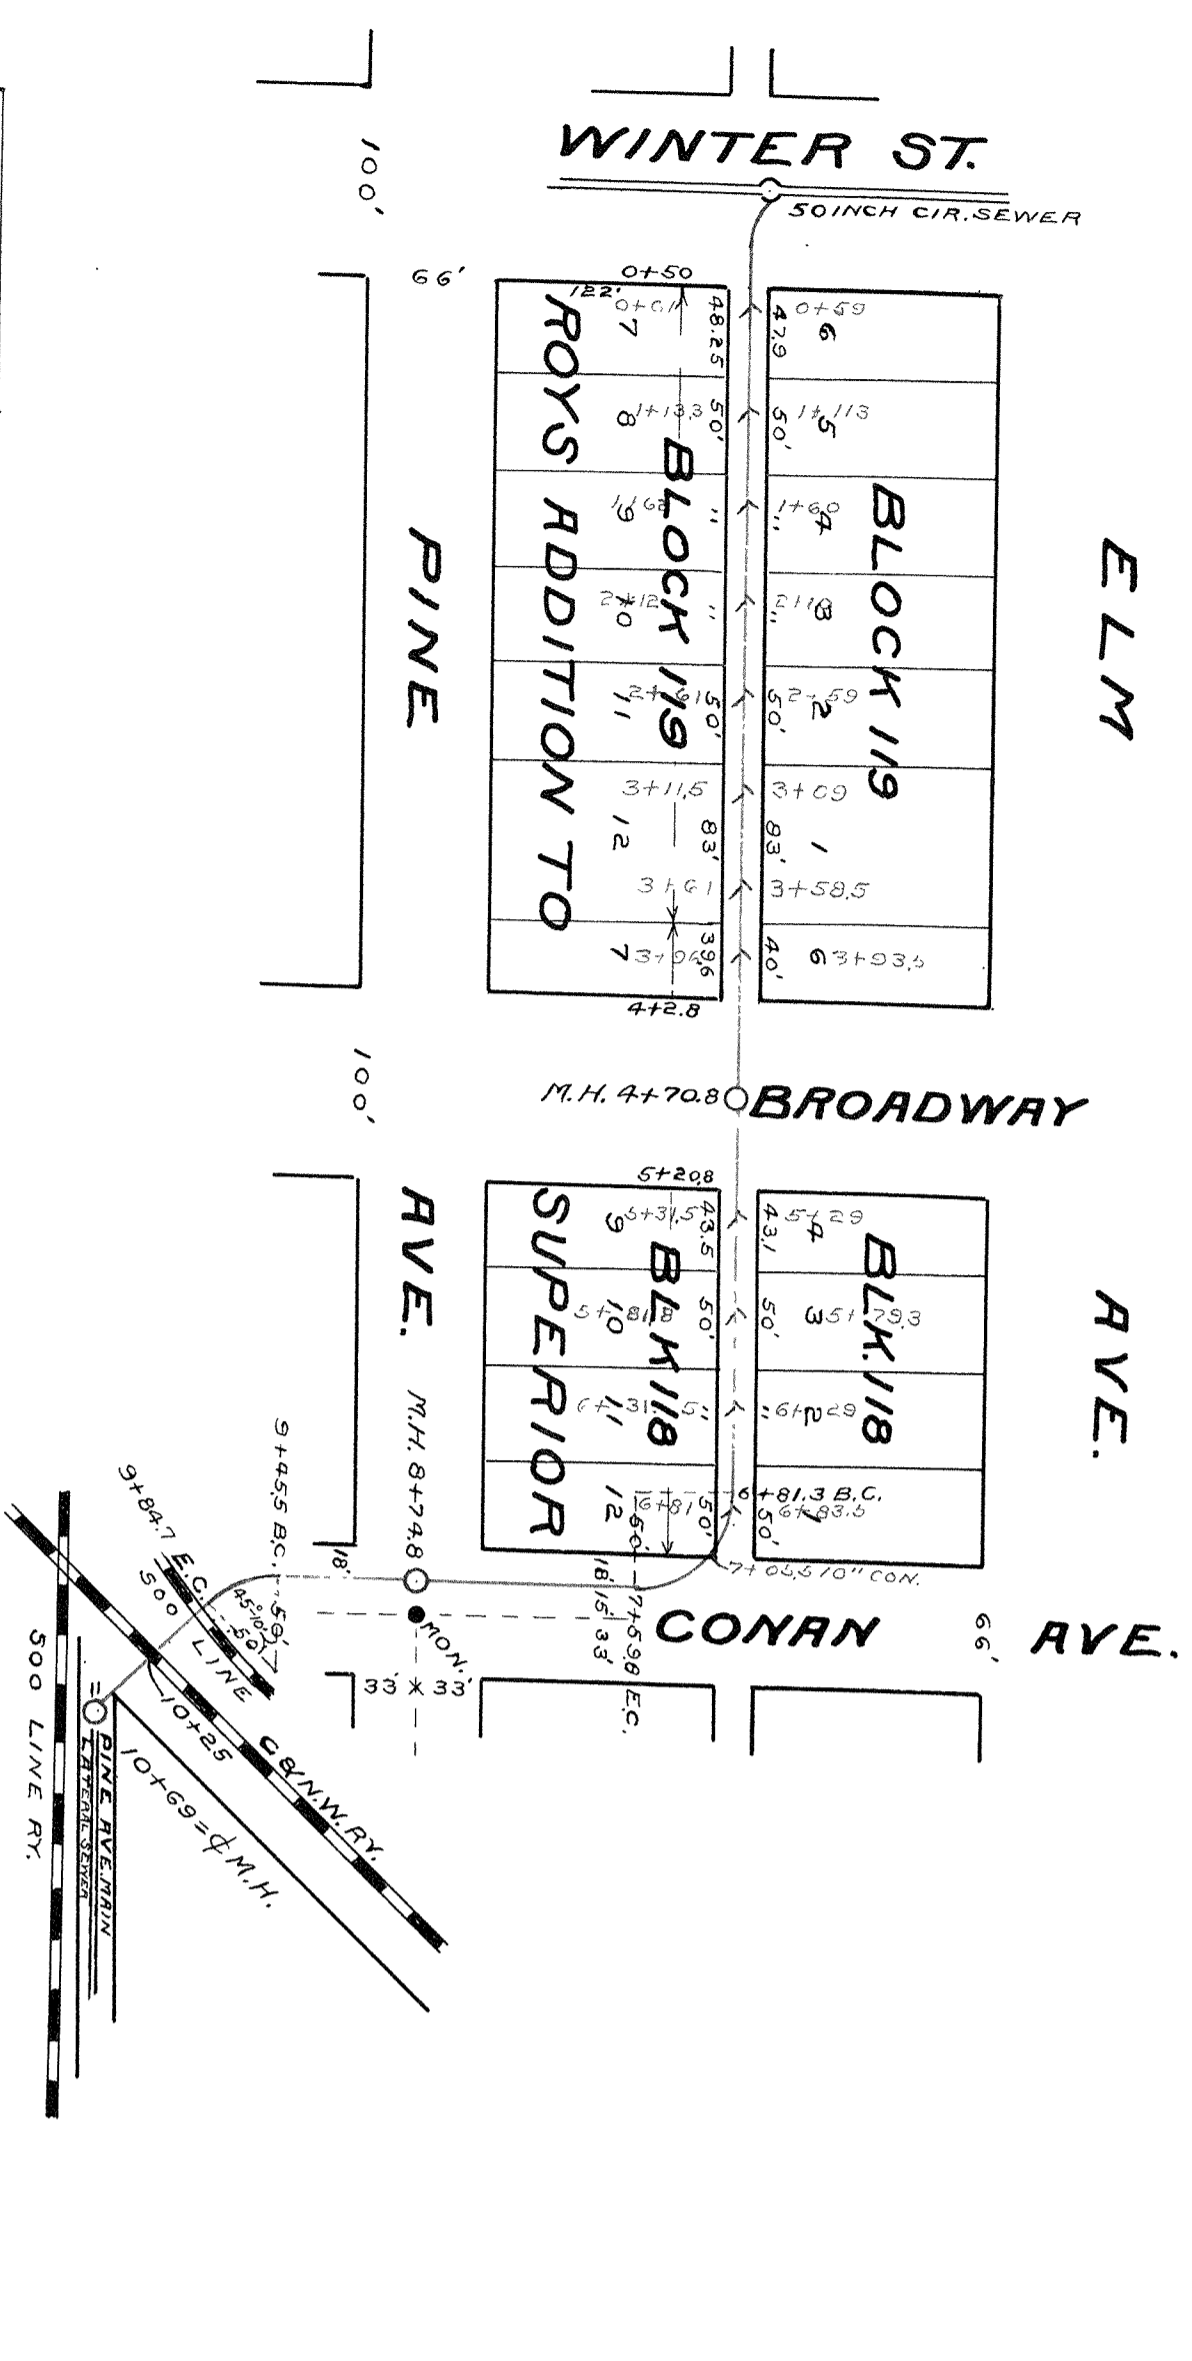

HORIZONTAL SCALE: 1"=100'
 VERTICAL SCALE: 1"=6'
 CONTRACT N^o 1708
 CONTRACT LET 10-7-25
 CONTRACT COMP 12-23-25
 BYRON HIMBALL INSP
 MAGNUS PETERSON CONT.
 E.B. BANKS CITY ENGR.

MAP AND PROFILE
 SHOWING EXTENSION OF THE
 PINE AVE. MAIN LATERAL SEWER
 FROM ITS PRESENT TERMINUS NEAR
 CONAN AVE. TO CONNECT WITH
 WINTER ST MAIN SEWER