


CITY OF SUPERIOR  
SEWER PLAN

HORIZONTAL SCALE  $i=60'$   
VERTICAL SCALE  $i=4'$

JOB STARTED MAY 1936  
JOB COMPLETED DEC. 2 1936  
W.P.A. LABOR  
M.S. SKAMSER INSPECTOR  
L.W. PELESKE CITY ENGINEER

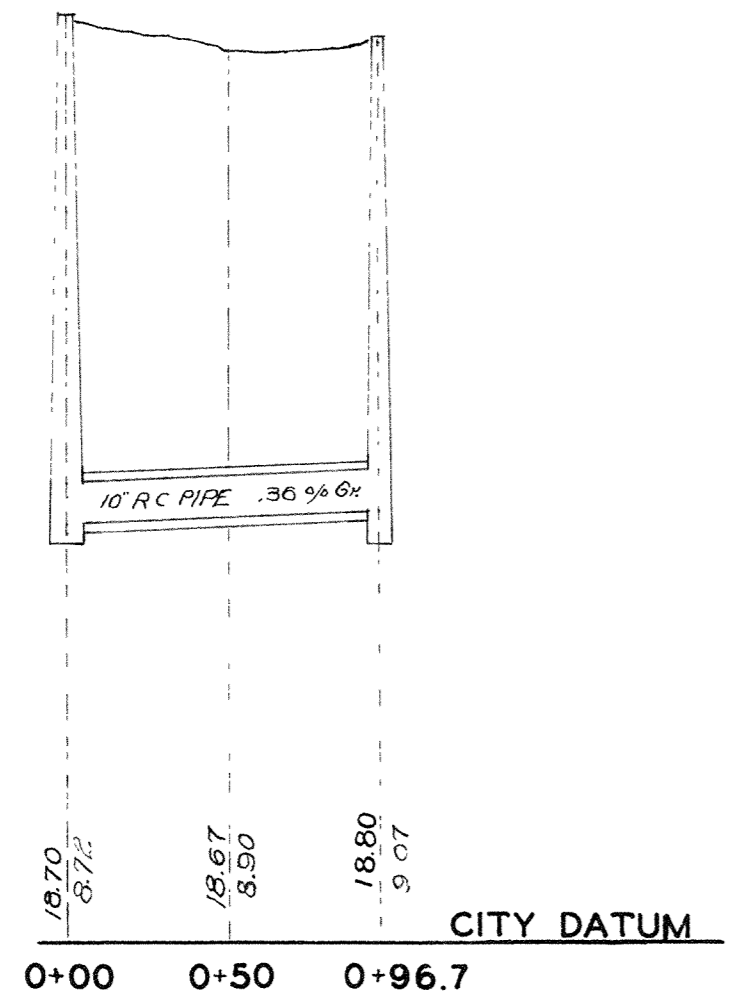

PLAN AND PROFILE OF SEWER IN ALLEY BETWEEN E. 4TH AND 5TH. ST. FROM F. ST. EAST

2B-85