


**CITY OF SUPERIOR
SEWER PLAN**

HOR. SCALE 1" = 60'
VERT. SCALE 1" = 4'
KILLEN & WILLE - CONSTRUCTORS
COMPLETED - DEC. 1950
K. OLSON - INSPECTOR
T. M. BASTERASH - CITY ENGINEER

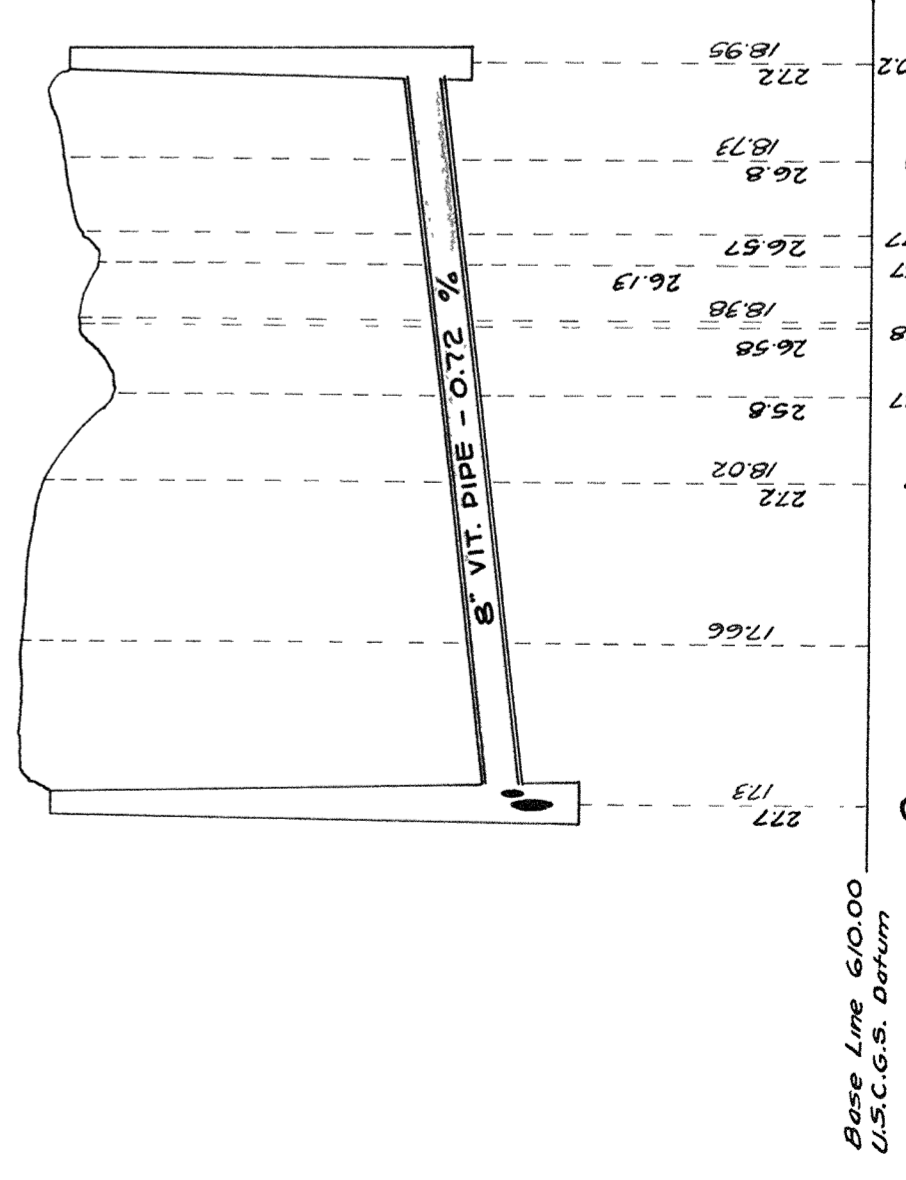

PROFILE of SEWER in 14TH ST.