



1"=50' HORZ.
1"=5' VERT.

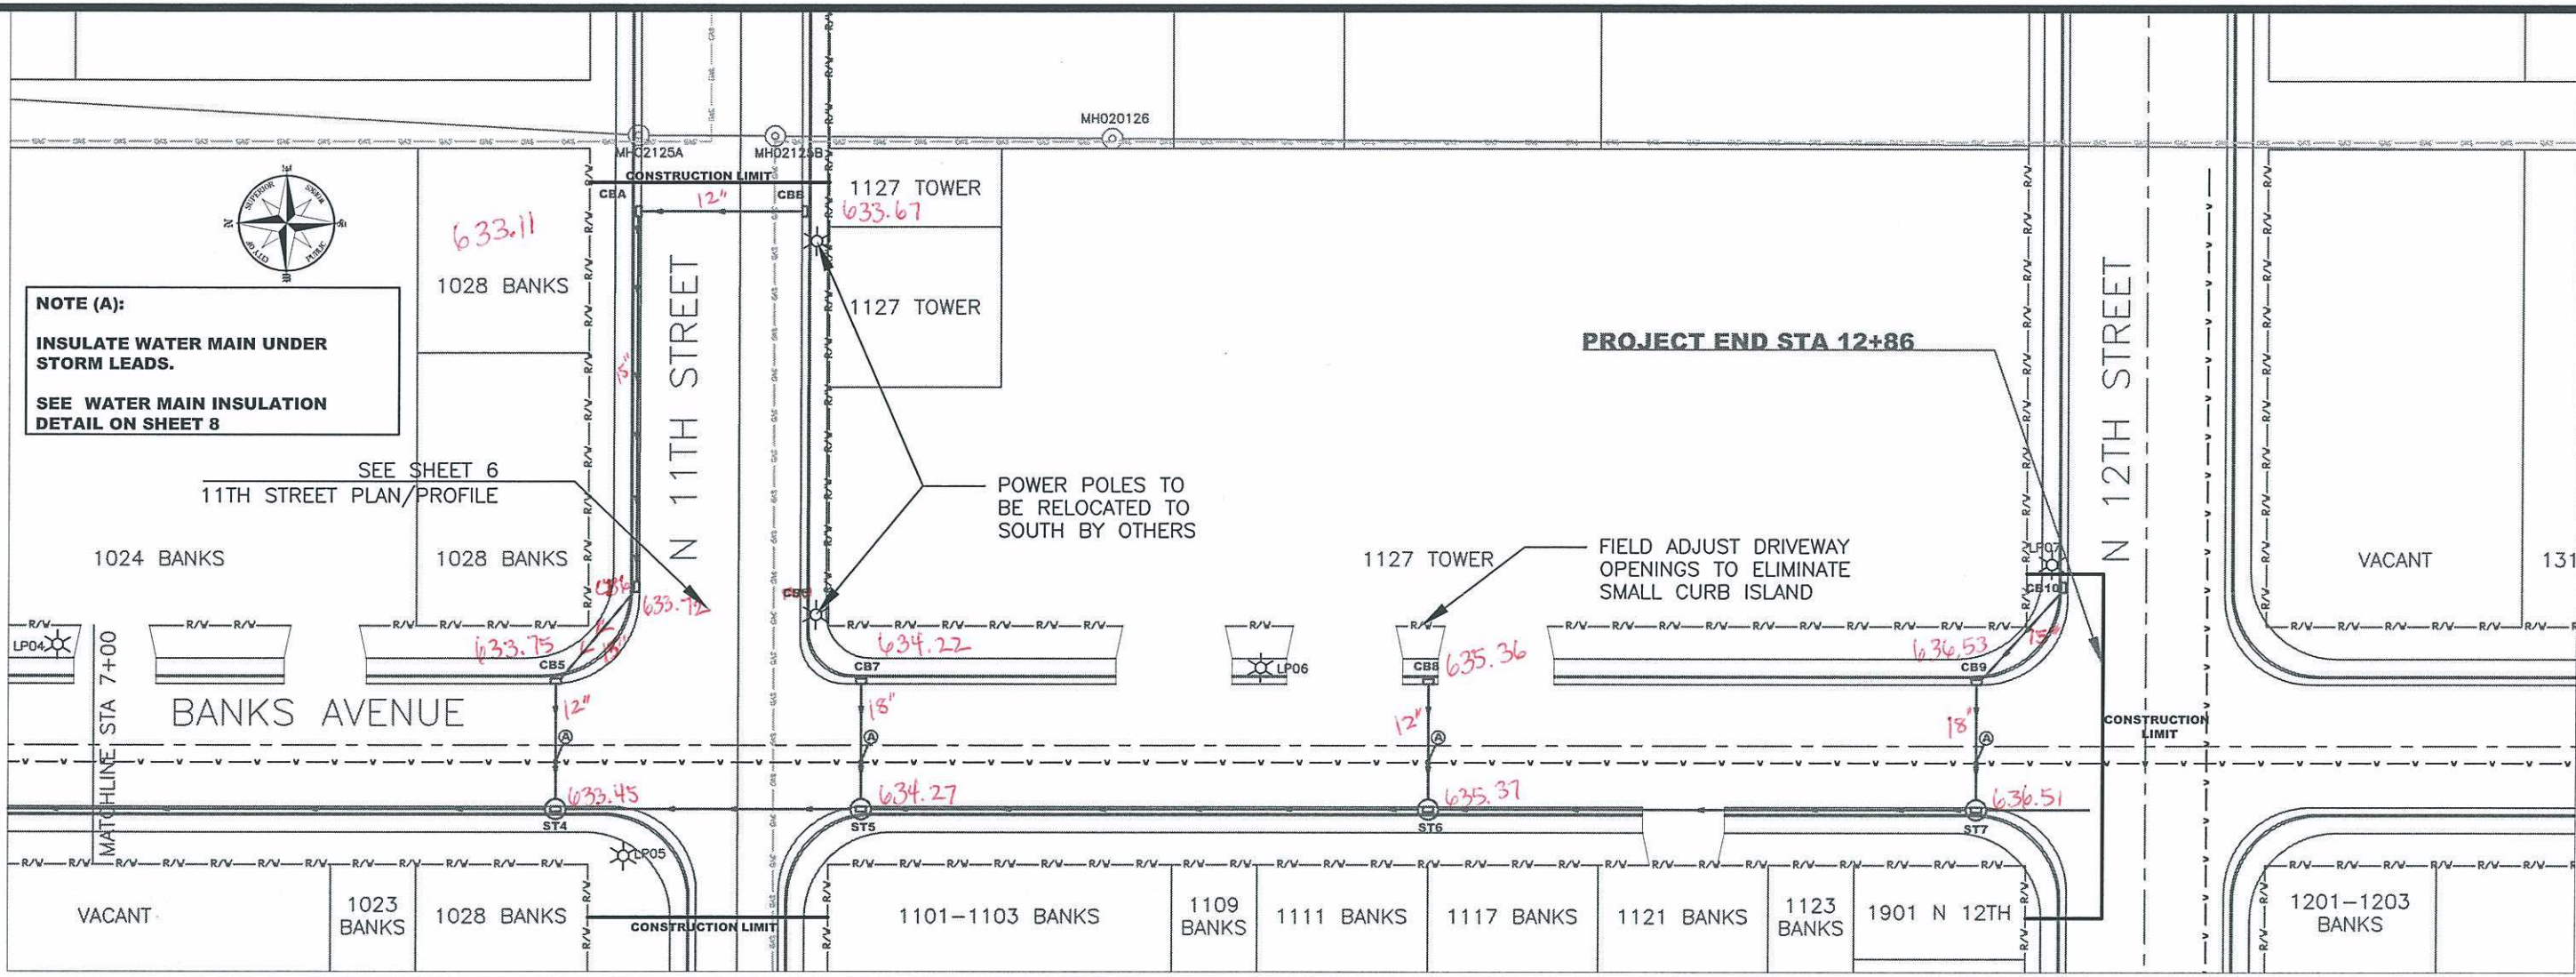

NOTE (A):
 INSULATE WATER MAIN UNDER STORM LEADS.
 SEE WATER MAIN INSULATION DETAIL ON SHEET 8

PROJECT END STA 12+86

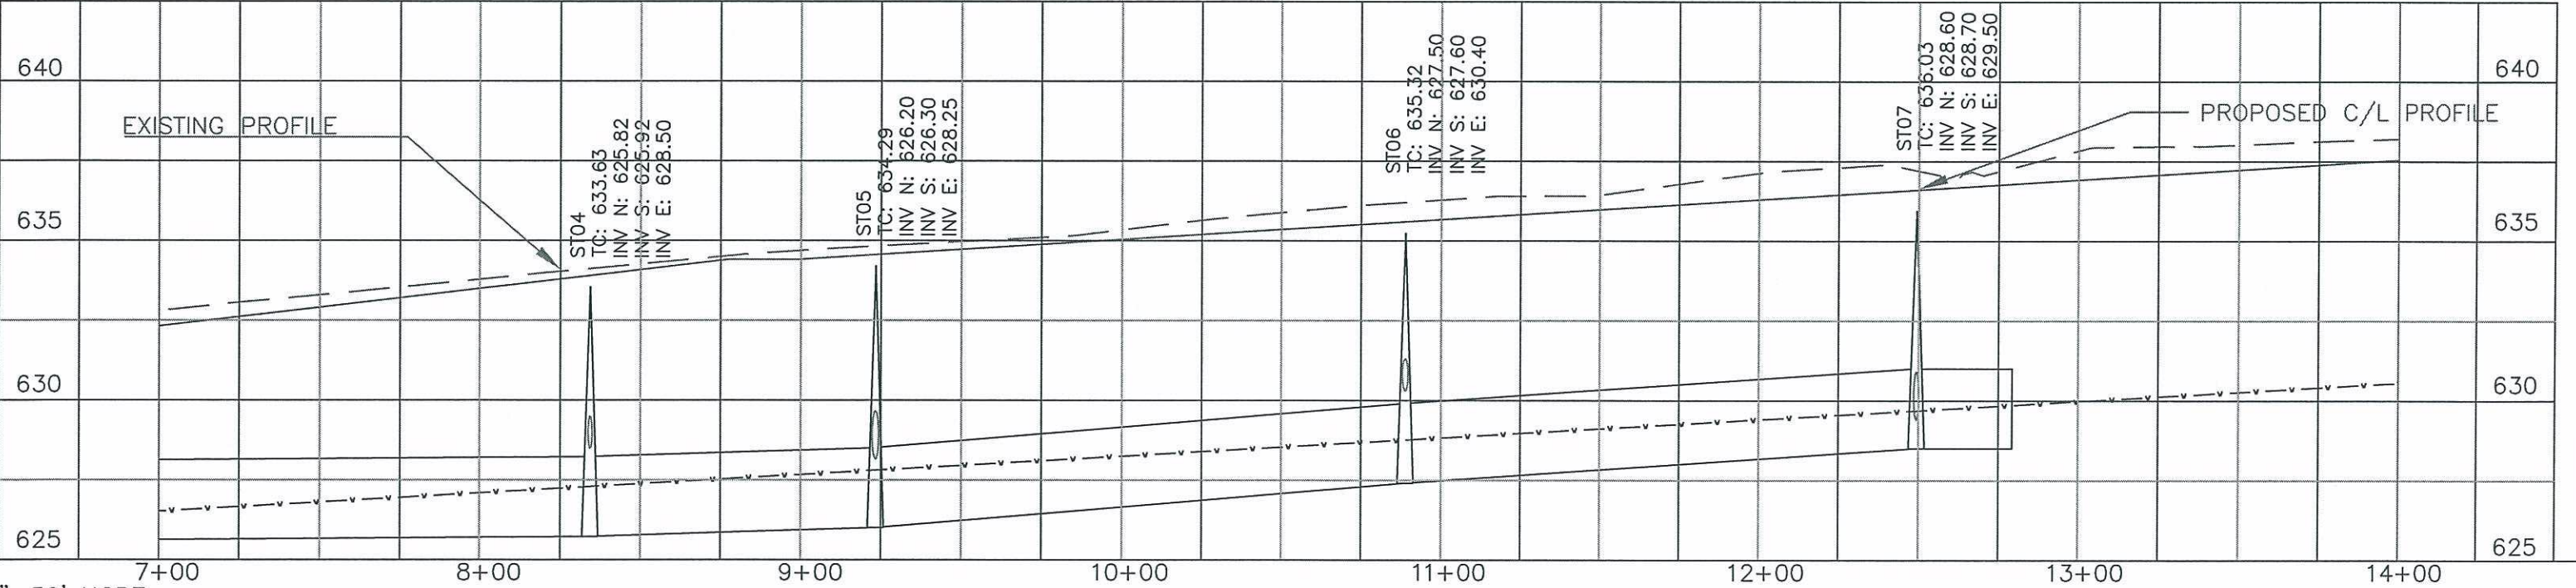

1"=50' HORZ.
 1"=5' VERT.