


CYPRESS AVE.

REPLACE WINTER ST CROSSING WITH TYPE V STREET SECTION

WINTER ST.

Scale: 1" = 50' Horiz.  
1" = 10' Vert.

NOTE: 12" R.C.P. IS CL. IV

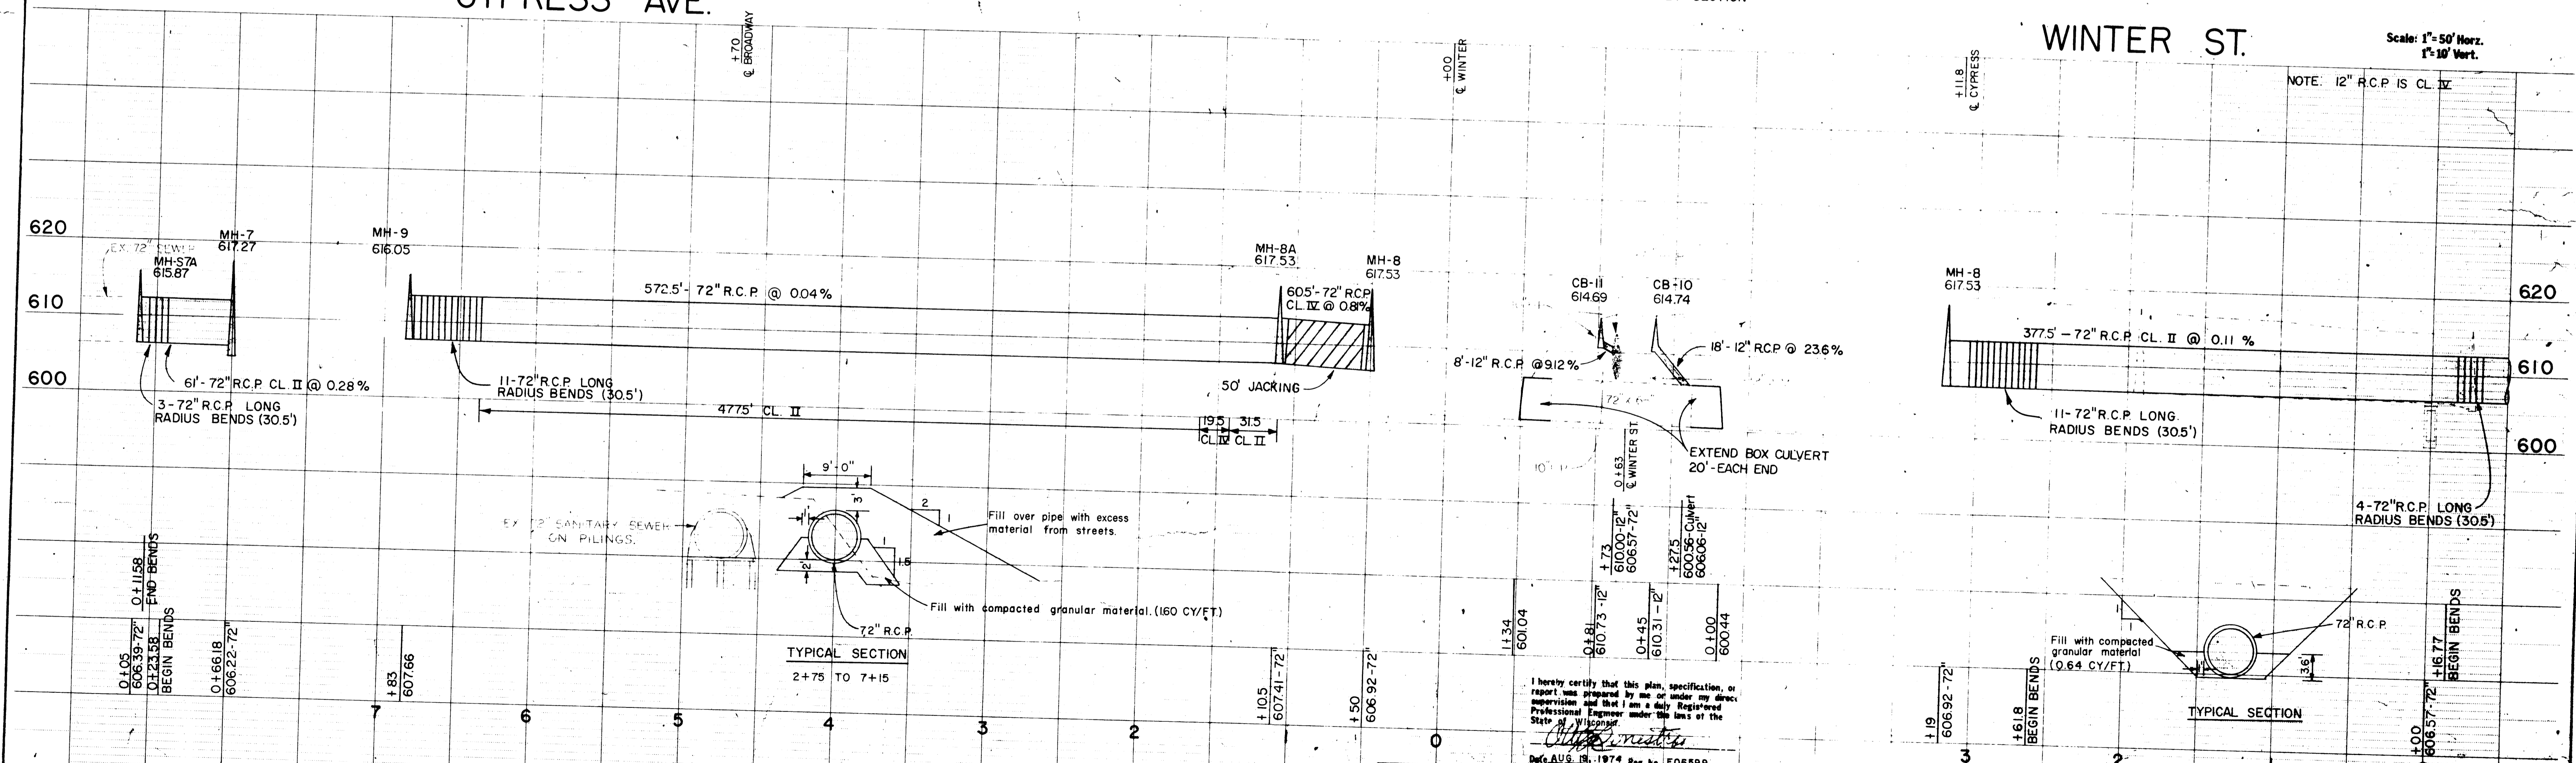

TYPICAL SECTION 2+75 TO 7+15

TYPICAL SECTION

I hereby certify that this plan, specification, or report was prepared by me or under my direct supervision and that I am a duly Registered Professional Engineer under the laws of the State of Wisconsin.  
*[Signature]*  
Date: AUG 13, 1974 Reg. No. ED6599

SURVEY	DOB	REVISIONS	<b>BONESTROO, ROSENE, ANDERLIK &amp; ASSOC., INC.</b> ST. PAUL, MINNESOTA	<b>SUPERIOR, WISCONSIN</b> DATE: JUNE 14, 1974 COMM. 6888H	DISTRICT 2 - CENTRAL BUSINESS <b>STORM SEWER SEPARATION</b> WINTER ST. & CYPRESS AVE.
DRAWN	DATE	RECORD PLAN			
DESIGN		1/16/79 HBR			
APPROVED					