
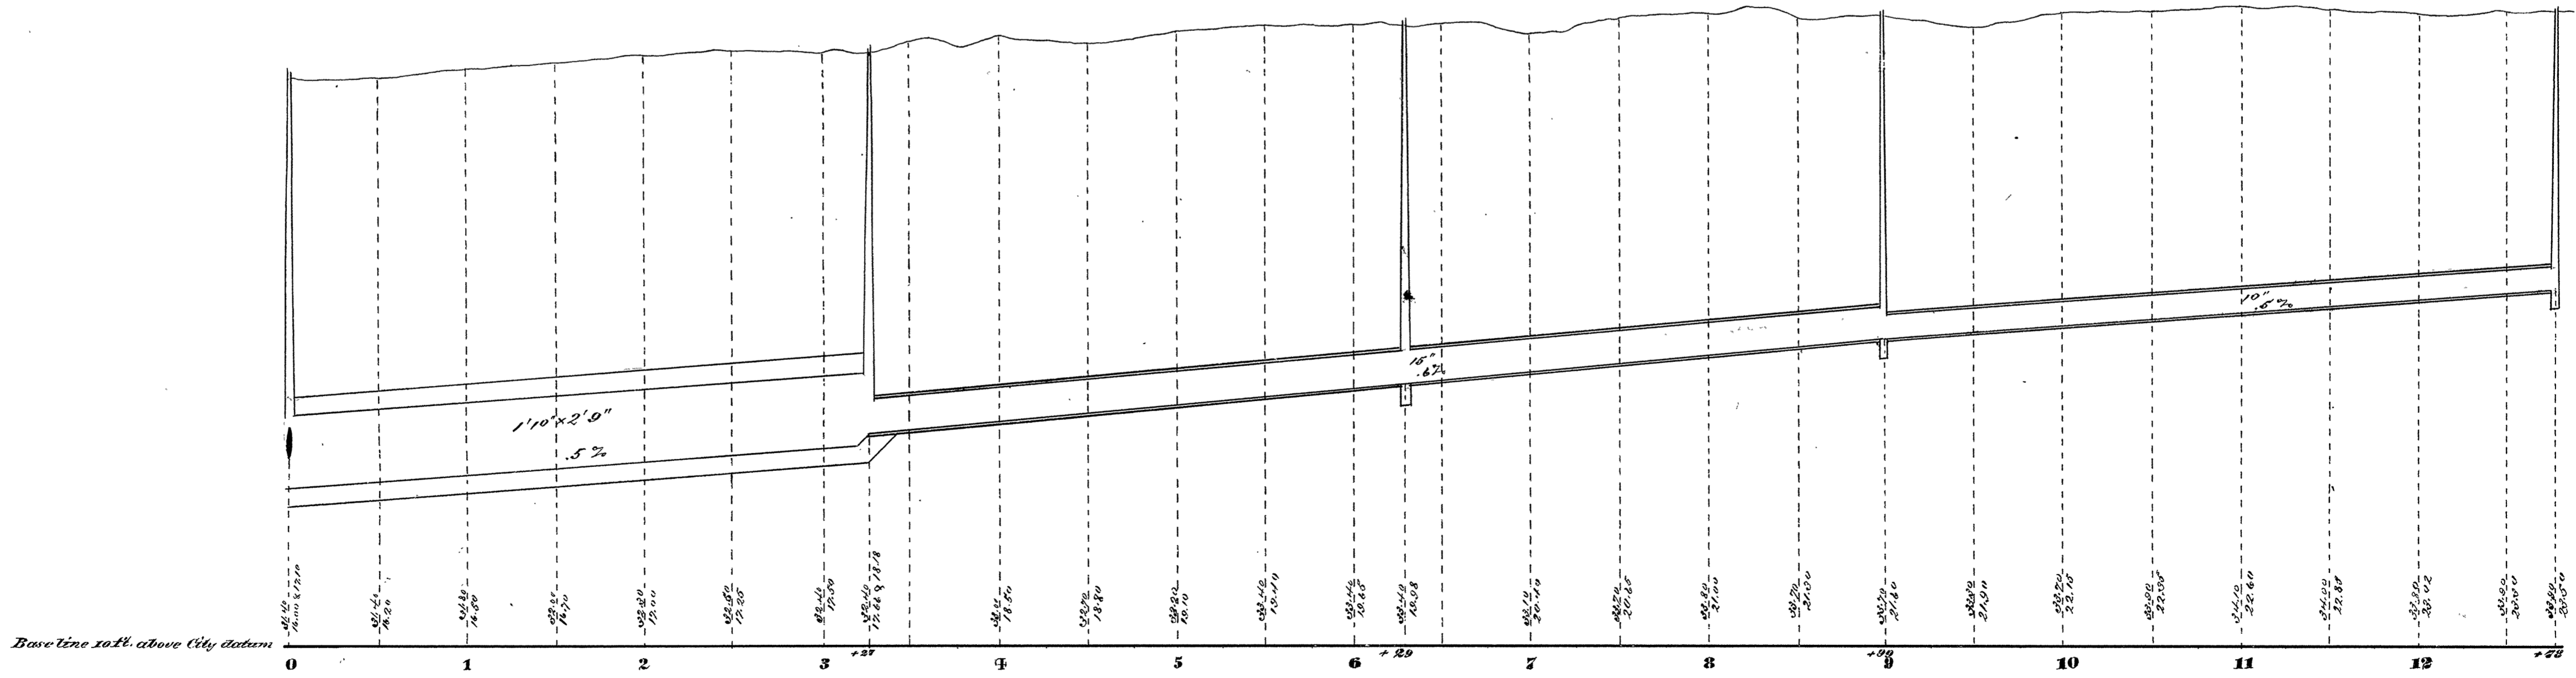
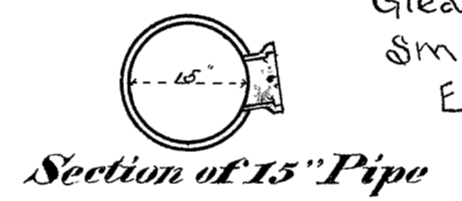


CITY OF SUPERIOR

SEWER PLAN

Contract let Sept. 17, 1890
 completed June 1, 1891
 Gleason Bros. & Rubyour, Contractor
 Smith & Richardson, Inspectors
 E. Banks, City Engr.

Scale: { Horizontal 1" = 60'
 Vertical 1" = 4'
 Section 1" = 2'

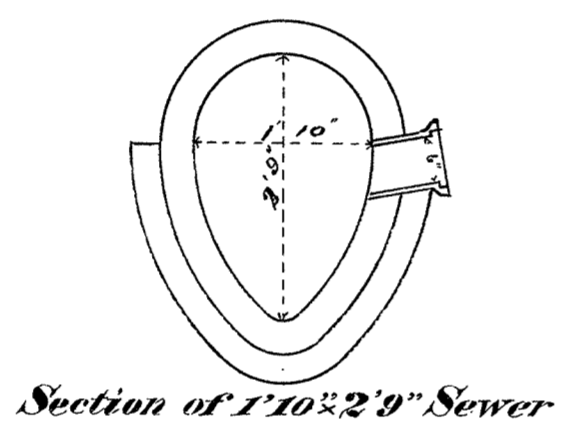

Plan & Profile of Sewer in Baker Ave. and in Alley between W. Fourth & Fifth Sts. from Baker to Richardson Ave.