



**CITY OF SUPERIOR
SEWER PLAN**


Contract Let May 26, 1890
relet April 3, 1891
completed Aug. 1, 1891
forrestal Bros. [failed] & F. A. Dole, Conrs.
Frank Richardson & Wm G. Coleman, Insps.
E. B. Banks, City Engr.

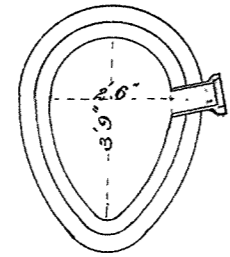


Section of Sewer

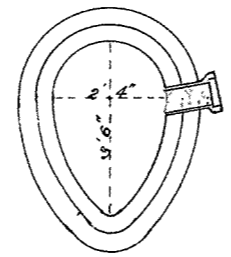

Section of Sewer

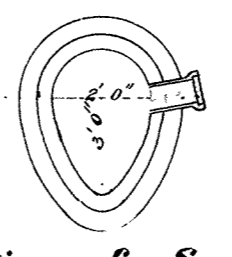


Section of Sewer

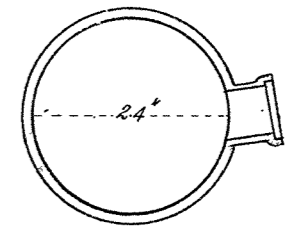

Section of Sewer

Scale { Horizontal 1" = 60'
Vertical 1" = 4'
Section 1" = 4' 1/2"
" of 24" pipe 1" = 2'

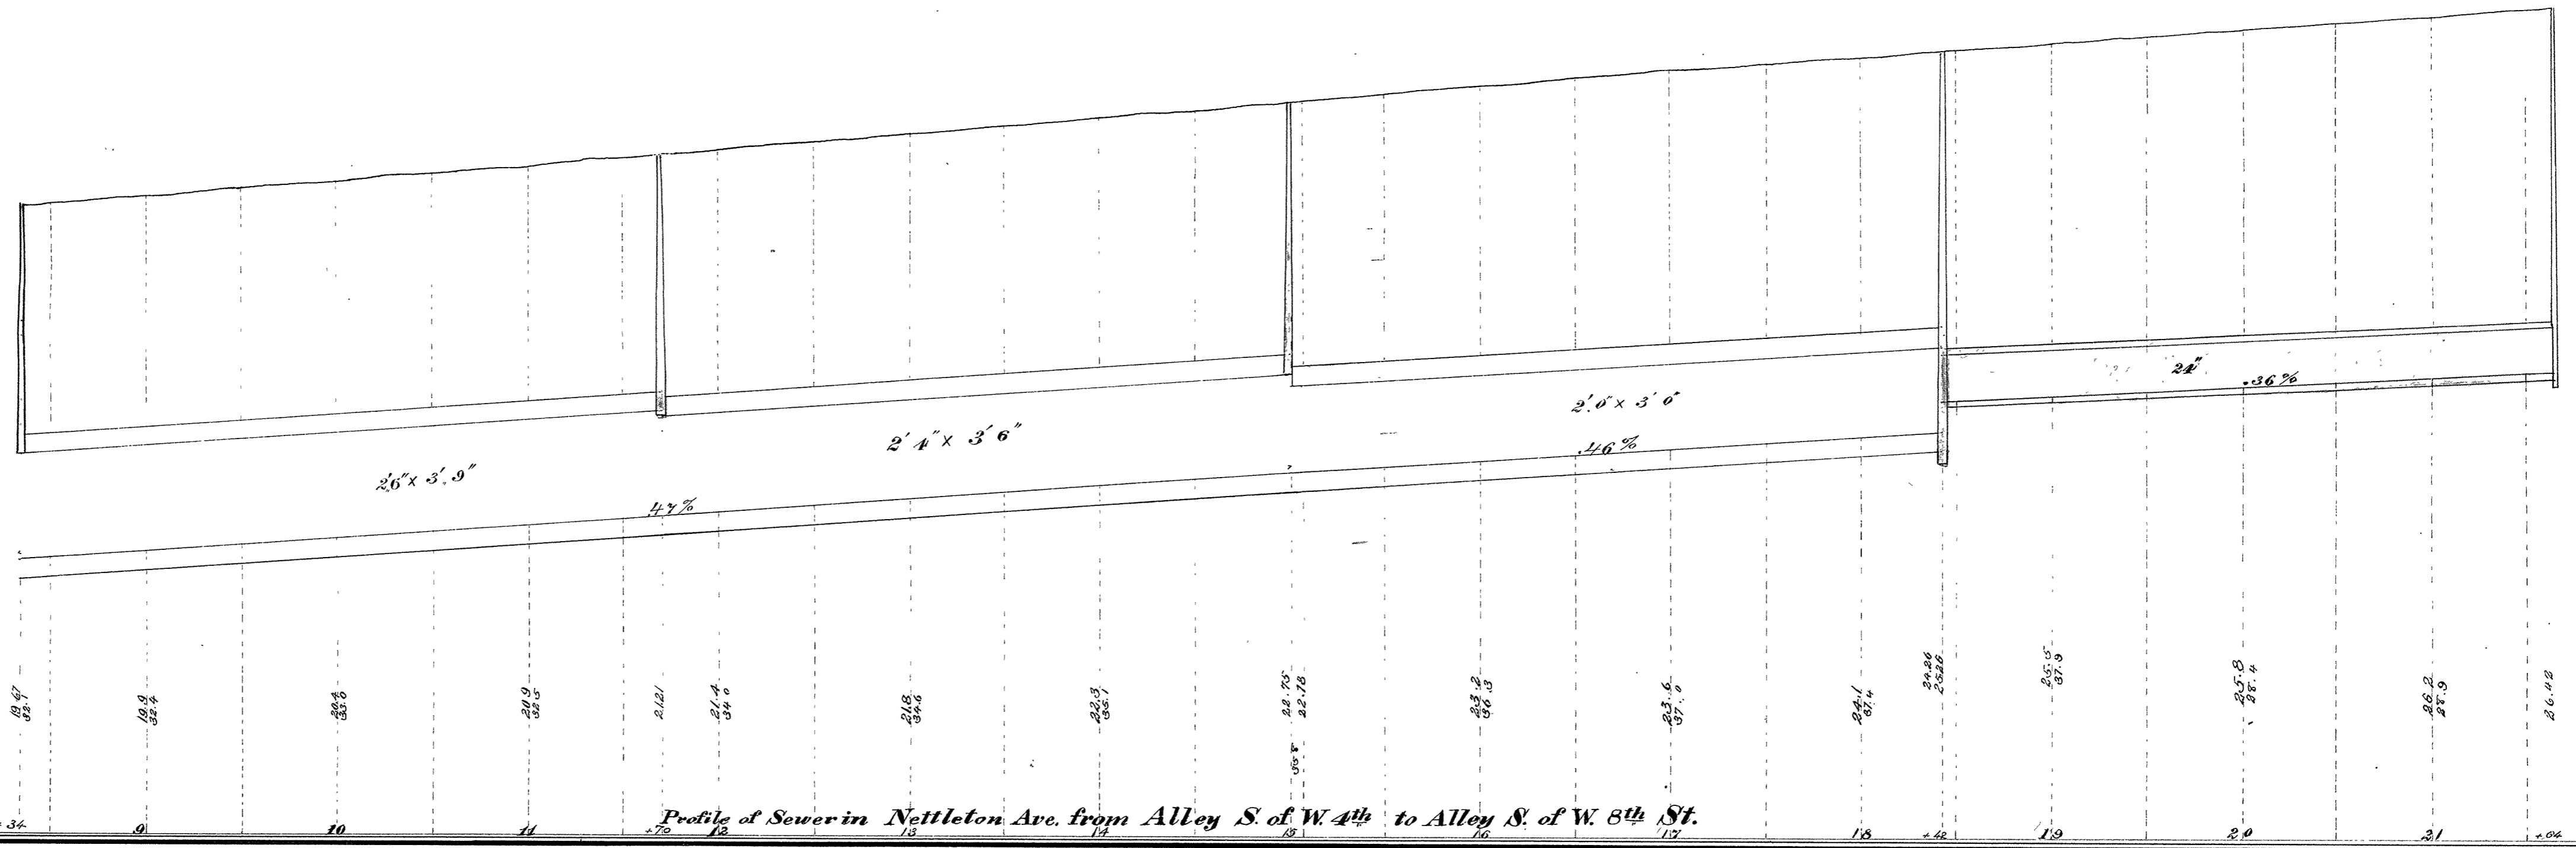

Base line 10' above datum

Profile of Sewer in Nettleton Ave. from Alley S. of W. 4th to Alley S. of W. 8th St.

4-10