
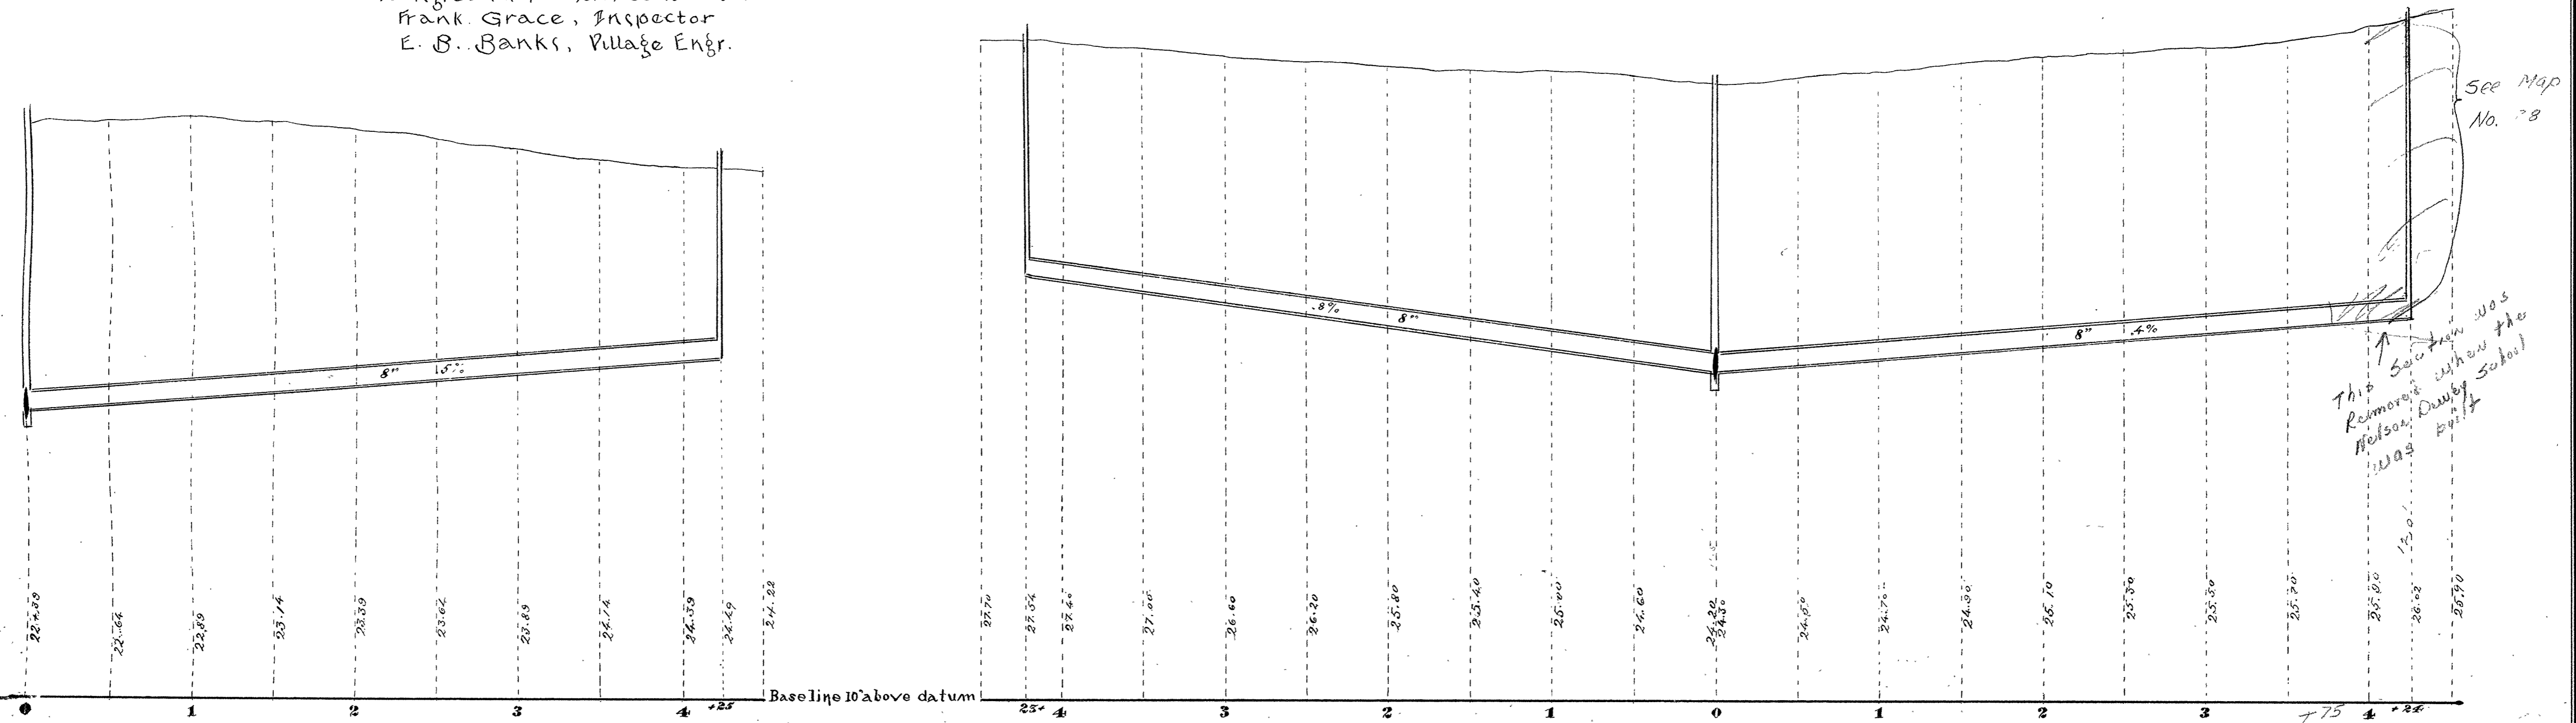


VILLAGE OF SUPERIOR
SEWER PLAN

Contract let July 17, 1888
completed
Younggreen & Gleason, Contractor
Frank Grace, Inspector
E. B. Banks, Village Engr.

1893

Scale: Horizontal 1" = 60'
Vertical 1" = 4'
Section 1" = 2'

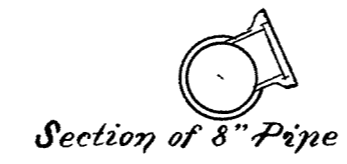

See Map No. 28

This Section was removed with the Nelson, Dwyer School