

W. FIRST ST.

ST.

W. SECOND ST.




ST.

BECKER 22<sup>ND</sup> AVE. E.

THOMPSON 23<sup>RD</sup> AVE. E.

STINSON 24<sup>TH</sup> AVE. E.

STINSON 24<sup>TH</sup> AVE. E.

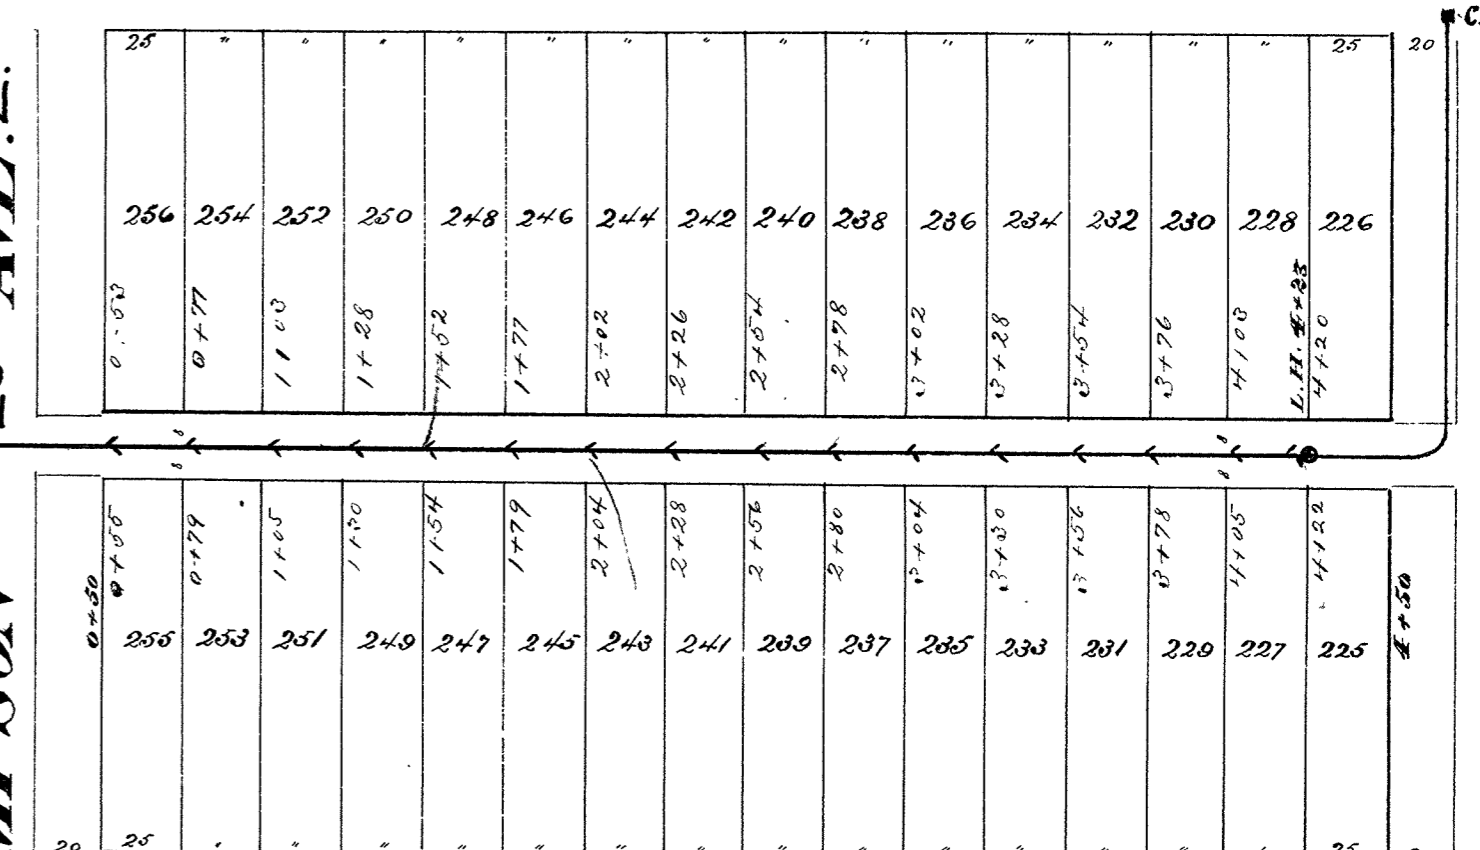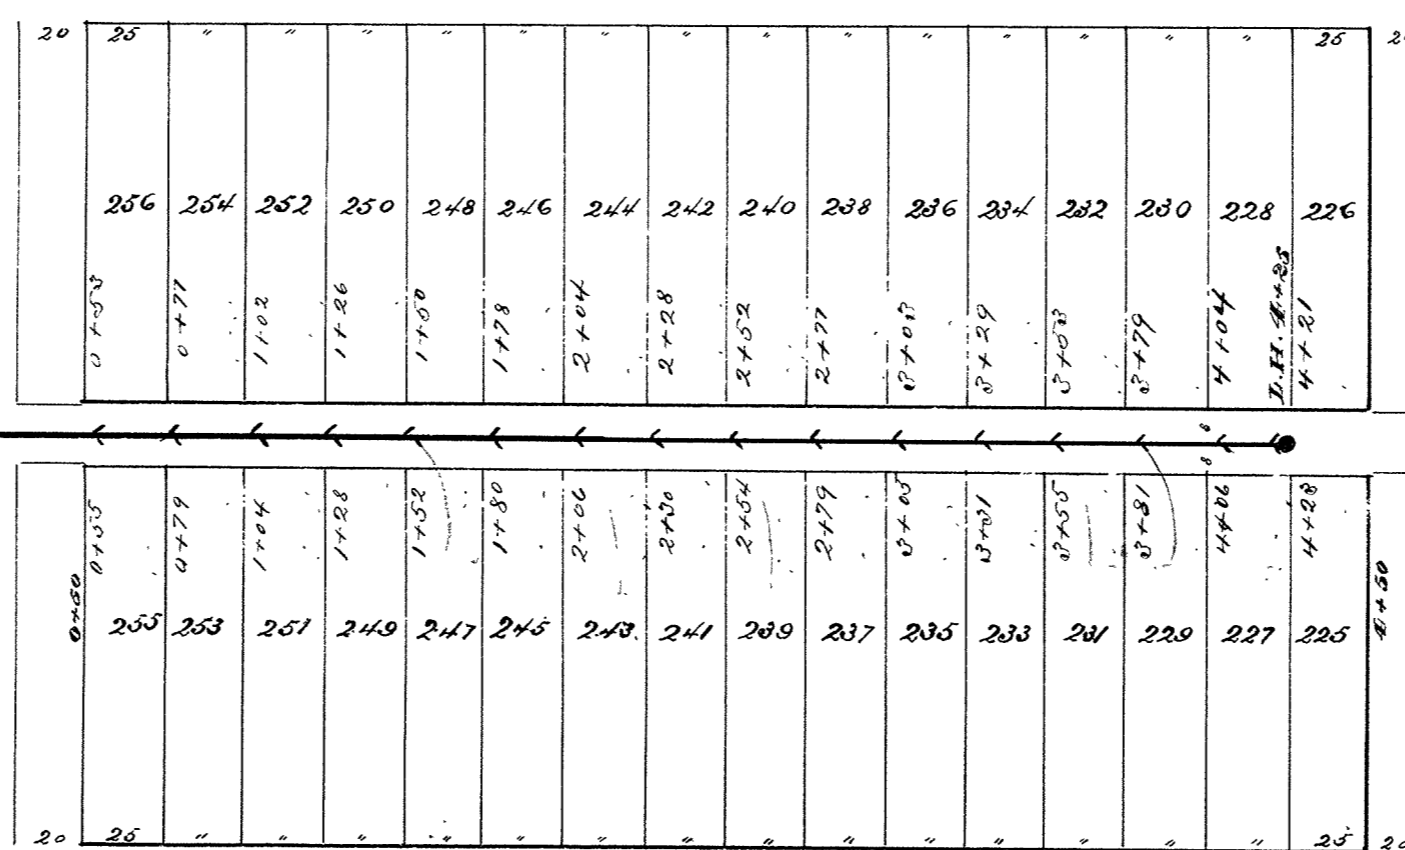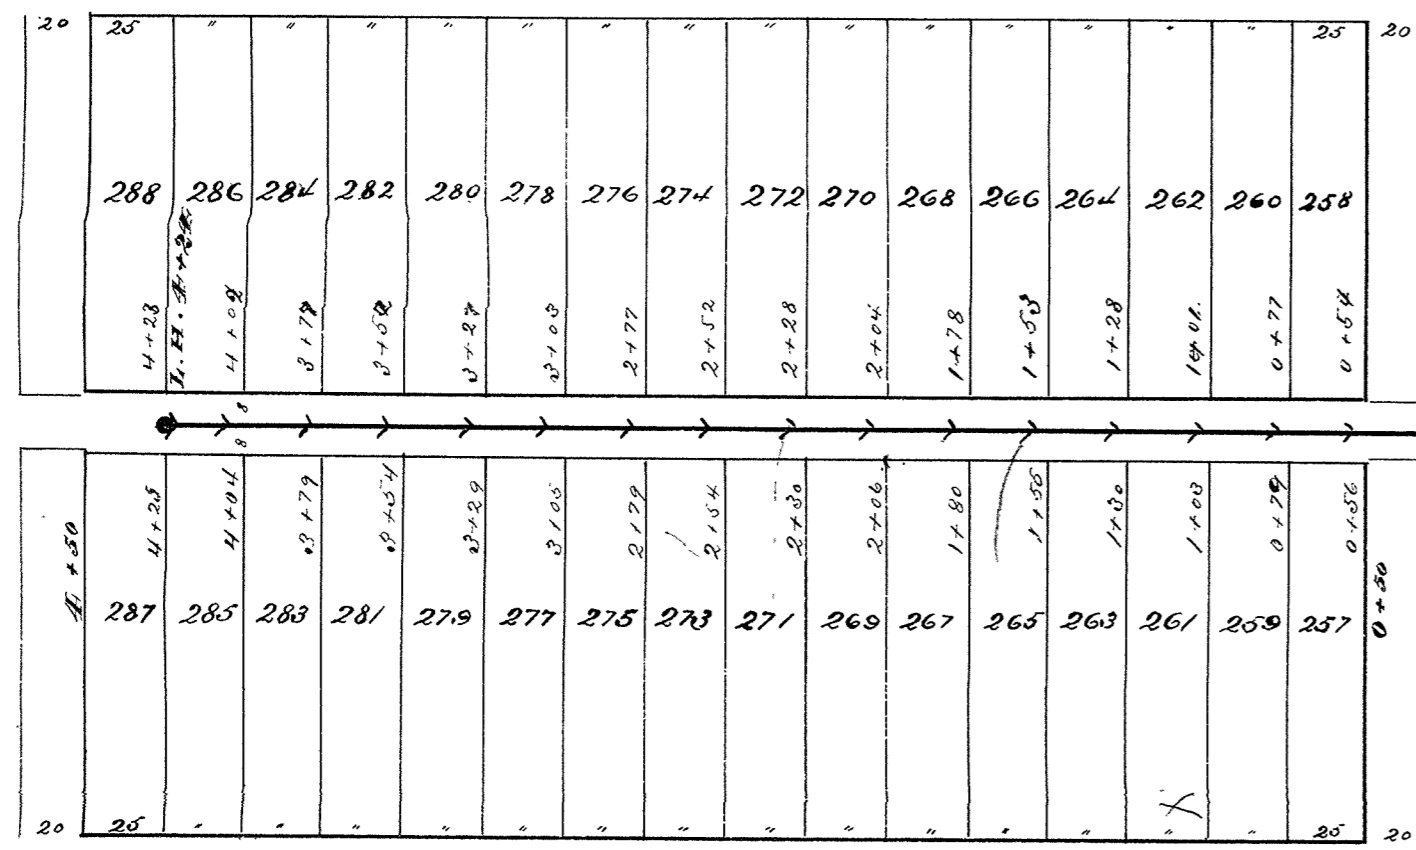

W. SECOND ST. VILLAGE OF SUPERIOR

ST.

W. THIRD ST.

ST.

# SEWER PLAN

Contract let July 17, 1888

completed



Younggreen & Gleason, Contractor

Frank Grace, Inspector

E. B. Banks, City Engineer

1893

Scale: Horizontal 1" = 60'  
Vertical 1" = 4"  
Section 1" = 2'

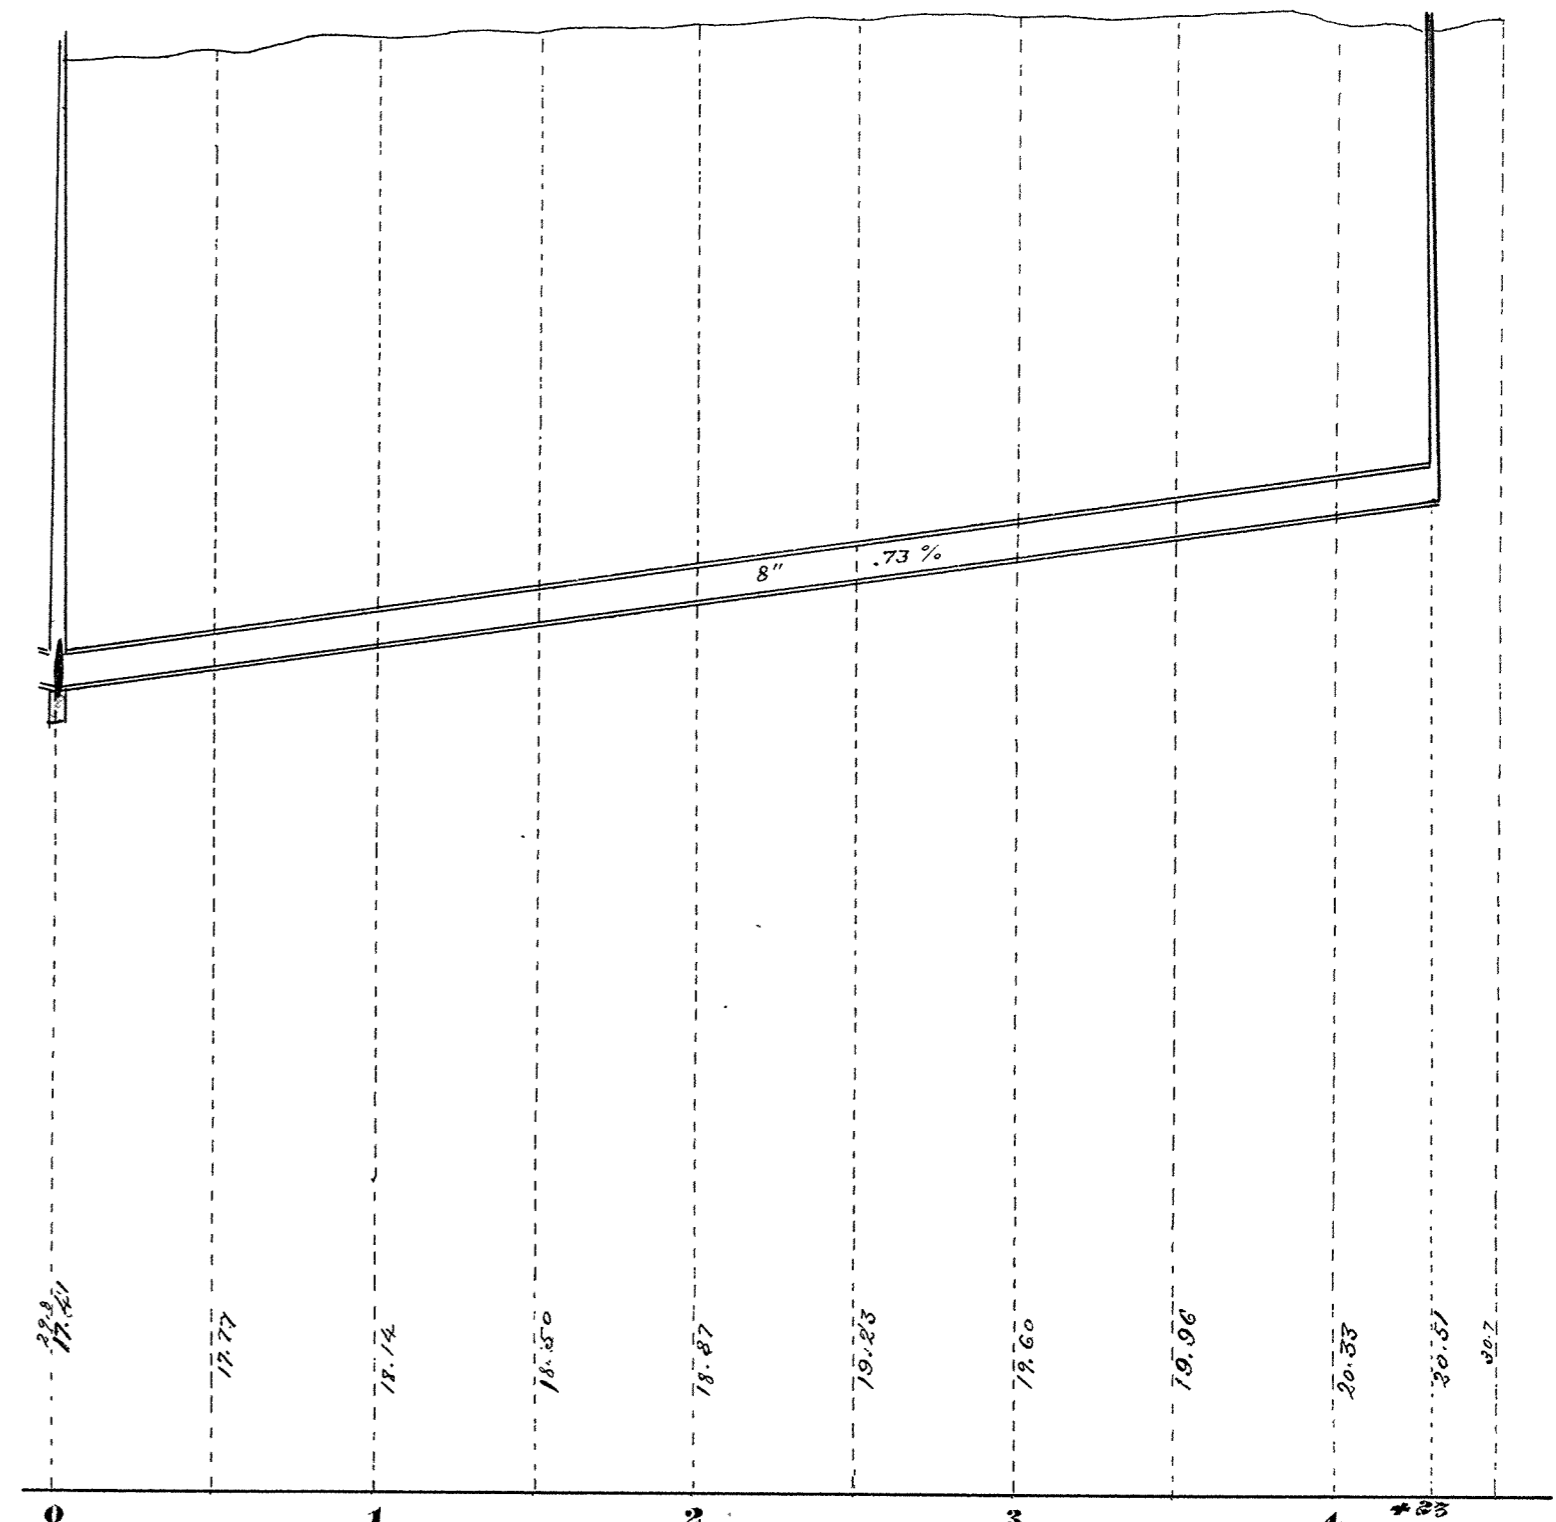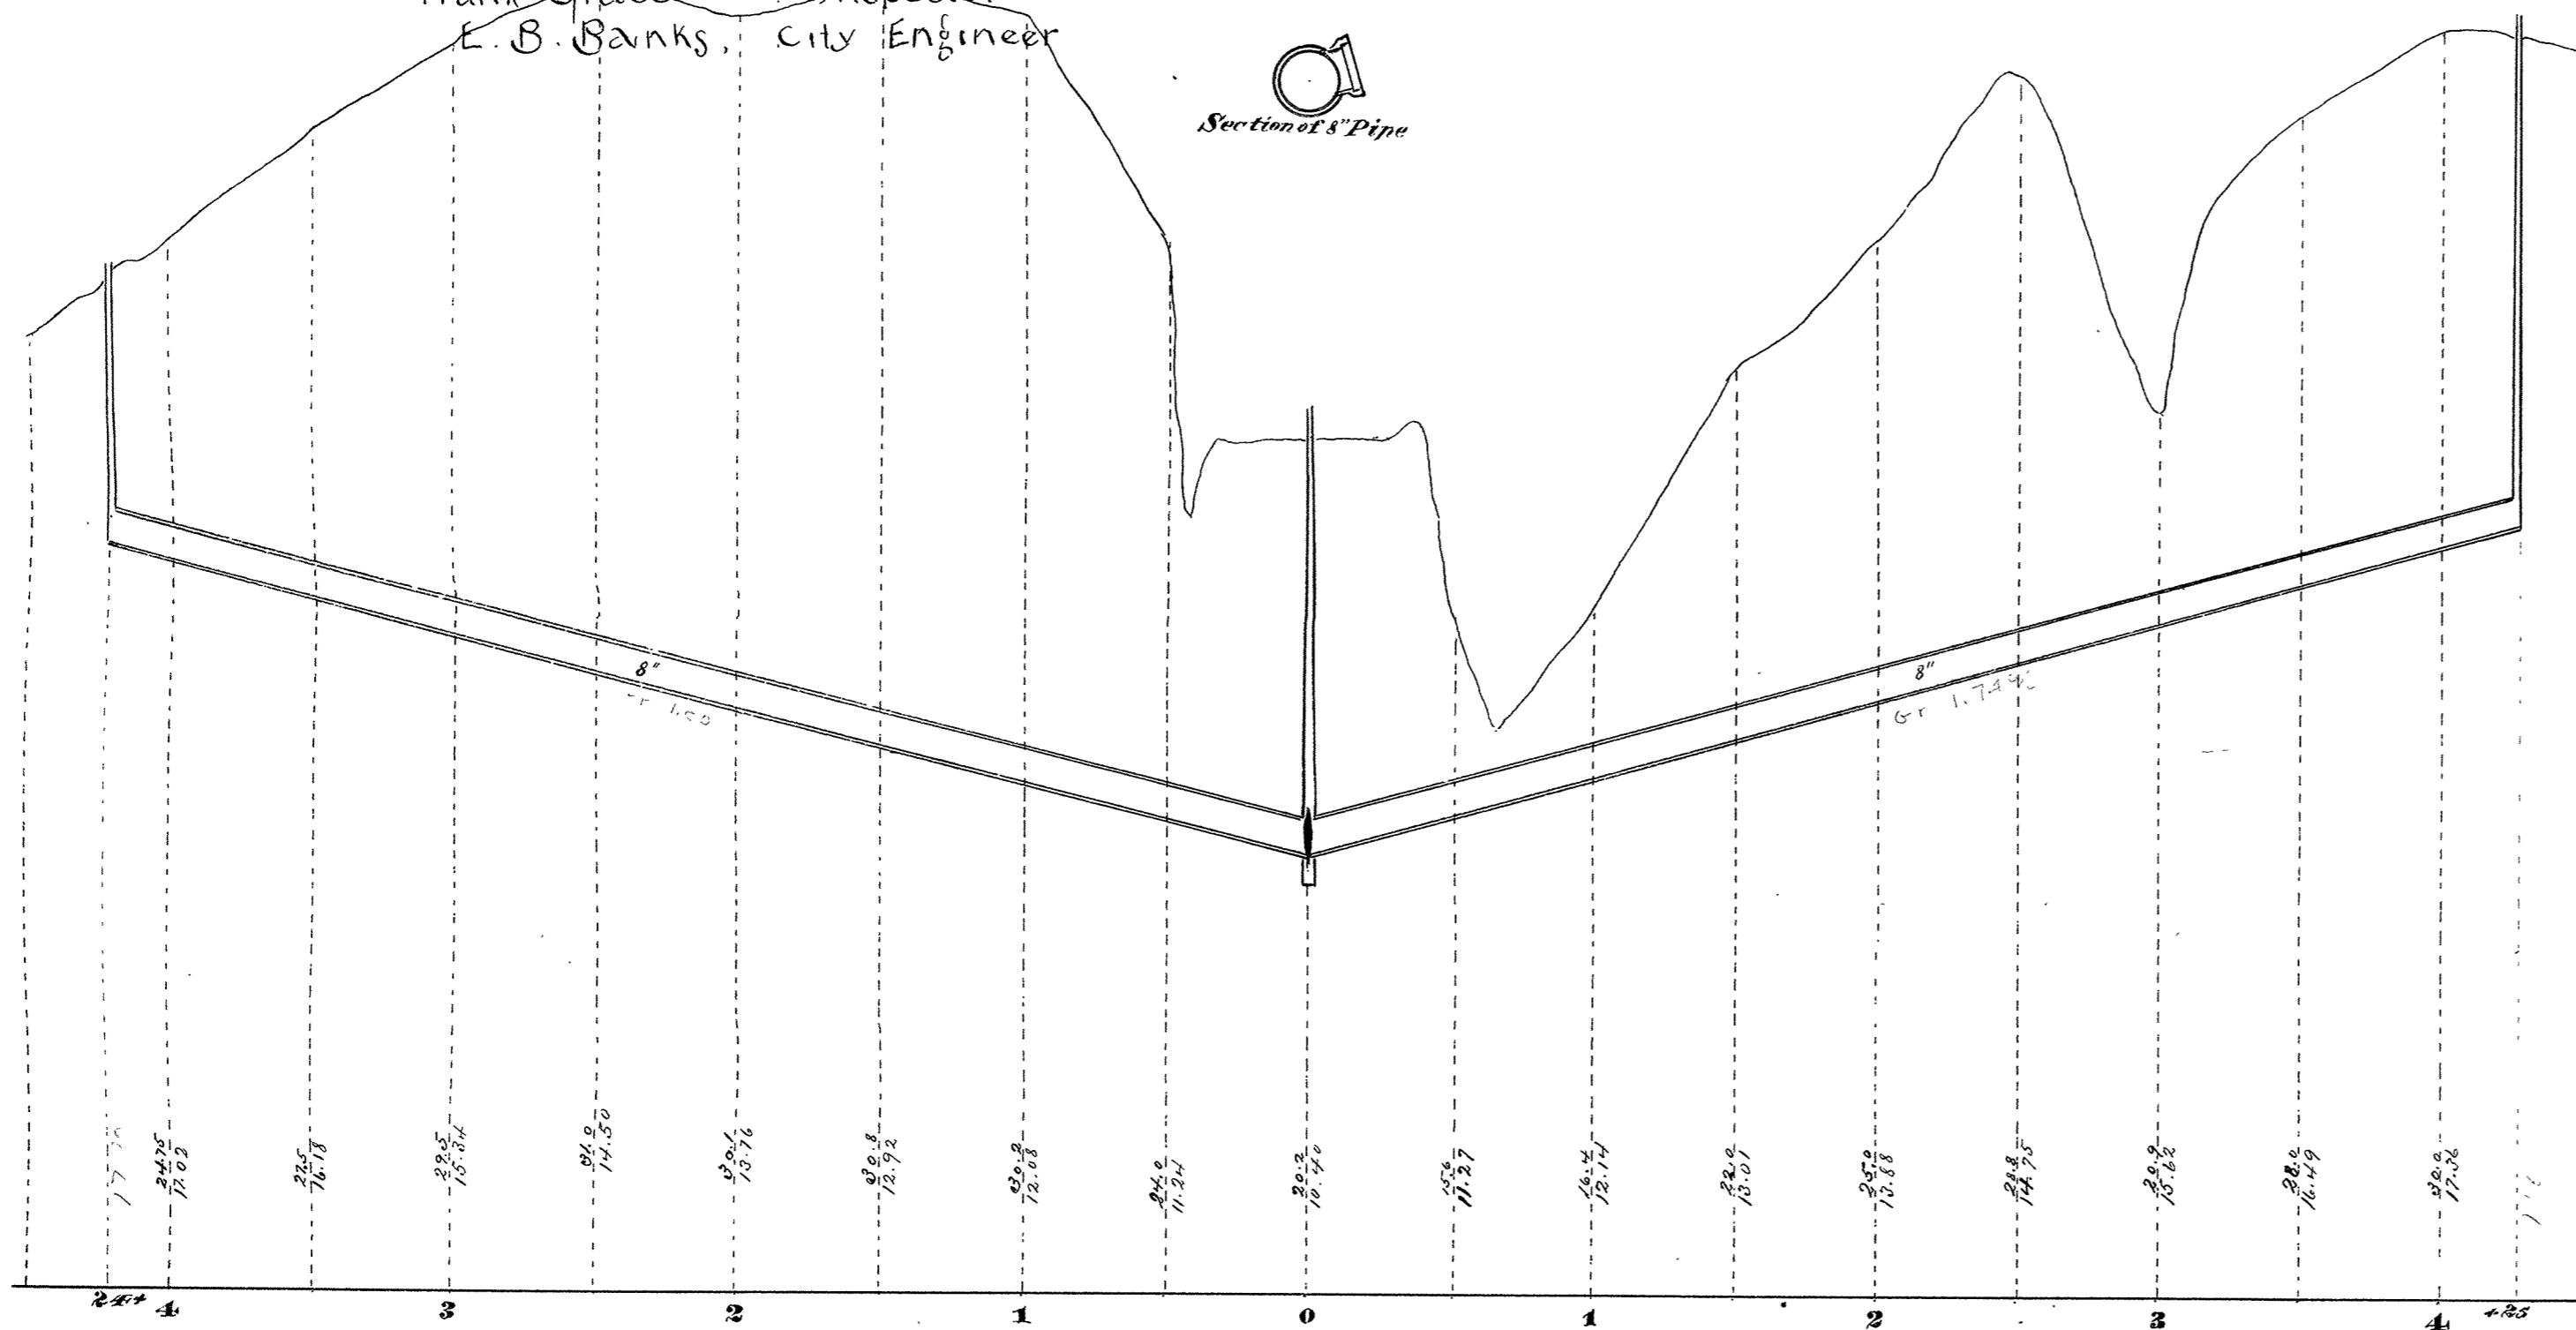

Plan & Profile of Sewer in Alley betw. First and Second St. from Becker to Stinson Ave., also betw. Second and Third St. from Thompson to Stinson Ave.

4-18