




VILLAGE OF SUPERIOR

SEWER PLAN


Contract let July 17, 1888
 completed
 Younggreen & Gleason, Contractor
 Frank Grace, Inspector
 E. B. Banks, Village Engr.

1893

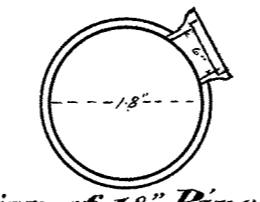

Section of 18" Pipe

Scale: { Horizontal 1" = 60'
 Vertical 1" = 4'
 Section 1" = 2'

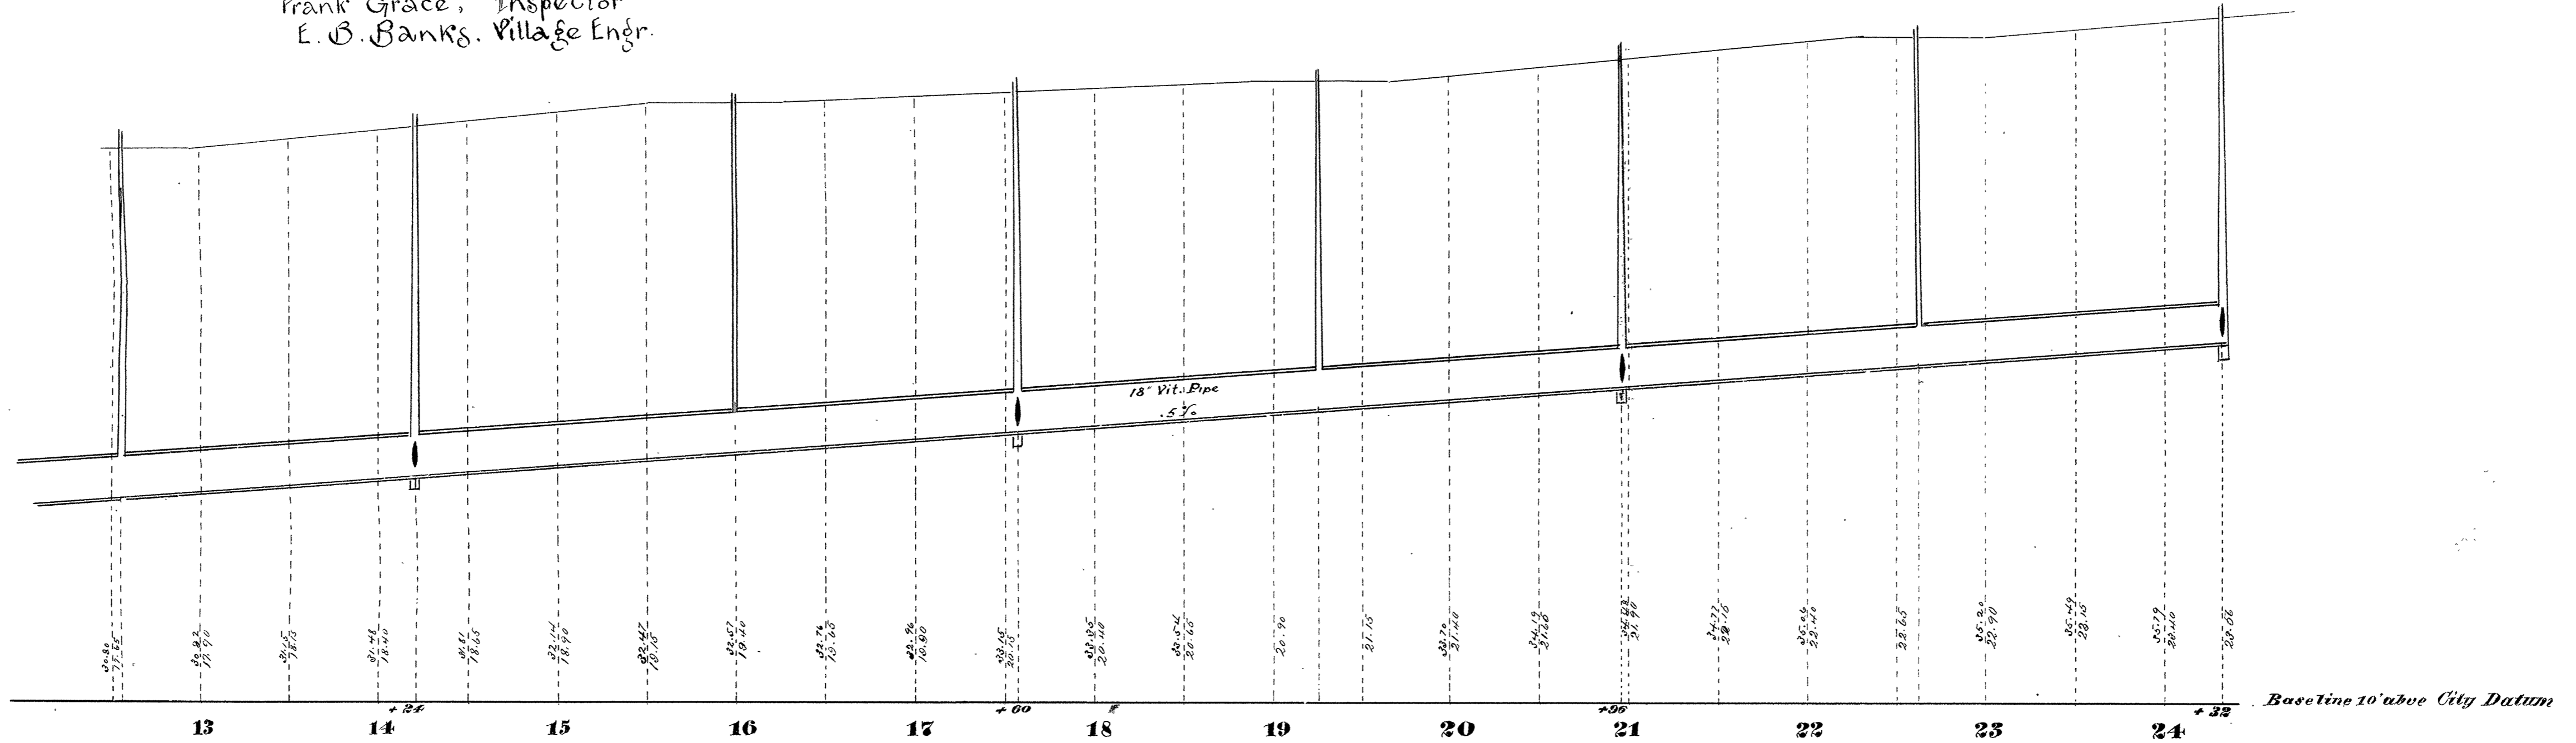

Plan & Profile of Sewer in Thompson Ave. from Third St. to End

4-19