


18 th AVE. E. CARLTON AVE.	W. SECOND ST.																20 th AVE. E. HOLLINSHEAD ST.																																	
	14x50 11x40 11x39	110	114	112	110	108	106	104	102	100	398	396	394	392	390	388		386	9x50	384	382	380	378	376	374	372	370	368	366	364	362	360	358	356	354	4x50	352	350	348	346	344	342	340	338	336	334	332	330	328	326
18 th AVE. E. CARLTON AVE.	W. THIRD ST.																20 th AVE. E. HOLLINSHEAD ST.																																	
	14x50 11x40 11x39	115	113	111	109	107	105	103	101	999	997	995	993	991	989	987		985	9x37	383	381	379	377	375	373	371	369	367	365	363	361	359	357	355	353	4x38	351	349	347	345	343	341	339	337	335	333	331	329	327	325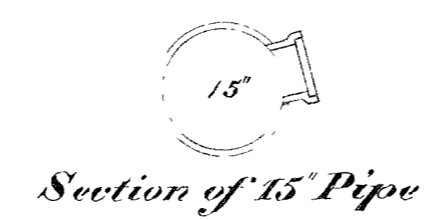
Scale
 Horizontal 60'-1"
 Vertical 4'-1"
 Sections 2'-1"

CITY OF SUPERIOR
SEWER PLAN

Contract let April 3, 1891
 completed Aug 1, 1891
 F. A. Dole. Contractor
 Wm G. Coleman & J. P. Duff. Inspts.
 E. B. Banks. City Engr.

