




Scale: { Horizontal 1" = 60'
Vertical 1" = 5'
Section 1" = 2'

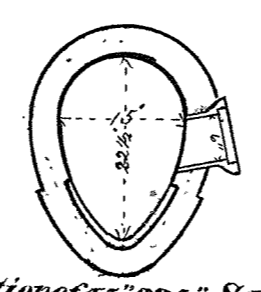

Section of 15 x 22 1/2" Sewer

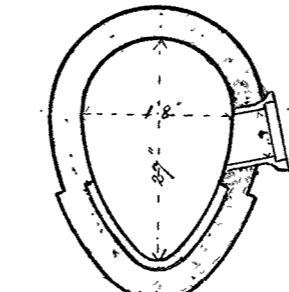

Section of 18 x 27" Sewer

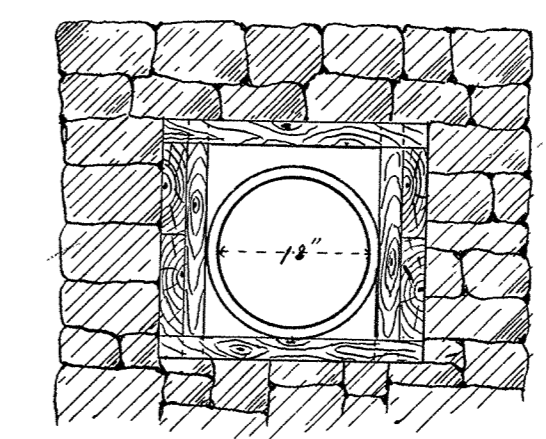


Section of 18" Pipe in Masonry

CITY OF SUPERIOR

SEWER PLAN

Contract let May 25, 1891
completed Aug 8, 1891
White & Co. Contractor
Frank Richardson, Inspector
E. B. Banks, City Engr.

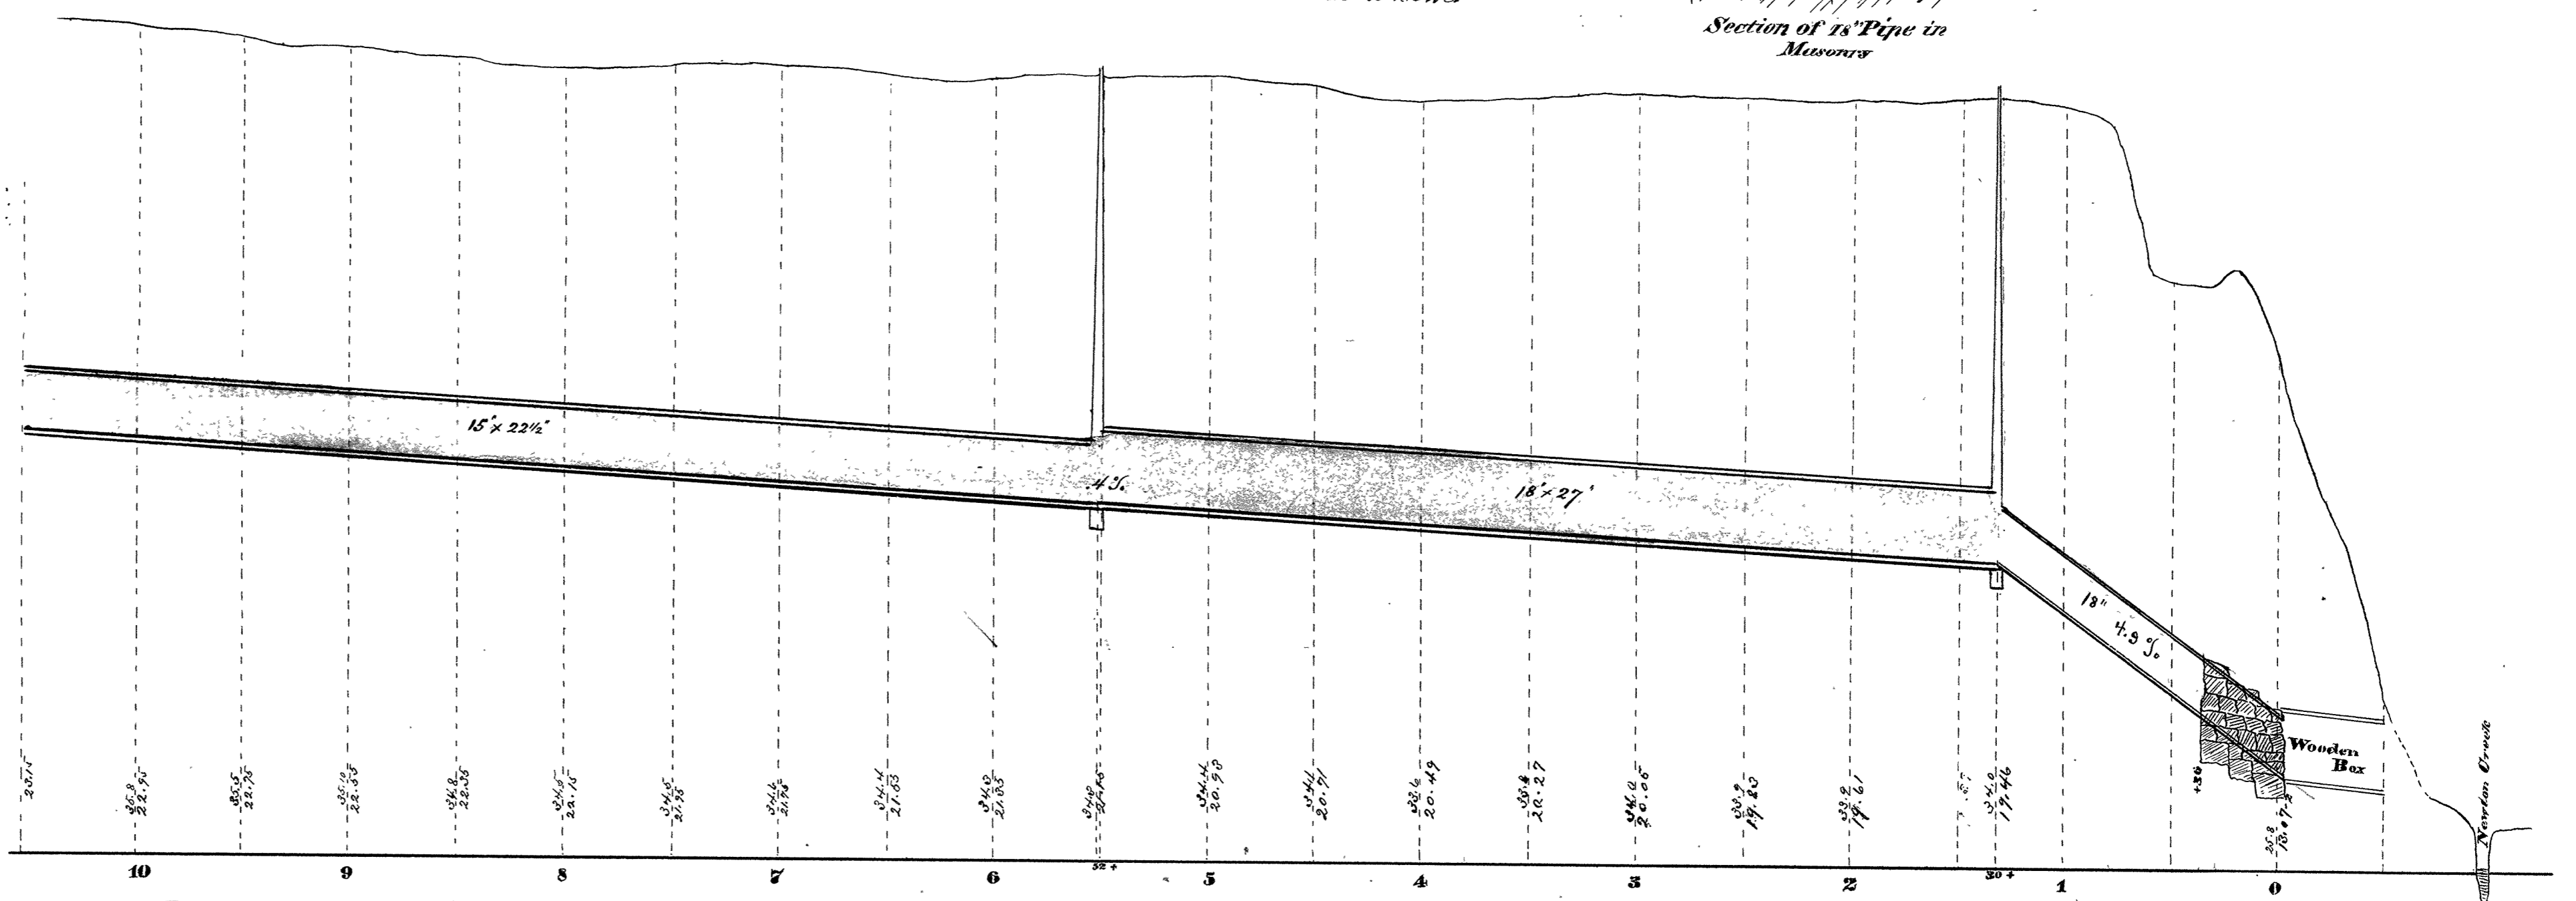

Base line 10ft. above City datum

Plan & Profile of Sewer in Alley betw. W. Seventh & W. Eighth St. from Newton to Thompson Avenue