

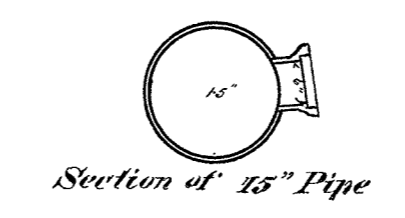


**CITY OF SUPERIOR
SEWER PLAN**

Contract let May 25, 1891.
completed Aug. 8, 1891.
Thos. White & Co., Contractor.
Frank Richardson, Inspector.
E. B. Banks, City Engr.

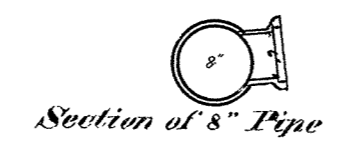

Scale: { Horizontal 1" = 60'
Vertical 1" = 4'
Section 1" = 2'

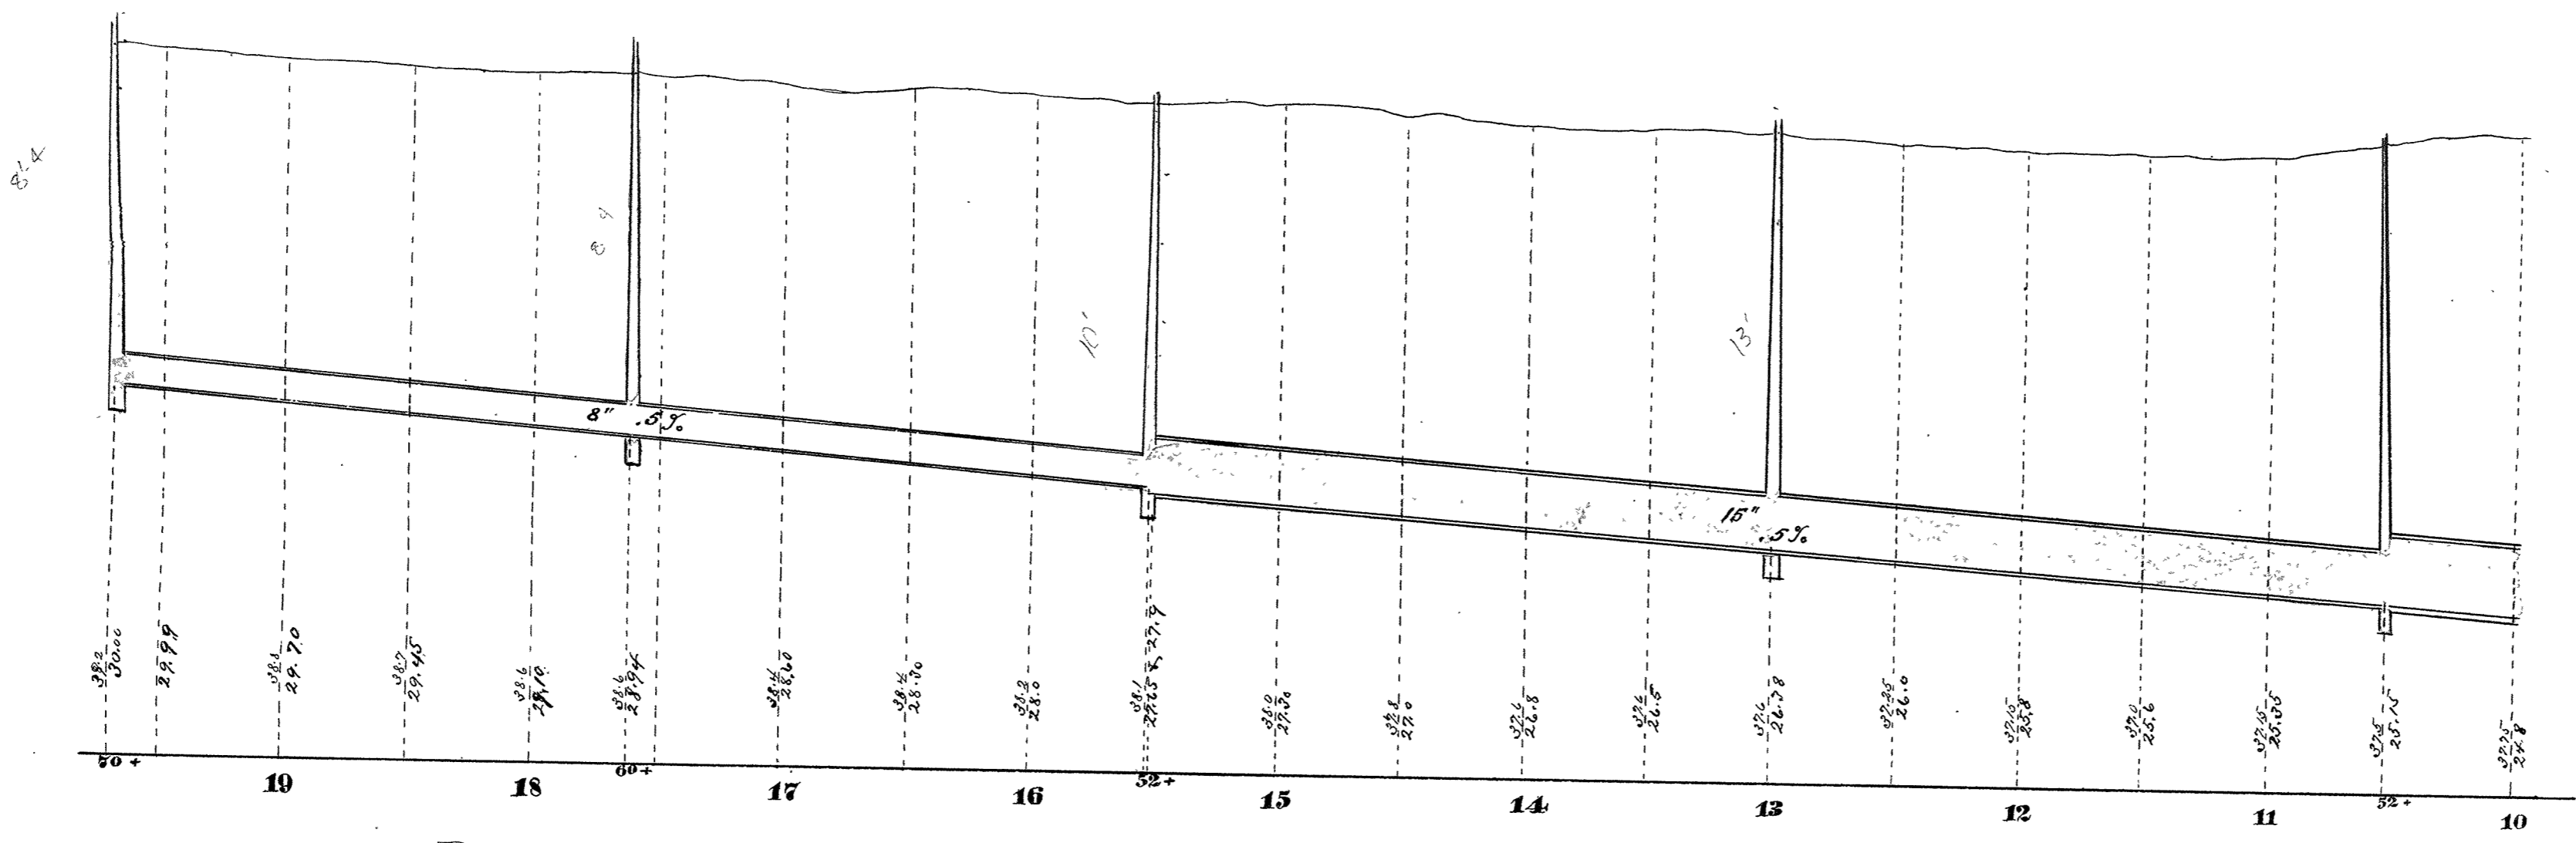

Plan & Profile of Sewer in Alley betw. W. Eighth and W. Ninth Sts. from Thompson to Nettleton Ave.