

CARLTON 16TH AVE. E.

E. W. NINTH ST.

U. S. P. M. & O. Ry.

ST.

ST. JOHN 19TH AVE. E.


HOLLINSHEAD 20TH AVE. E.

W. TENTH ST.

ST.




Section of 8" Pipe

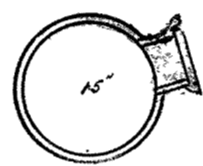

Section of 15" Pipe

Scale: { Horizontal 1" = 60'
Vertical 1" = 4'
Section 1" = 2'

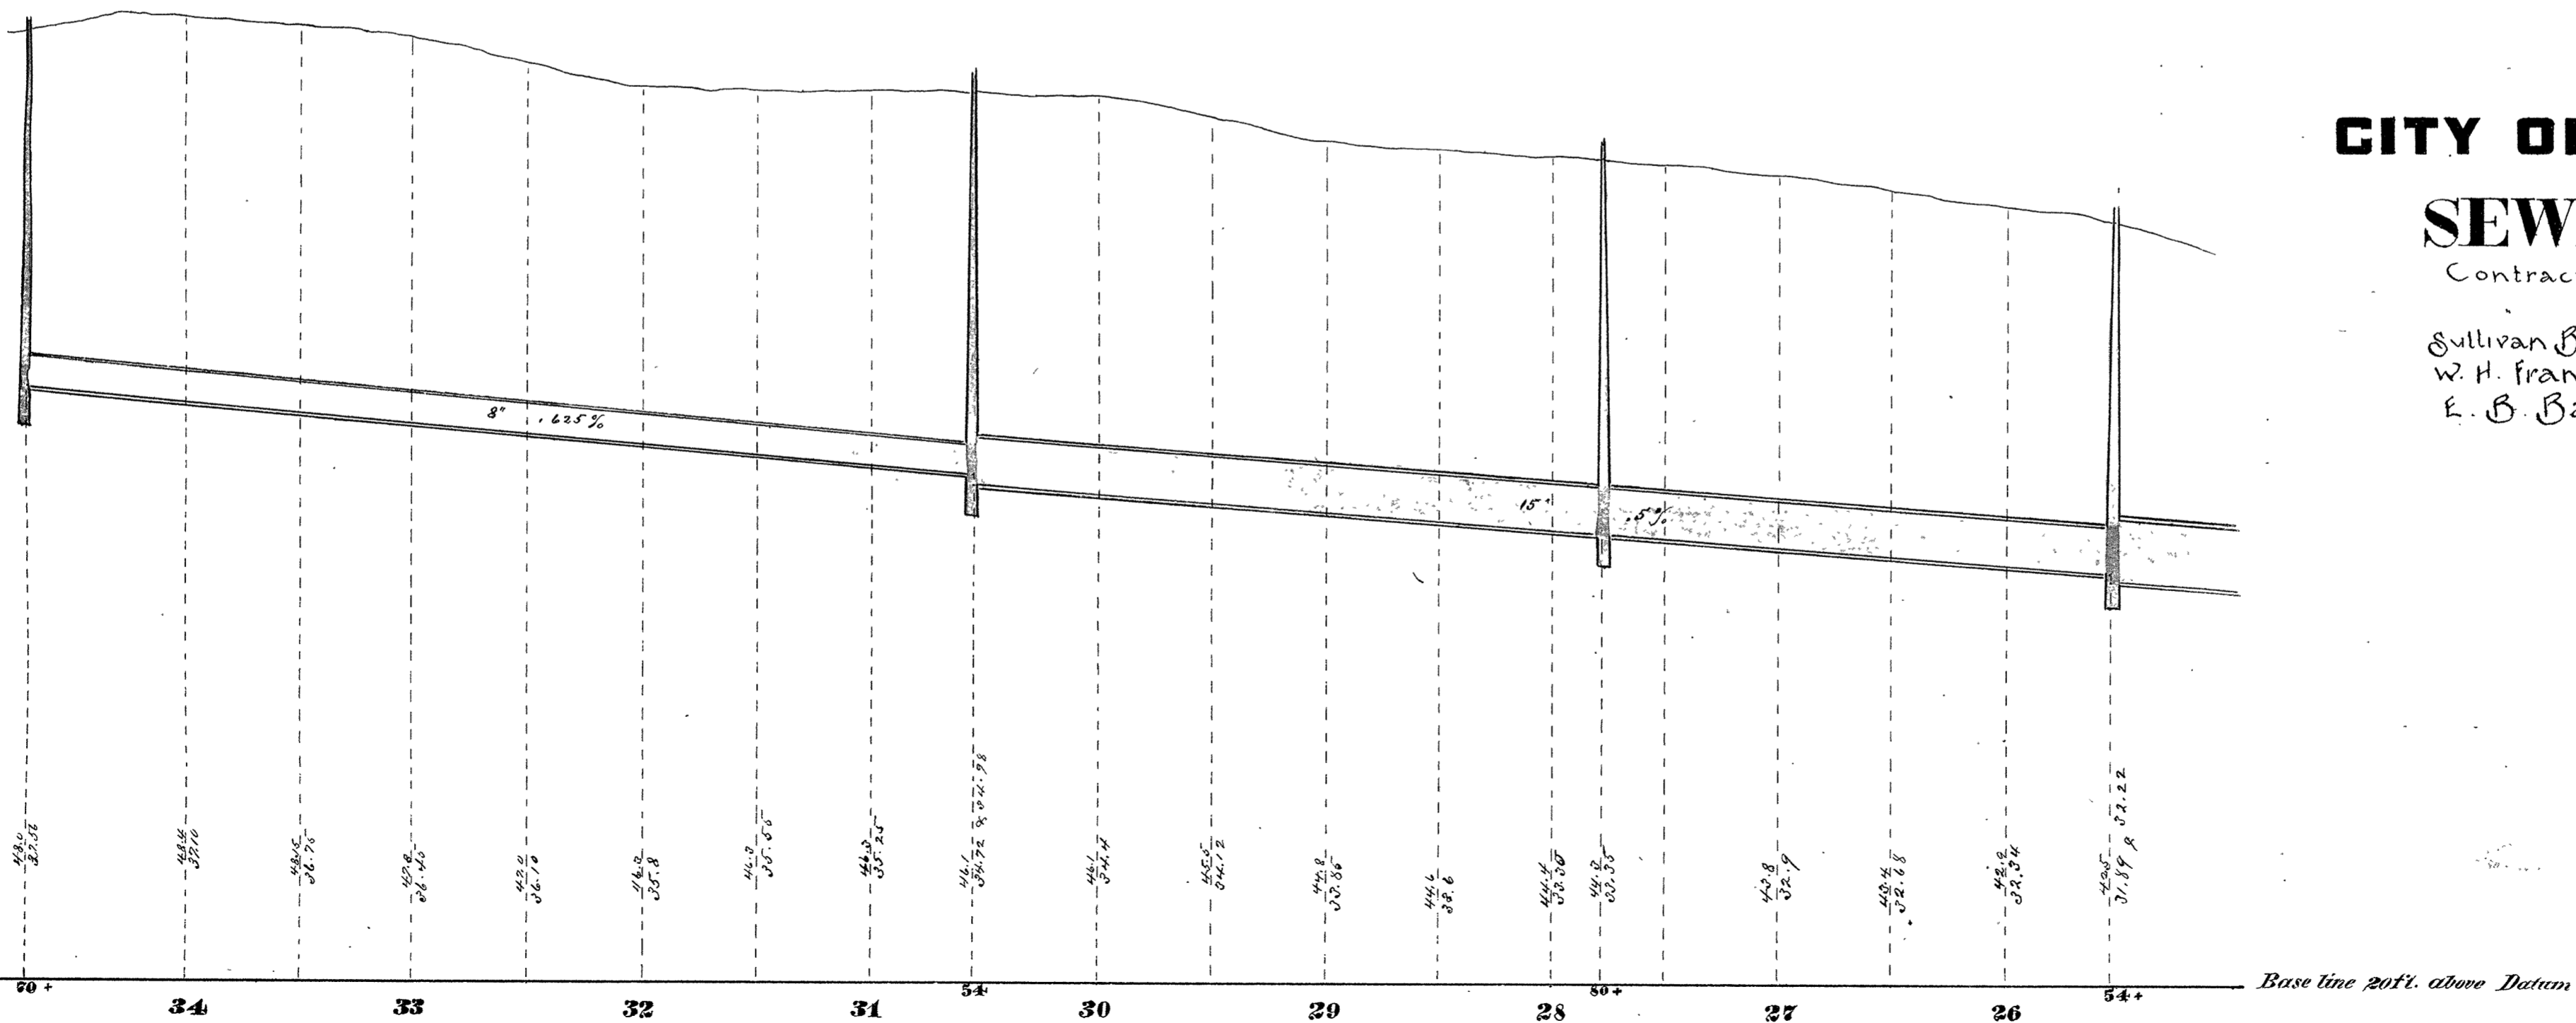

Plan & Profile of Sewer in Alley betw. W. Ninth & Tenth Sts. from Hollinshead to Carlton Ave.

CITY OF SUPERIOR
SEWER PLAN

Contract let July 1, 1890
completed Aug 4, 1891
Sullivan Bros., Contractor. Assigned to A. Dole
W. H. France, Inspector
E. B. Banks, City Engr.

4-25