
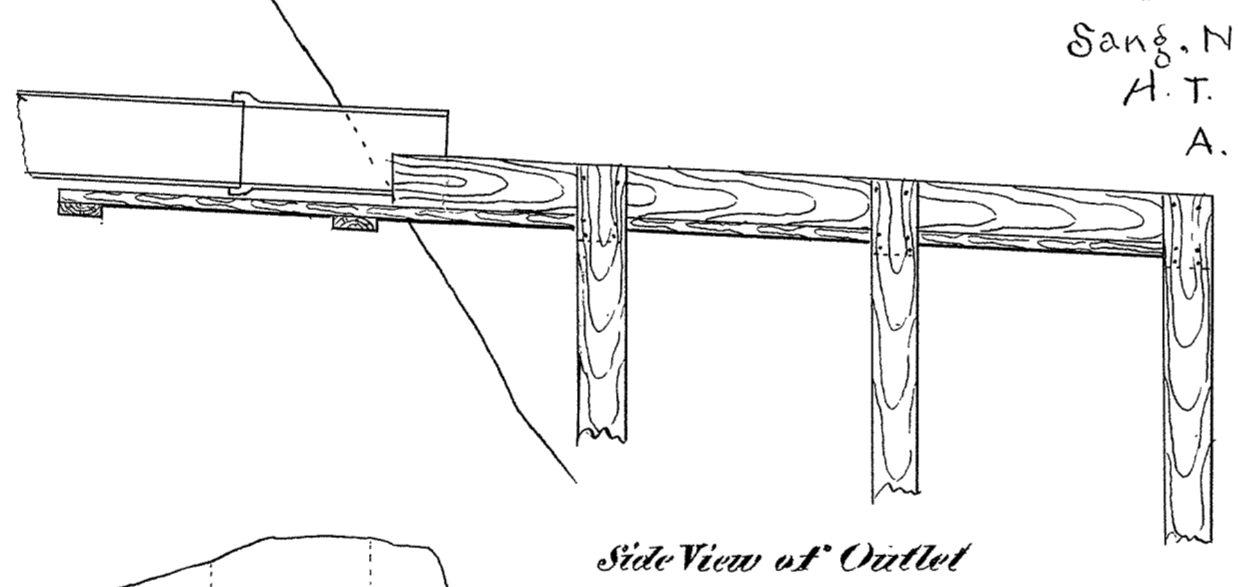
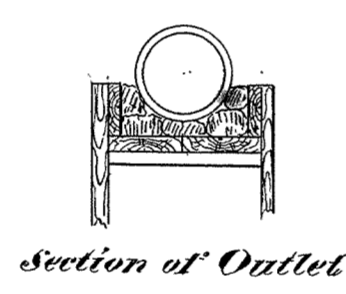


NOTE: THIS SECTION OF 10" SANITARY SEWER WAS REPLACED UNDER CITY CONTRACT BY D.L. JOHNSON & SONS CONSTRUCTION CO. IN AUG. 1973

CITY OF SUPERIOR SEWER PLAN

Contract let April 20, 1893
 completed July 1, 1893
 Sang. Nicholson & Co., Contractor
 H. T. Hare, Inspector
 A. J. Thomas, City Engr.

CONSTRUCTED BY CITY OF SUPERIOR SEWER DEPT. COMPLETED AUG. 1, 1934

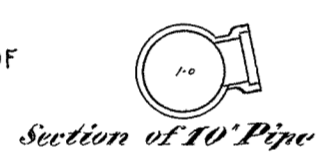

CONTRACT No 1511.
 Contract let Apr. 3, 1916
 Contract completed _____
 Smith Brothers Co. Contractor.
 J.B. Graham Inspector.
 E.B. Banks City Engineer.

CONTRACT No 1111
 Contract let, Aug. 14, 1908.
 Contract completed, Nov. 17, 1908.
 C. Skamser, Contractor.
 A. Solin, Inspector.
 E. B. Banks, City Engineer.

