
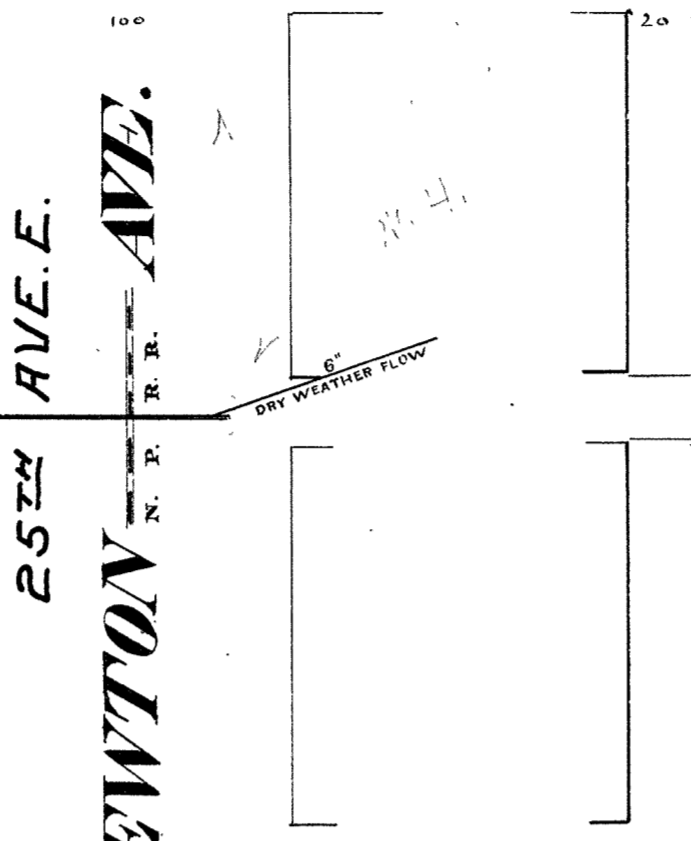


W. THIRD ST.

ST.

W. FOURTH ST.

ST.

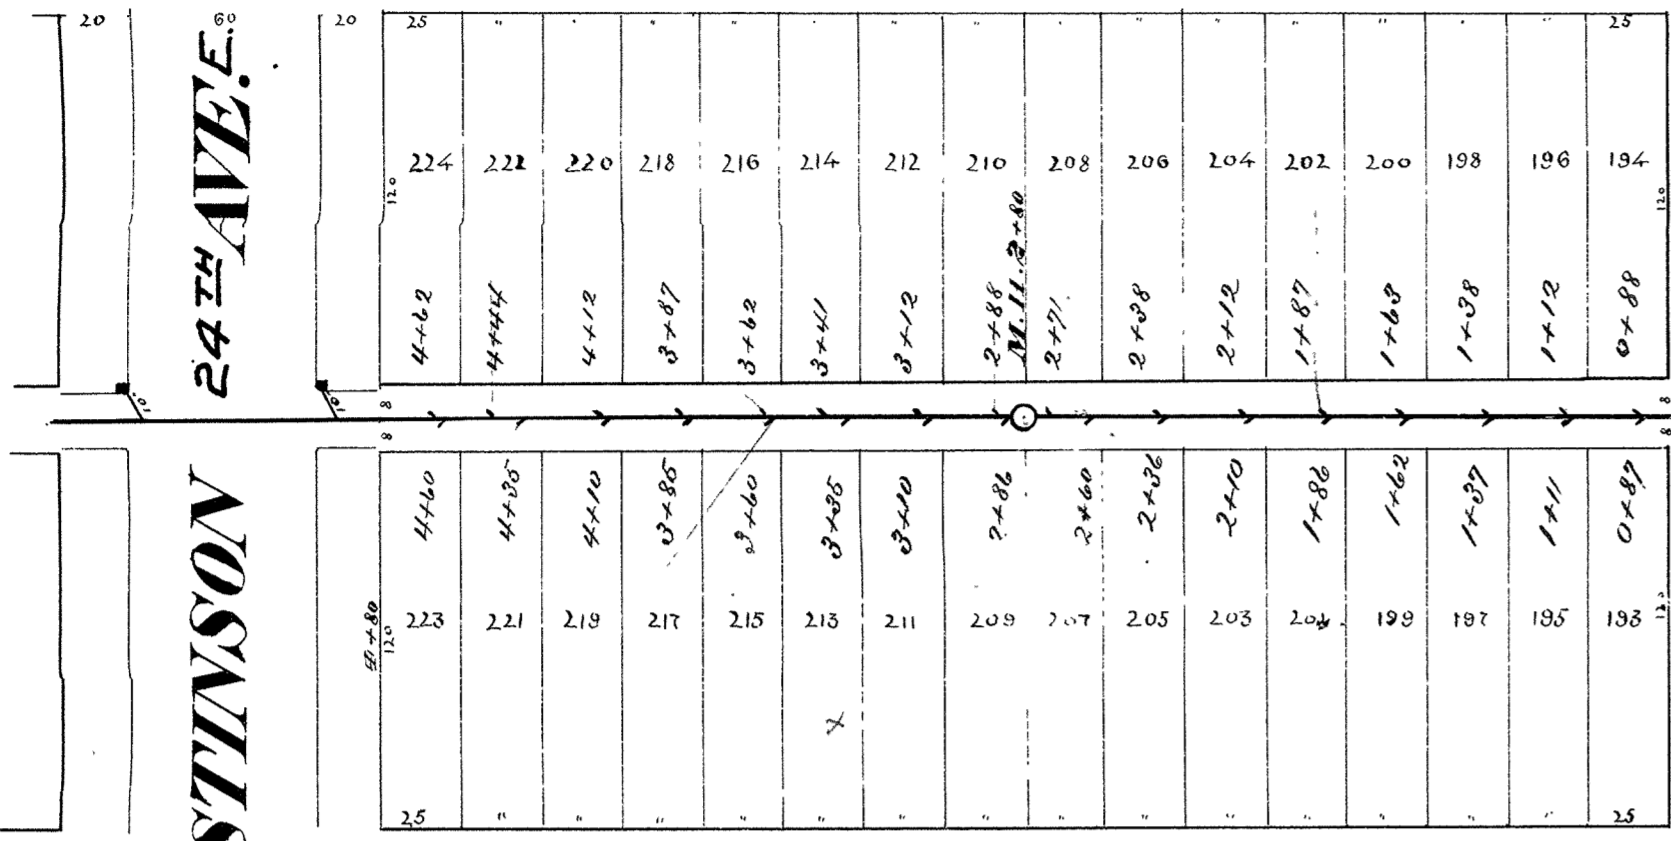

W. FOURTH ST.

ST.

W. FIFTH ST.

ST.

STINSON


25th AVE. E.

NEWTON N. P. R. R.

STINSON

NEWTON

1893

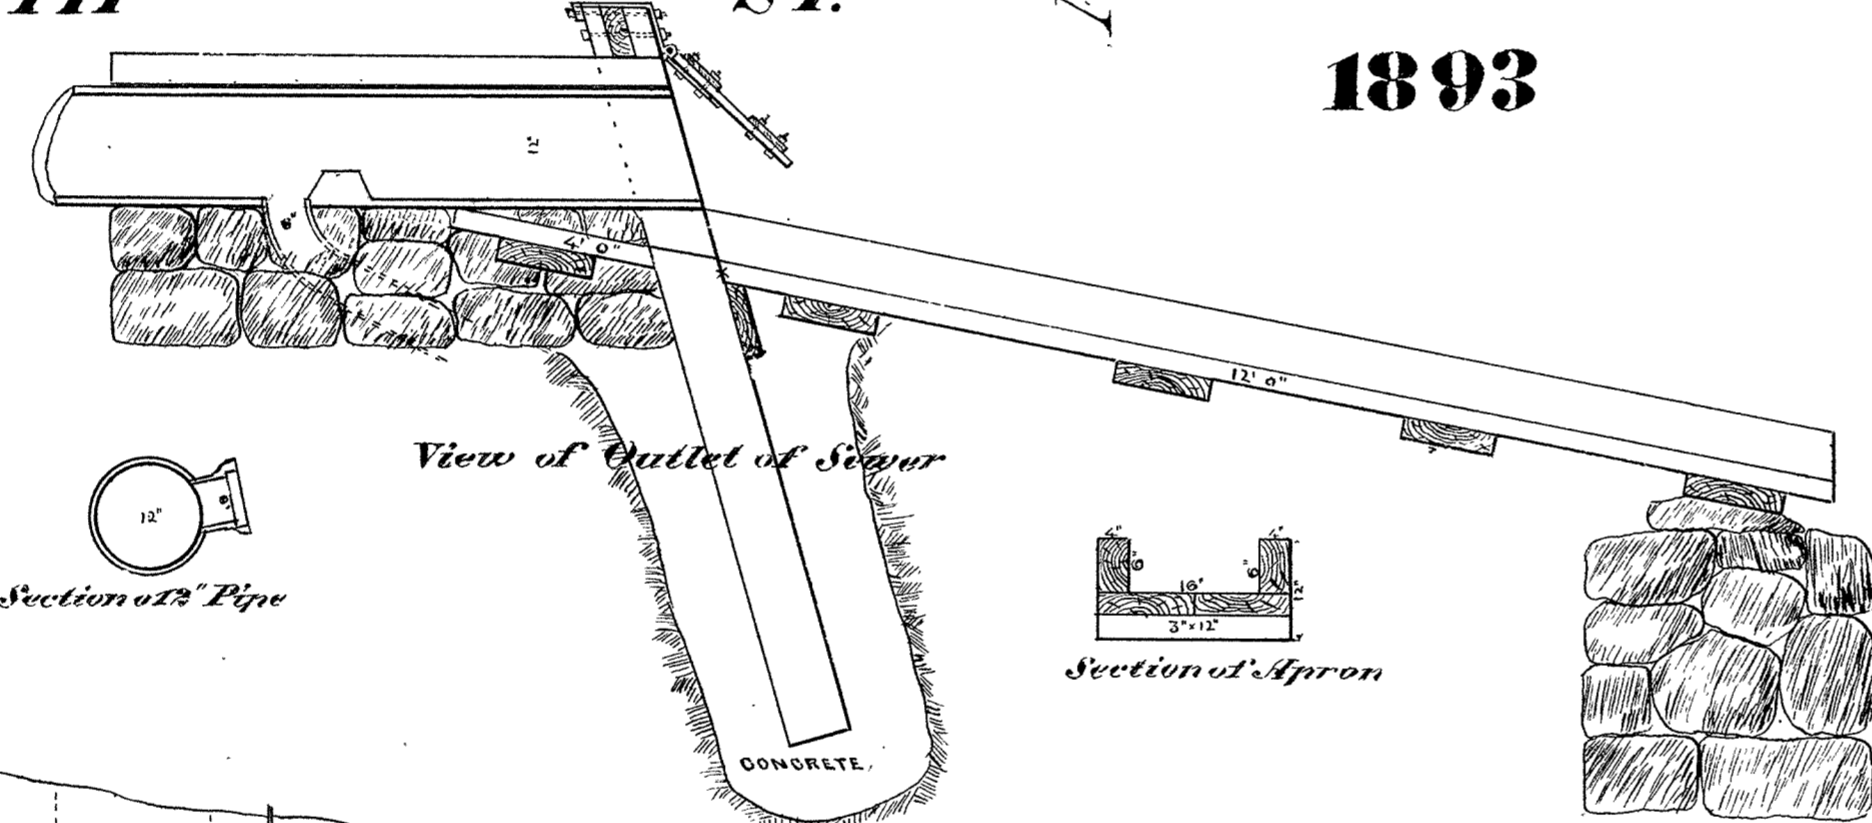


Scale: Horizontal, 1 inch = 60 ft.  
Vertical 1" = 4"  
Section 1" = 2"


CITY OF SUPERIOR

SEWER PLAN

Contract (3rd 4th) let Aug. 21, 1891  
completed Sept. 19, 1891  
W.C. Sullivan, Contractor  
West & Richardson, Inspector  
E. B. Banks, City Engineer  
Contract (4th 5th) let April 20, 1893  
completed July 7, 1893  
Sang, Nicholson & Co., Contractor  
H. T. Hare, Inspector  
A. T. Thomas, City Engineer

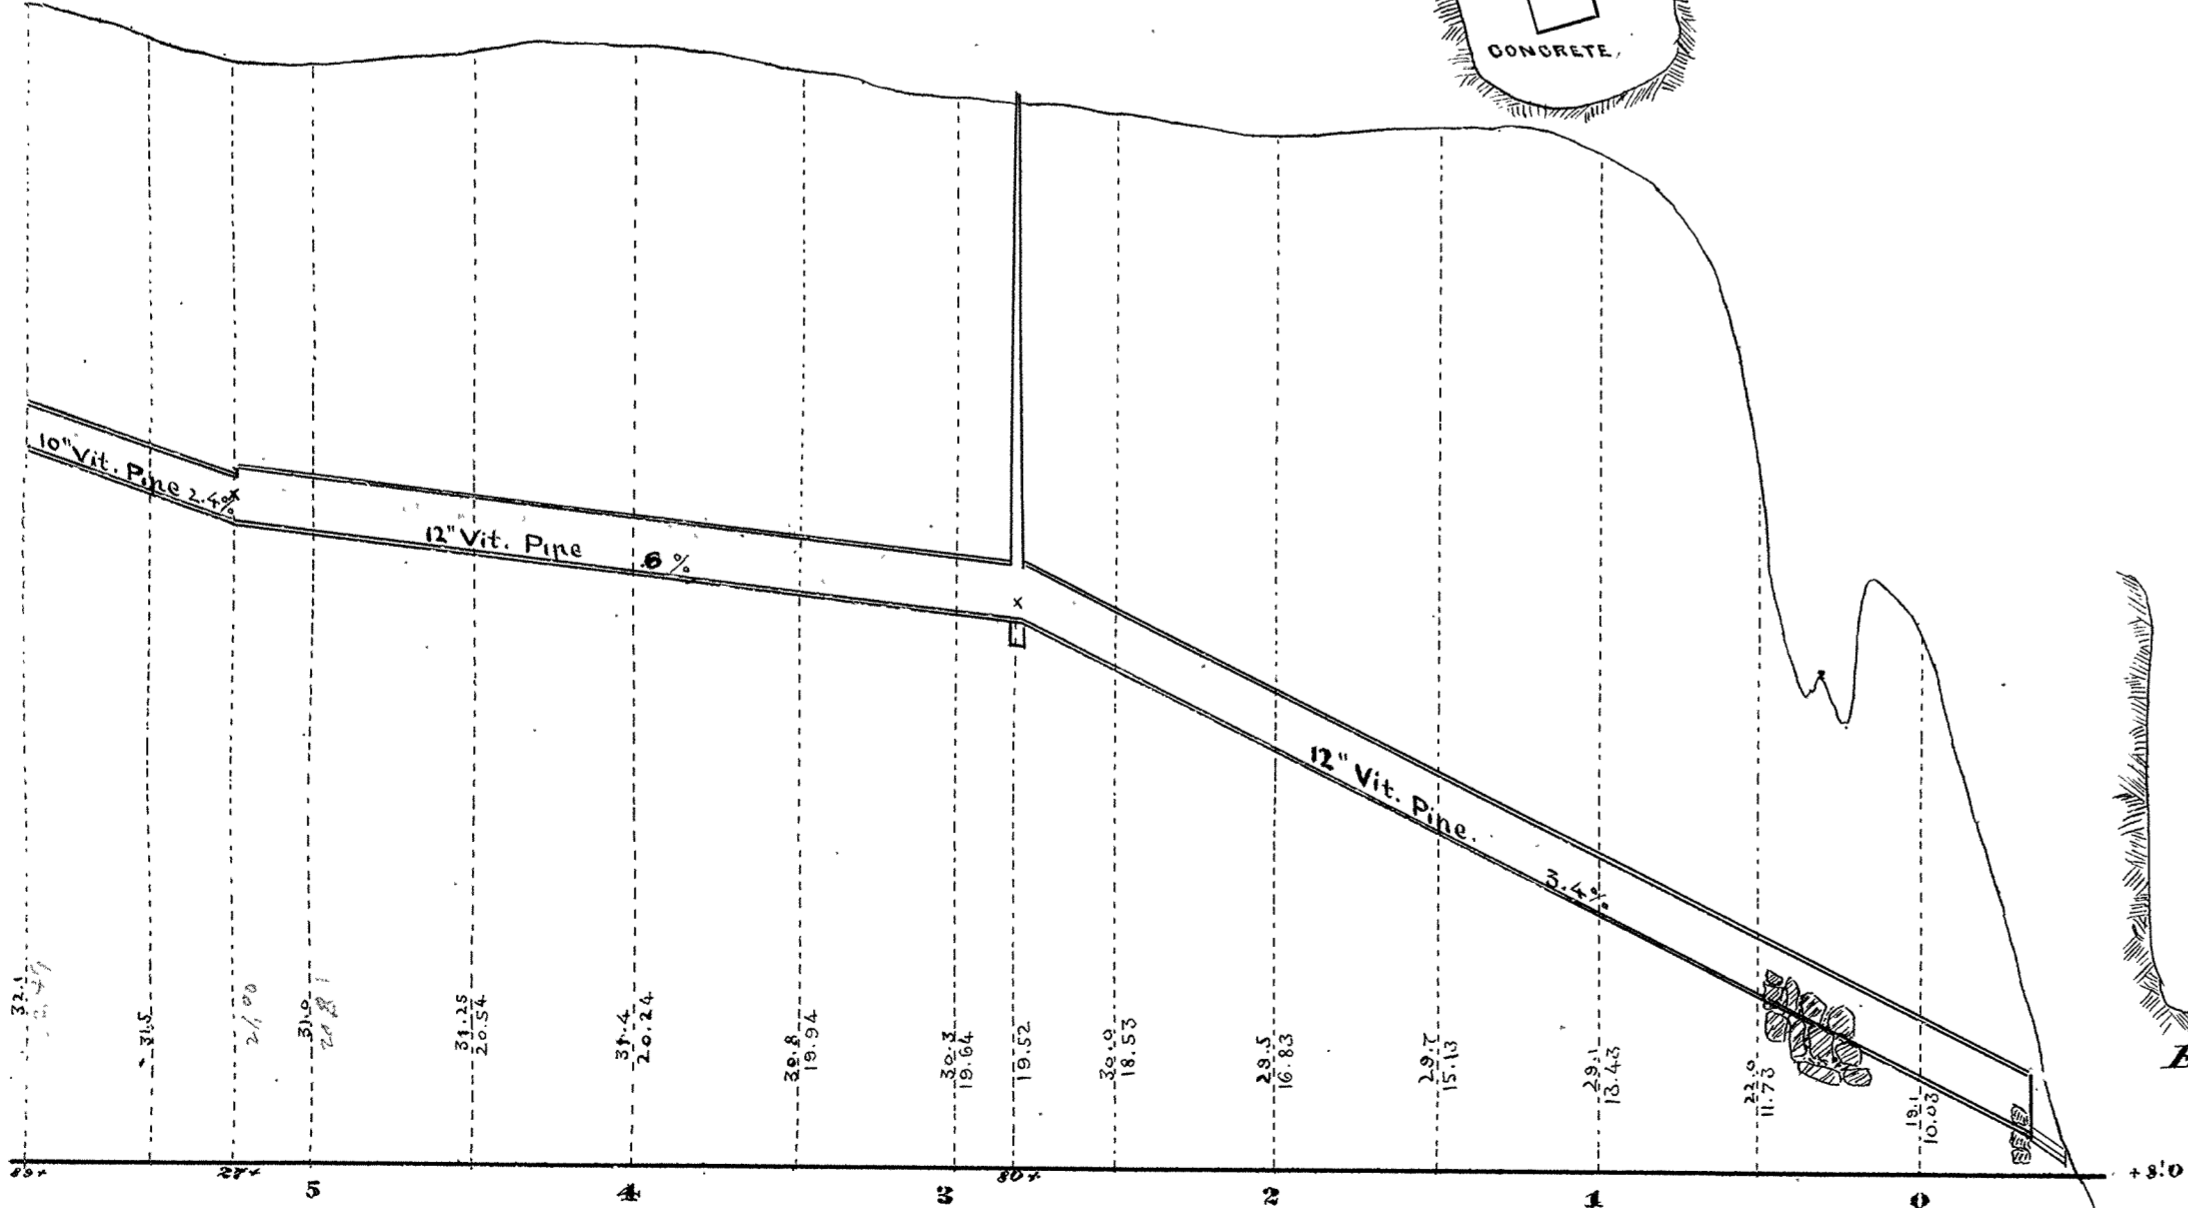

Plan & Profile of Sewer in Alley betw. 3rd & 4th St.

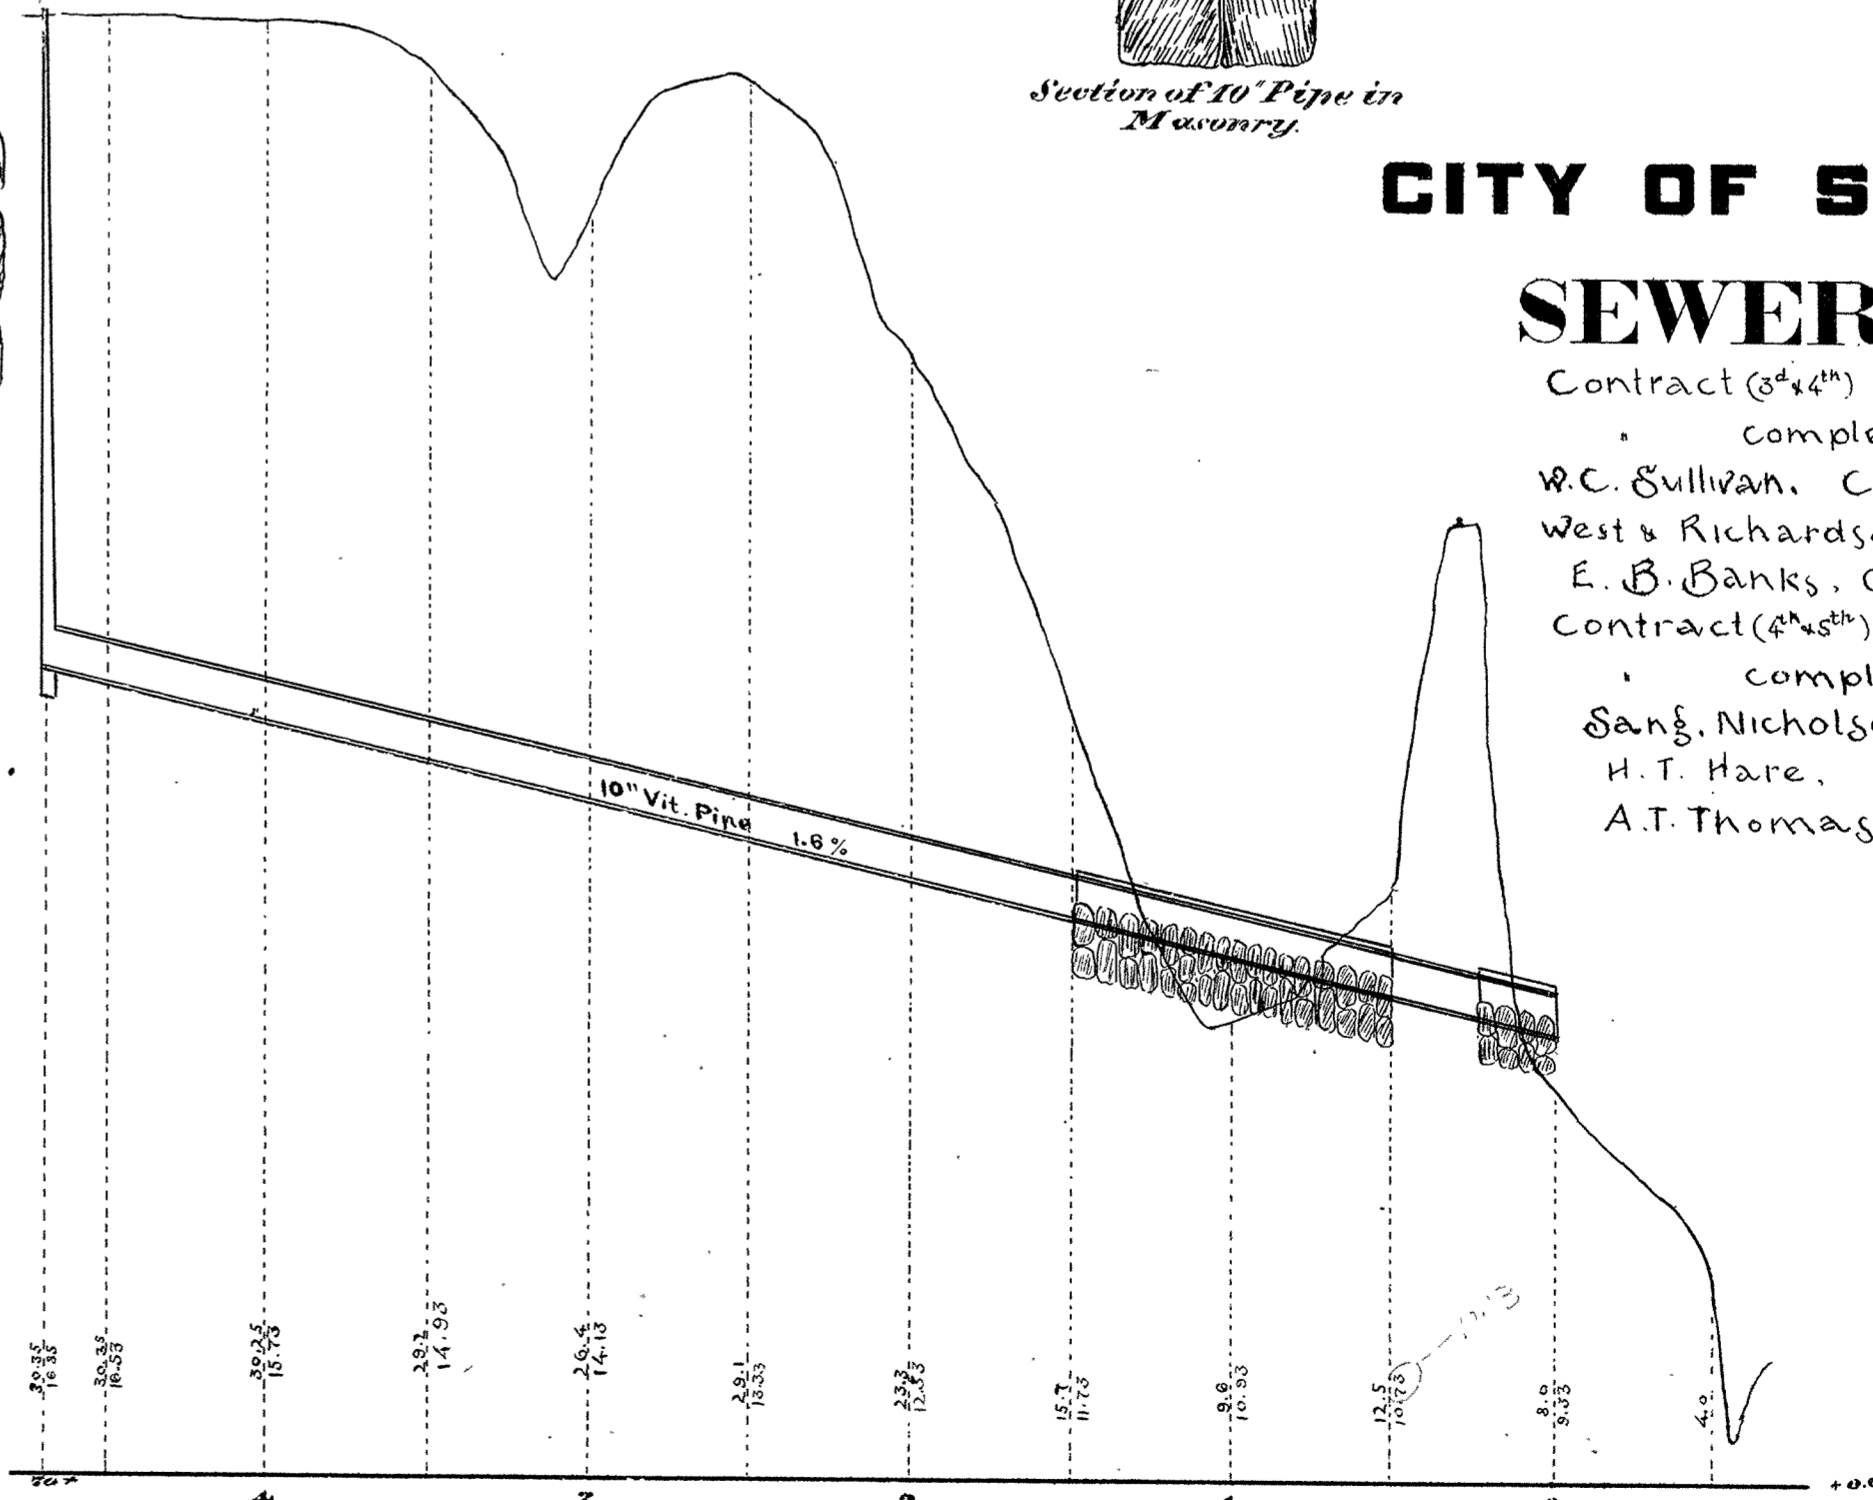

Plan & Profile of Sewer in Alley betw. 4th & 5th Sts.

4-29