

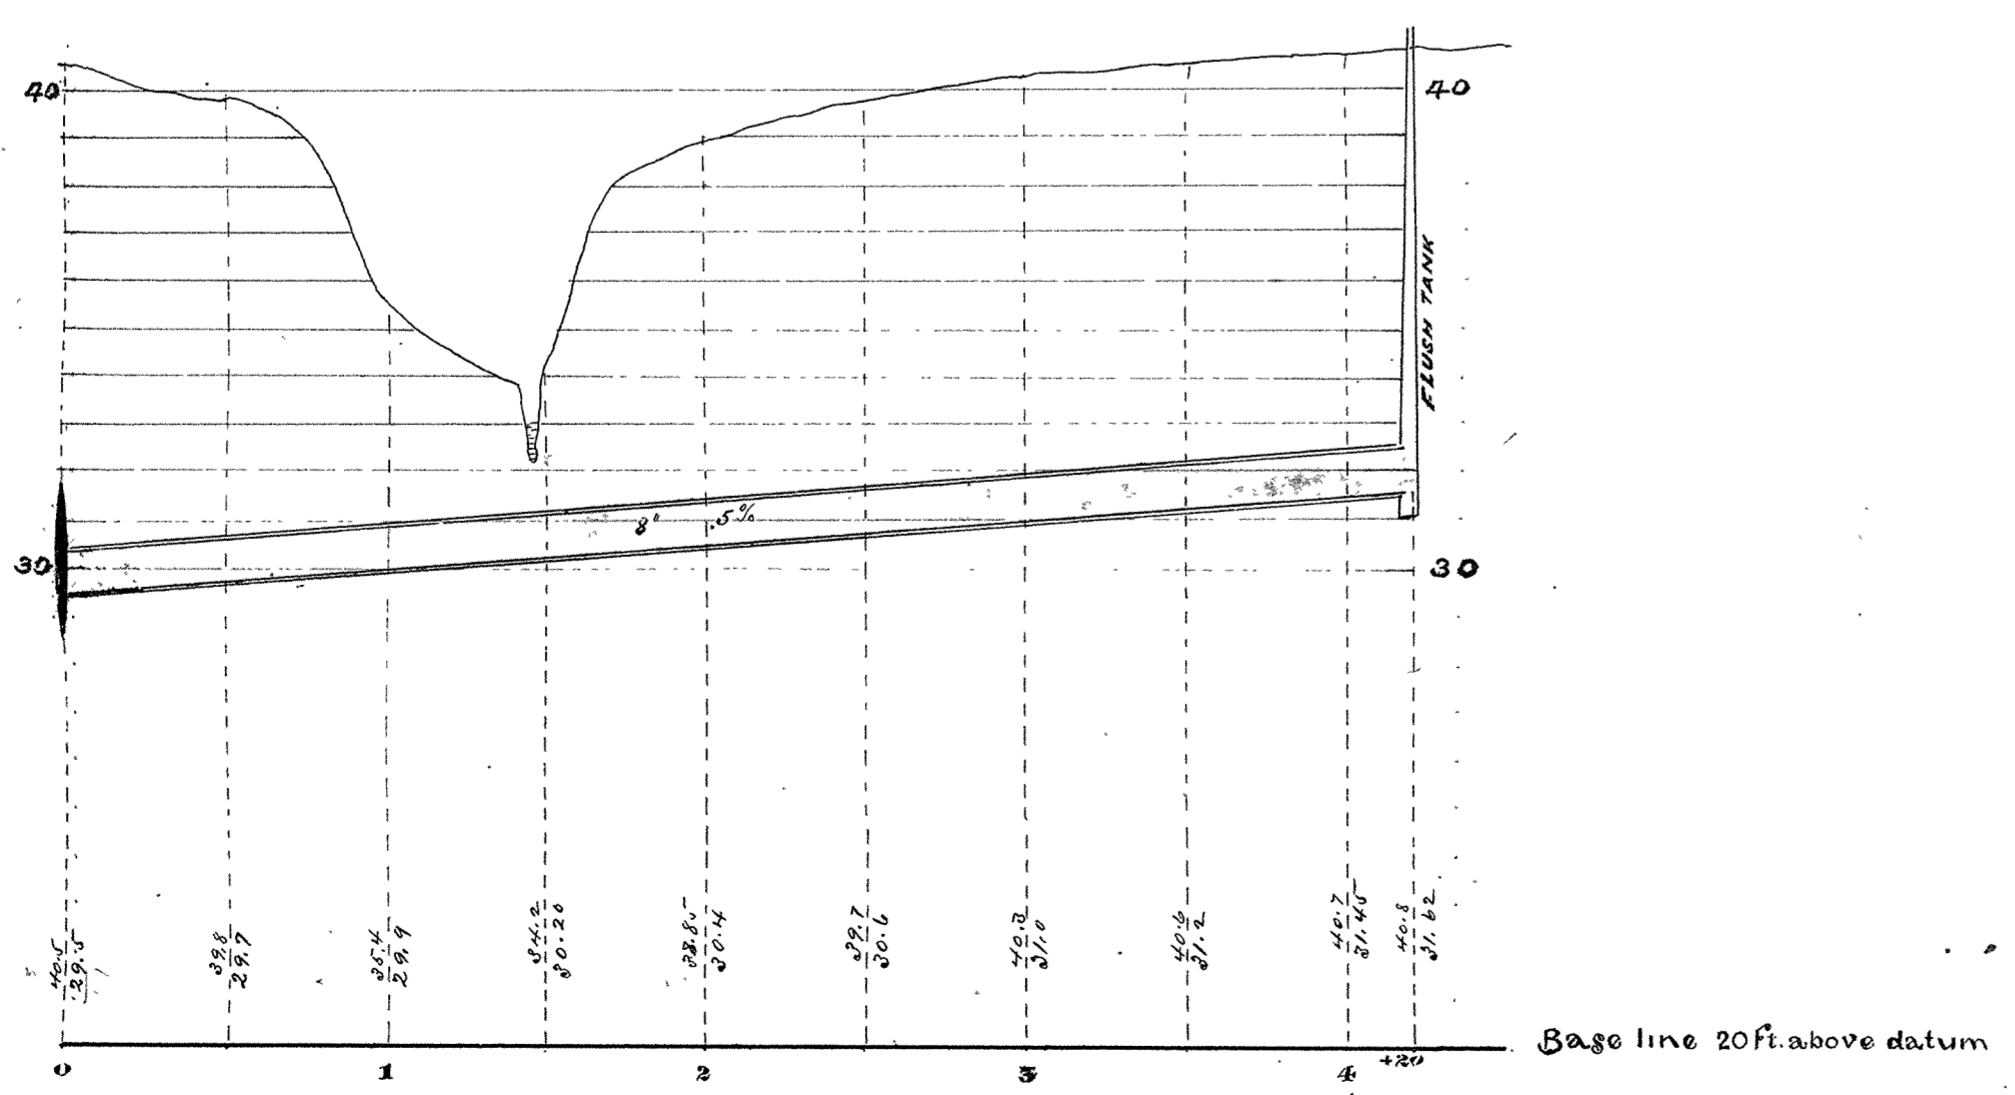


CITY OF SUPERIOR
SEWER PLAN
 Contract let July 1, 1890
 completed Aug. 4, 1891
 Sullivan Bros. Contractor. Assigned to F.A. Dole
 Coleman. Inspector
 E. B. Banks. City Engineer

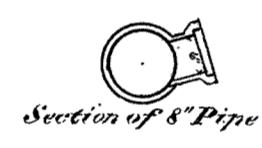


Plan & Profile of Sewer in Alley betw. W. 12th and W. 11th Streets

19th AVE. E.
 ST JOHN AVE.

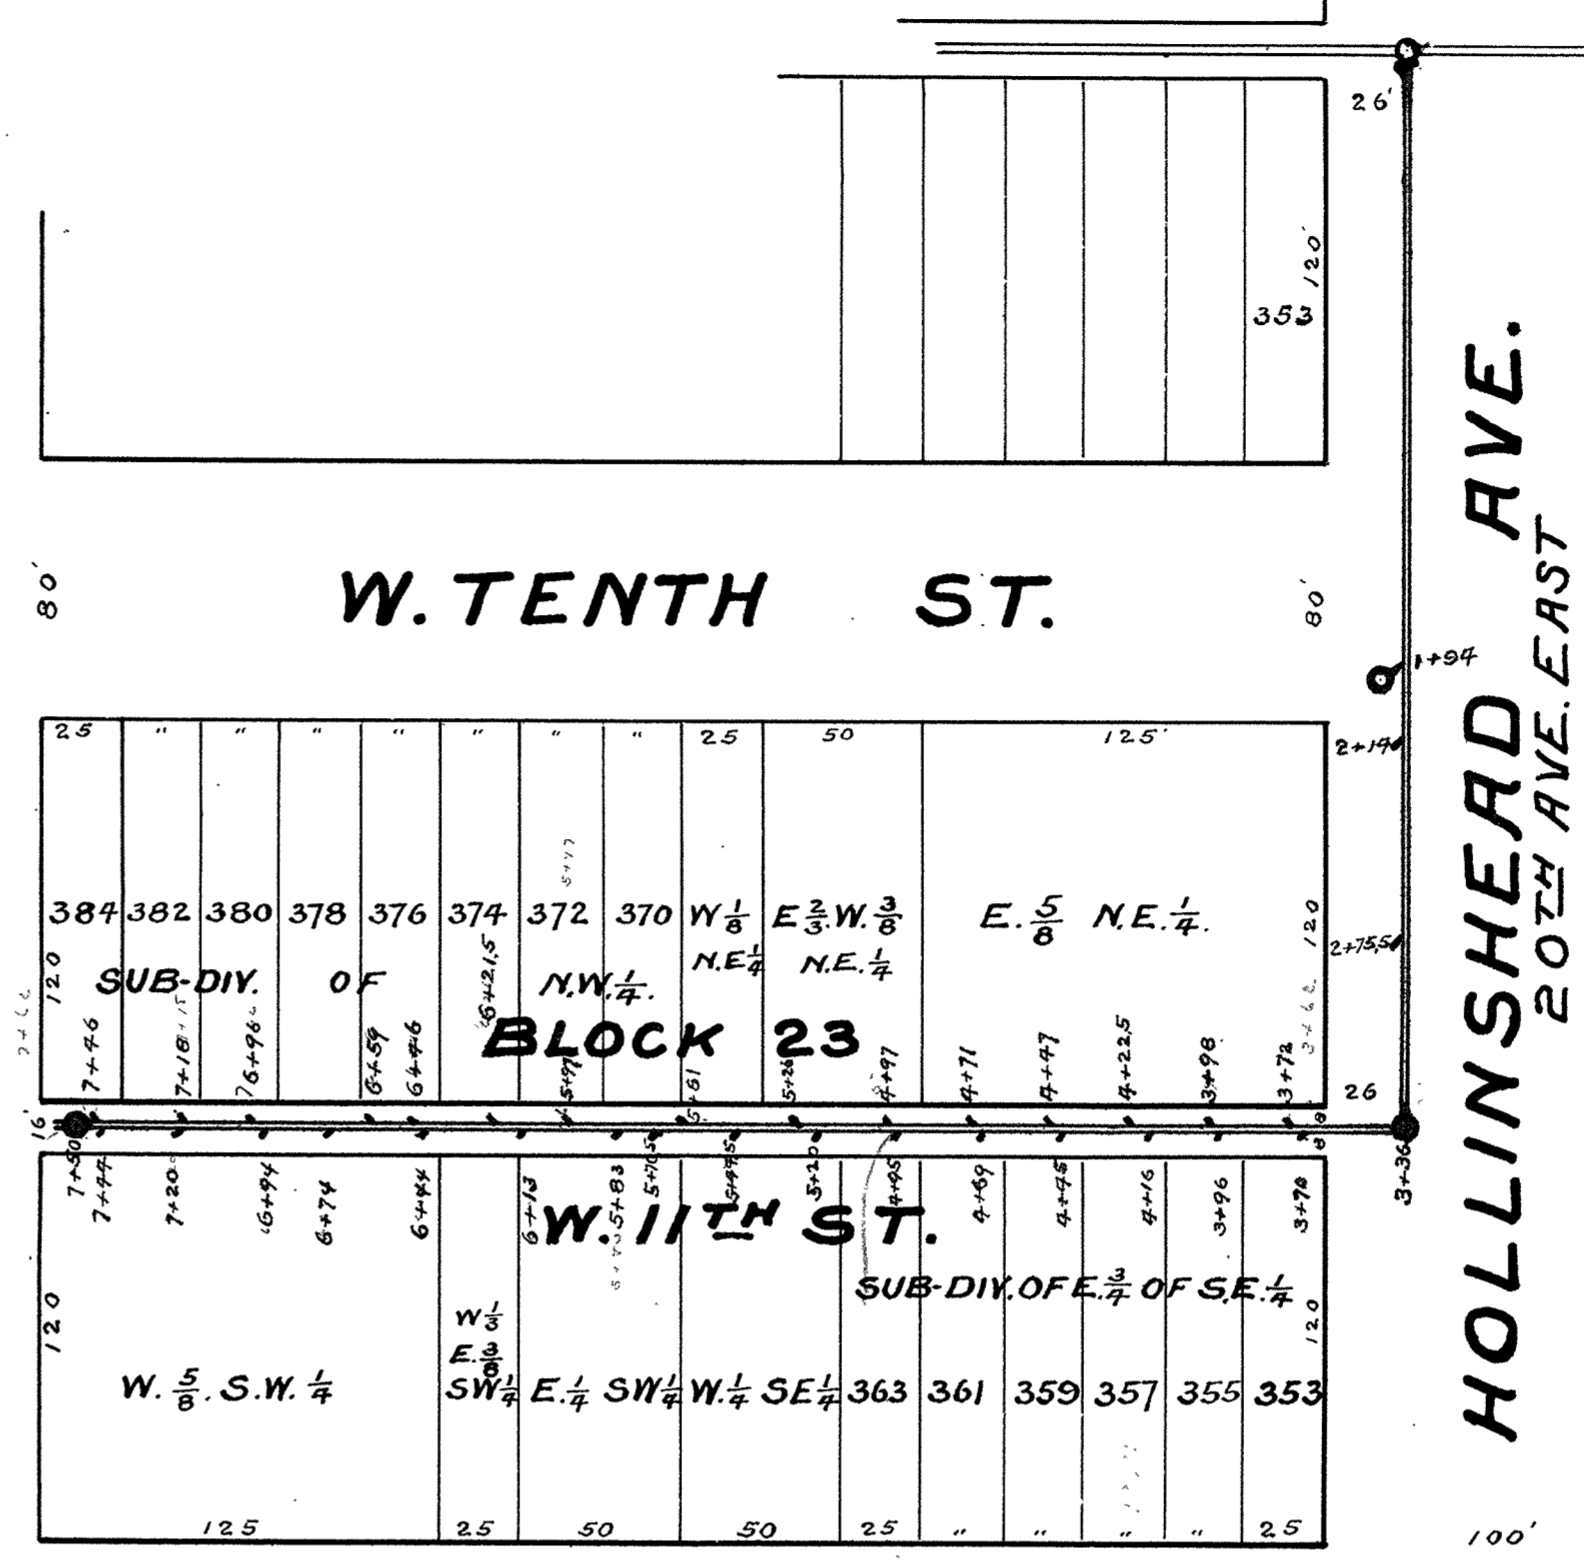

CONTRACT 1633
 SEWER BUILT BY CITY
 S. A. RICHES FOREMAN.
 COMPLETED APR. 12TH 1921
 VER. SCALE 1"=4'
 HOR. " 1"=60'
 E. B. BANKS CITY ENGR
 NICK ANDERSON INSPTR.

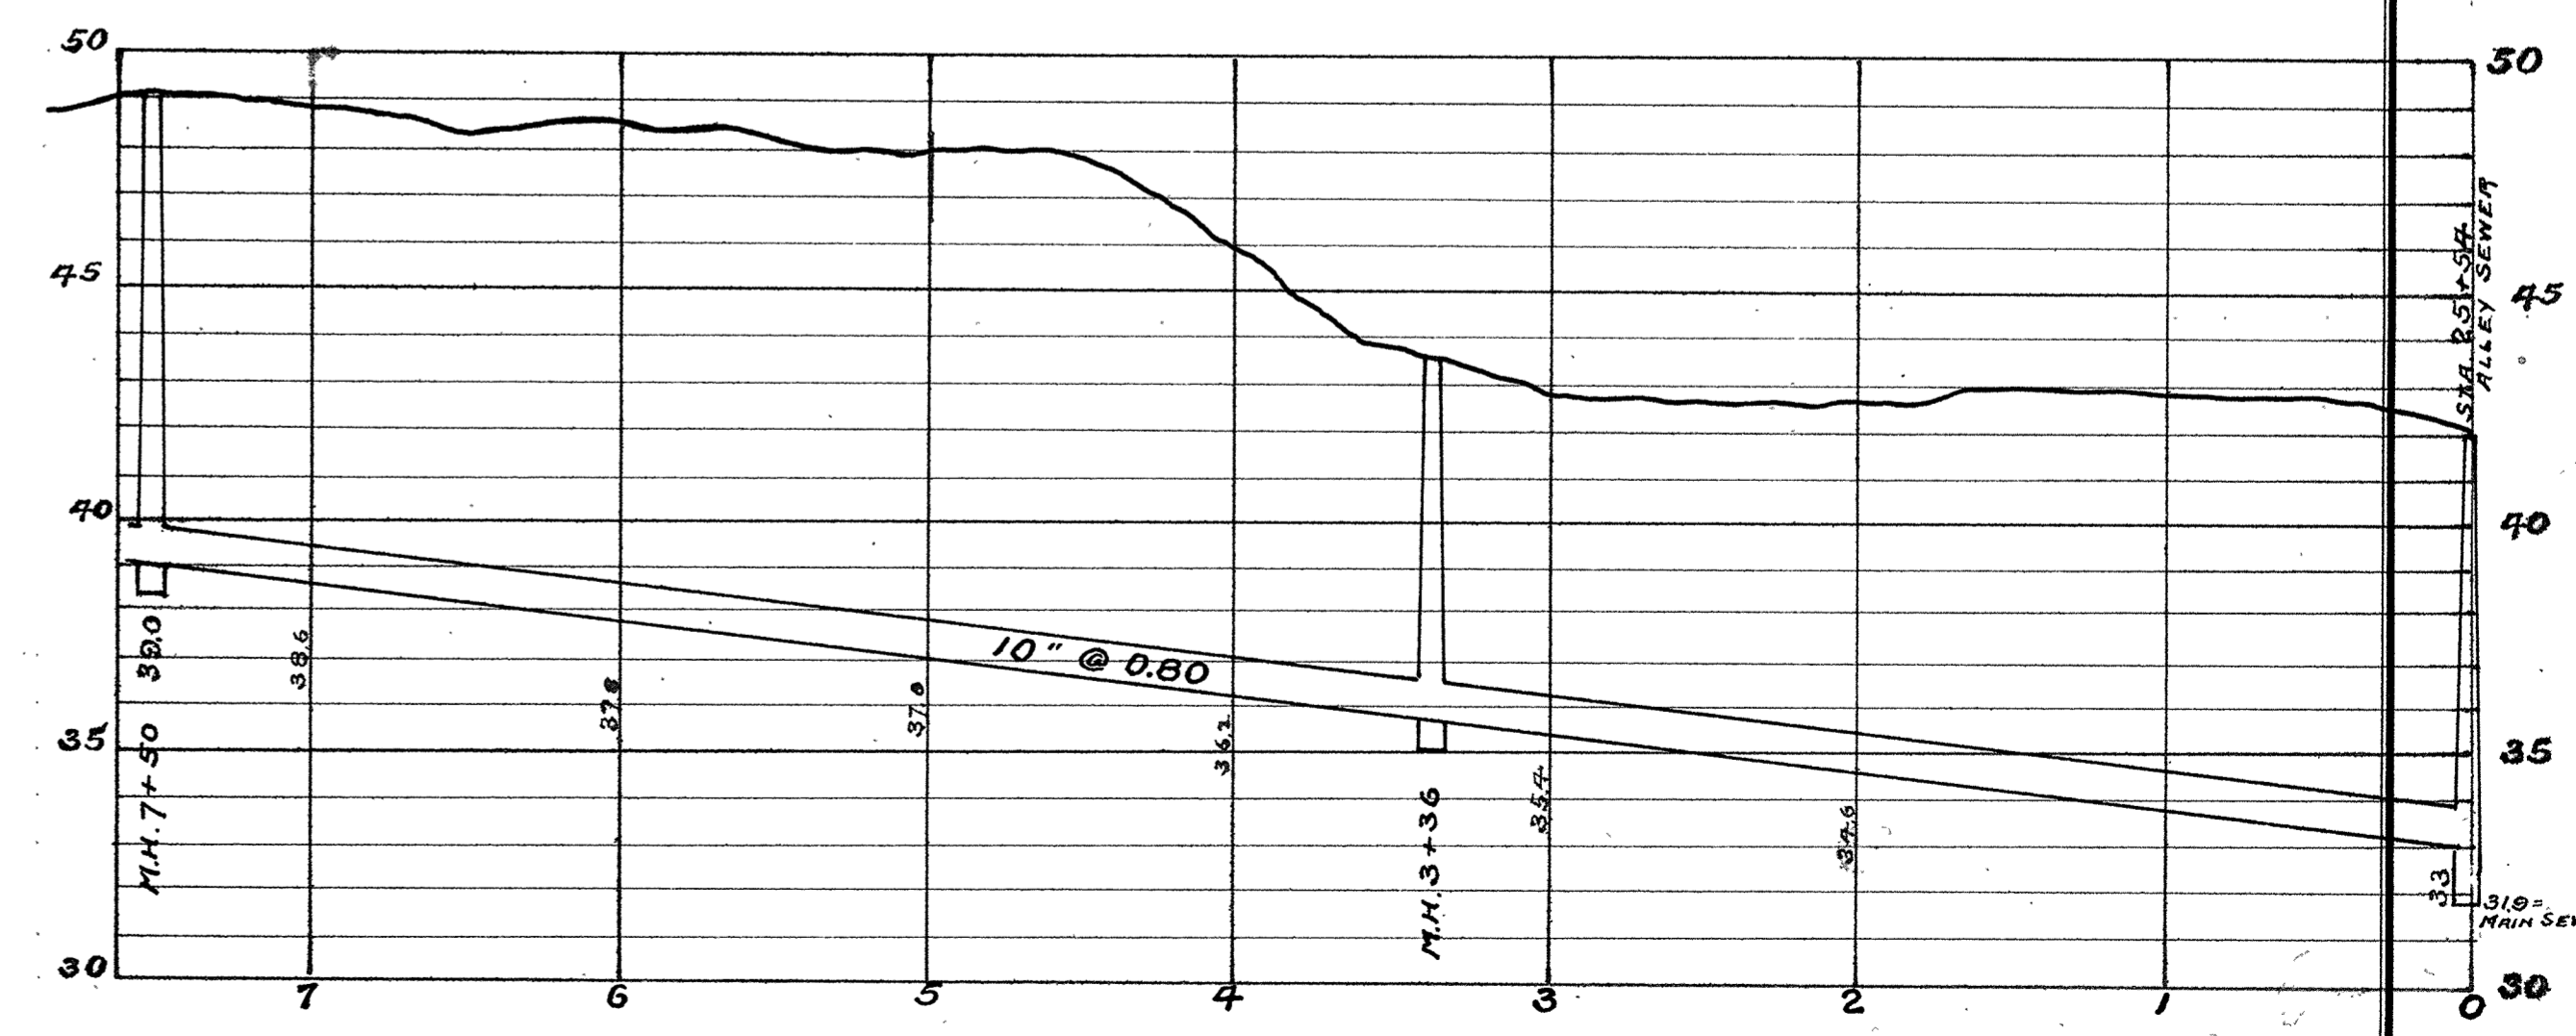

4-30