


**CITY OF SUPERIOR
SEWER PLAN**

HORIZONTAL SCALE 1" = 60'
 VERTICAL SCALE 1" = 4'
 JOB STARTED DEC. 1937
 JOB COMPLETED MAR. 1938
 W.P.A. LABOR
 F. BIRCH INSPECTOR
 T.M. BASTERASH CITY ENGINEER

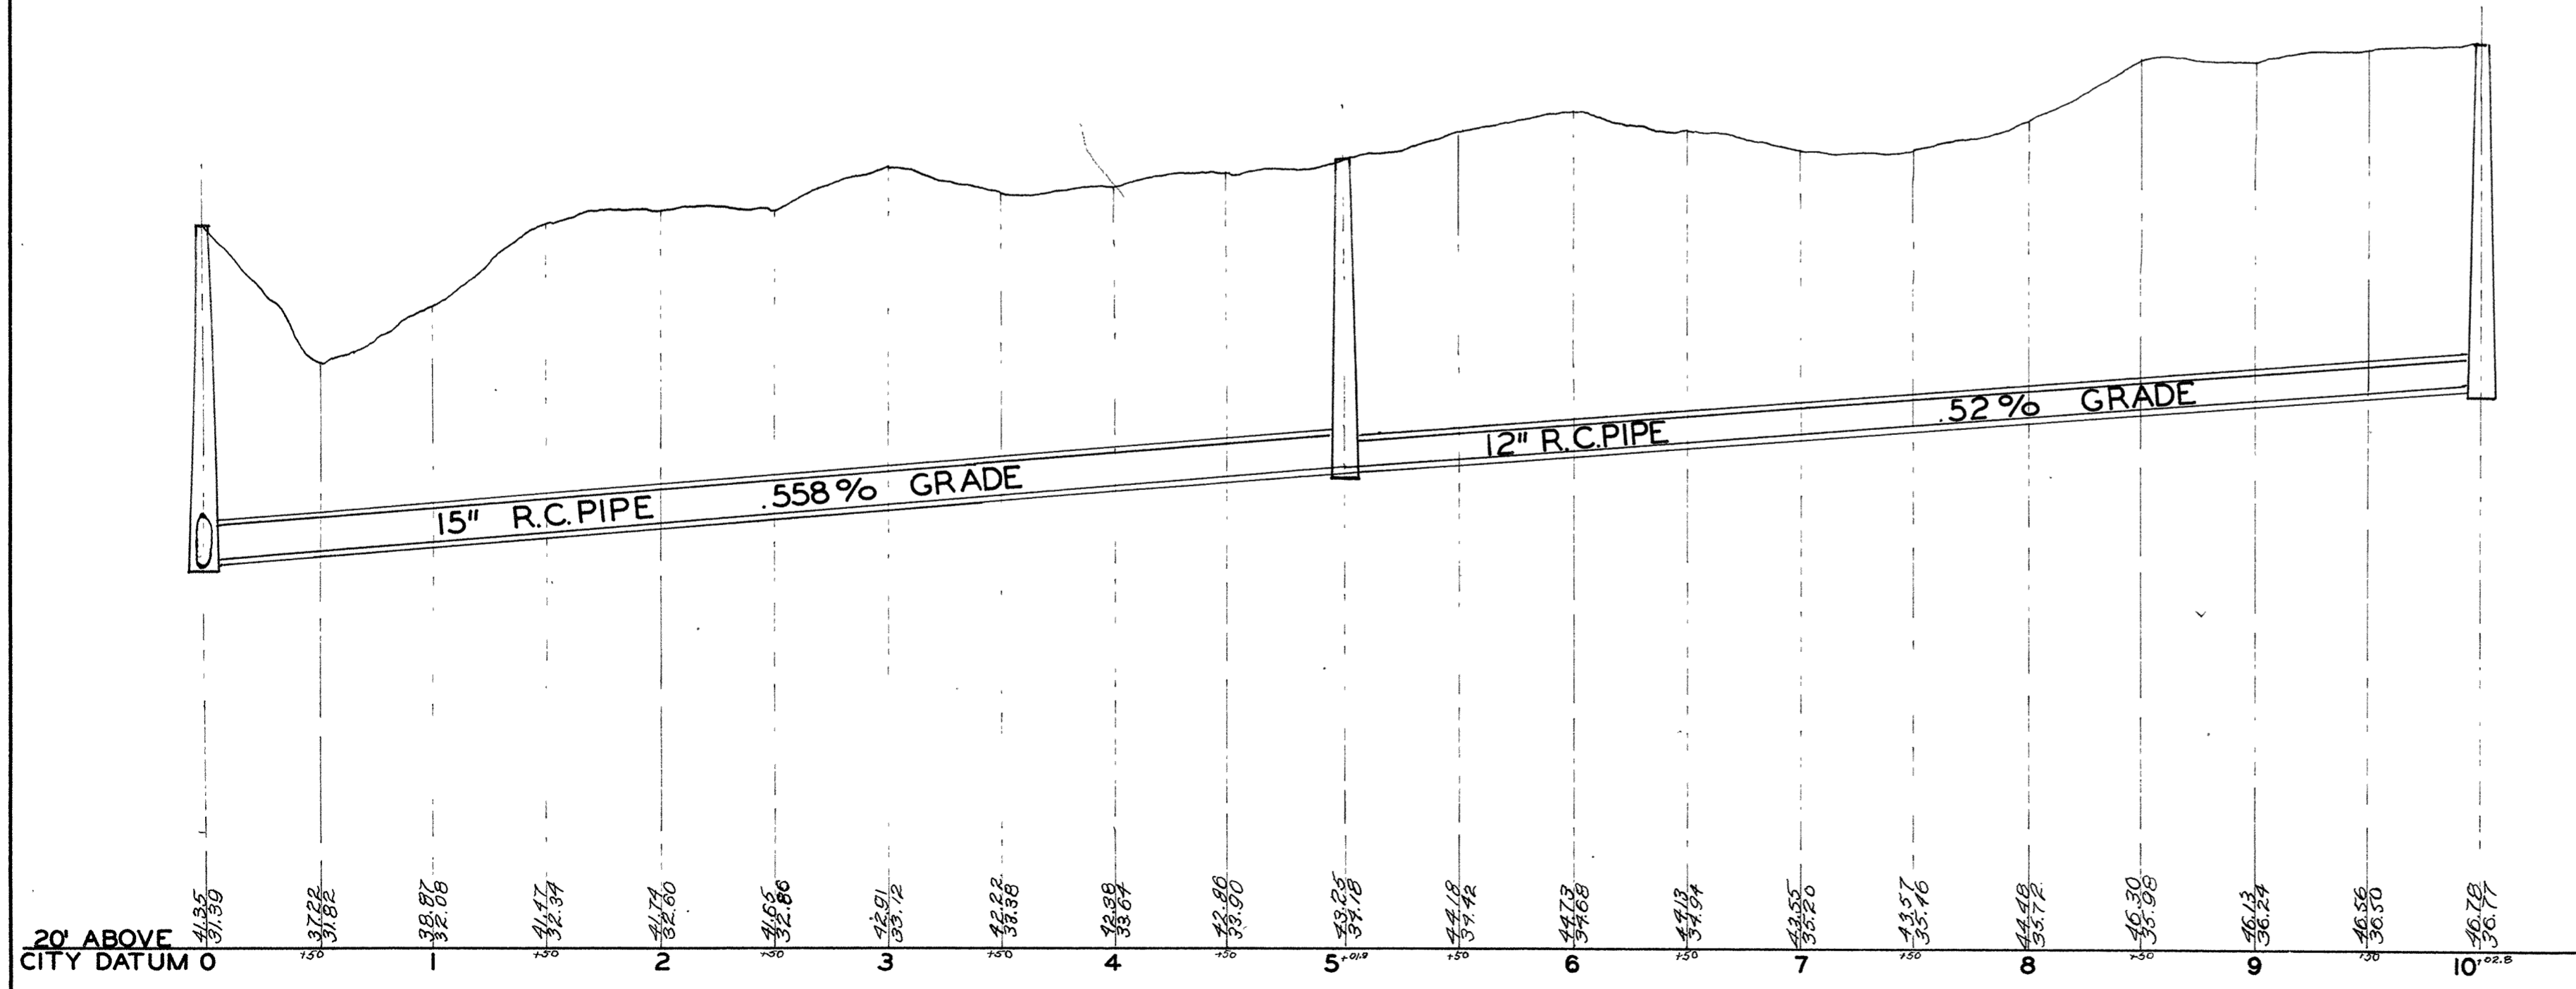

4-30B

4-30B