

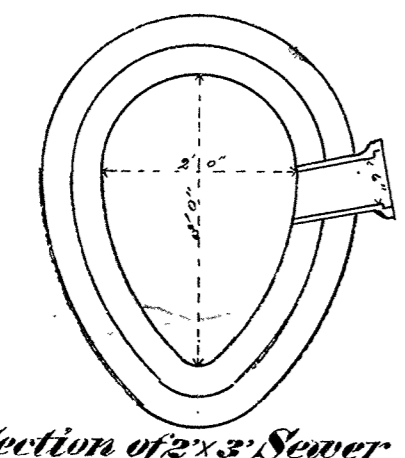


Scale: { Horizontal 1 inch = 60 ft.  
 Vertical 1 inch = 5 ft.  
 Section 1 inch = 2 ft.

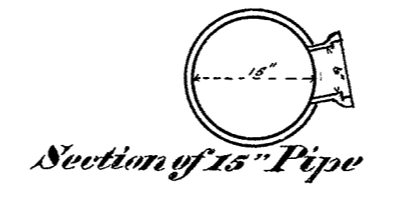

**CITY OF SUPERIOR  
 SEWER PLAN**

Contract let Sept. 17, 1890  
 Completed June 1, 1891  
 Gleason Bros & Rubyour, Contractor  
 Richardson & Smith, Inspectors  
 E. B. Banks, City Engr.

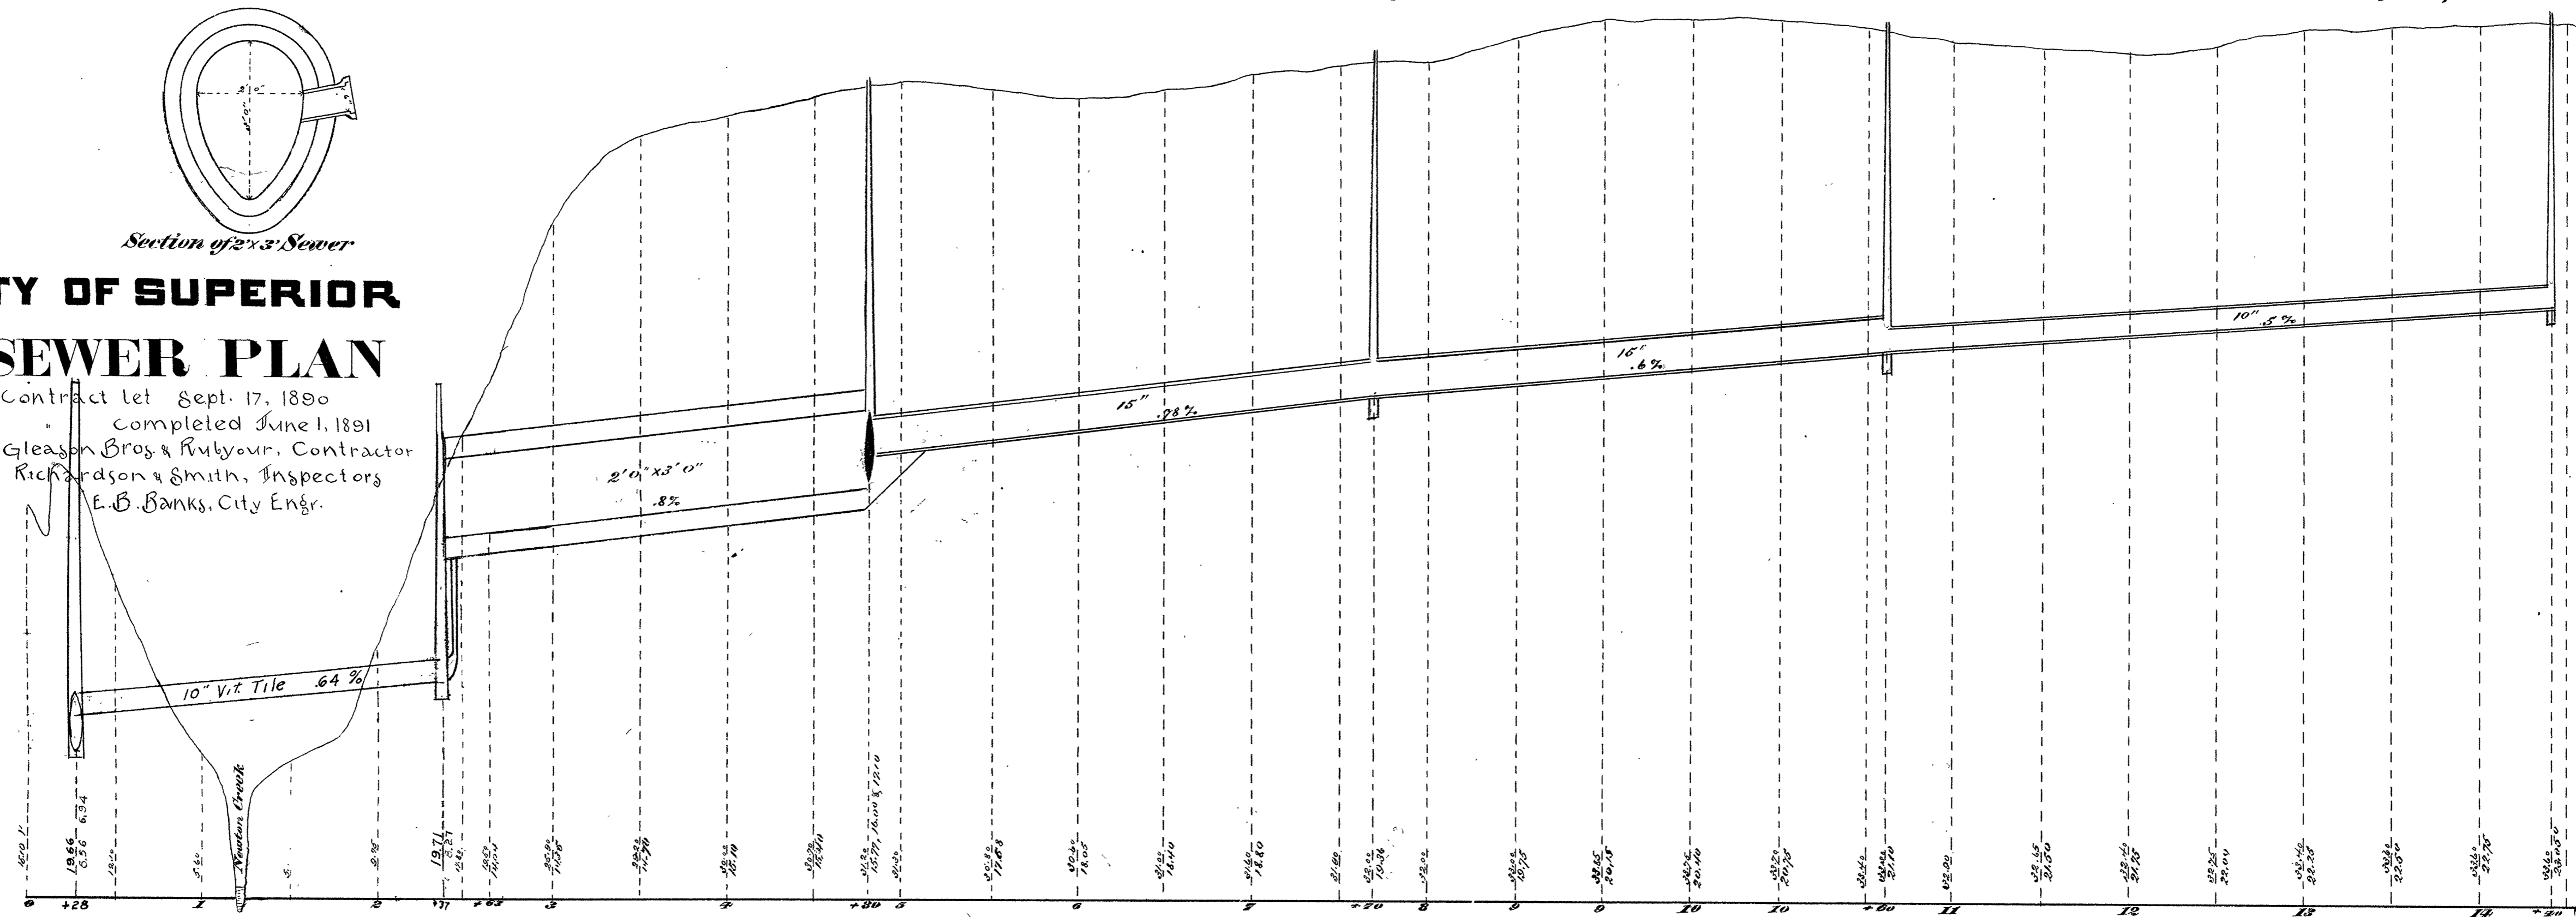

Plan & Profile of Sewer in Alley betw. W. Third & W. Fourth Sts. from Newton to Richardson Ave.