

RICHARDSON 28TH AVE. E.

95	93	91	89	87	85	83	81	79	77	75	73	71	69	67	65
9+33	9+13	9+87	8+65	8+40	8+14	7+29	7+61	7+37	7+12	6+91	6+65	6+41	6+14	5+90	5+65
M.H. 9+406 7.51	9+11	8+55	8+43	8+48	8+42	7+88	7+63	7+26	7+00	6+89	6+63	6+39	6+12	5+88	5+63
94	92	90	88	86	84	82	80	78	76	74	72	70	68	66	

W. FOURTH


BRECKENRIDGE 29TH AVE. E.
M.H. 5+00

63	61	59	57	55	53	51	49	47	45	43	41	39	37	35	33
4+40	4+15	3+91	3+65	3+41	3+15	2+87	2+65	2+39	2+14	1+89	1+64	1+40	1+13	0+89	0+64
4+38	4+13	3+89	3+63	3+39	3+13	2+75	2+63	2+37	2+12	1+87	1+62	1+38	1+20	0+87	0+62
64	62	60	58	56	54	52	50	48	46	44	42	40	38	36	34

NELSON 0+M.H. 0+00
30TH AVE. E.

ST.

Horizontal Scale: 1in=80ft.
Vertical Scale: 1in=4ft.
CONTRACT No 1508
Contract let Feb. 7th 1916
Contract completed May 1st 1916
Andersen & Co. Contractor
Graham Inspector
E. B. Banks City Engineer.

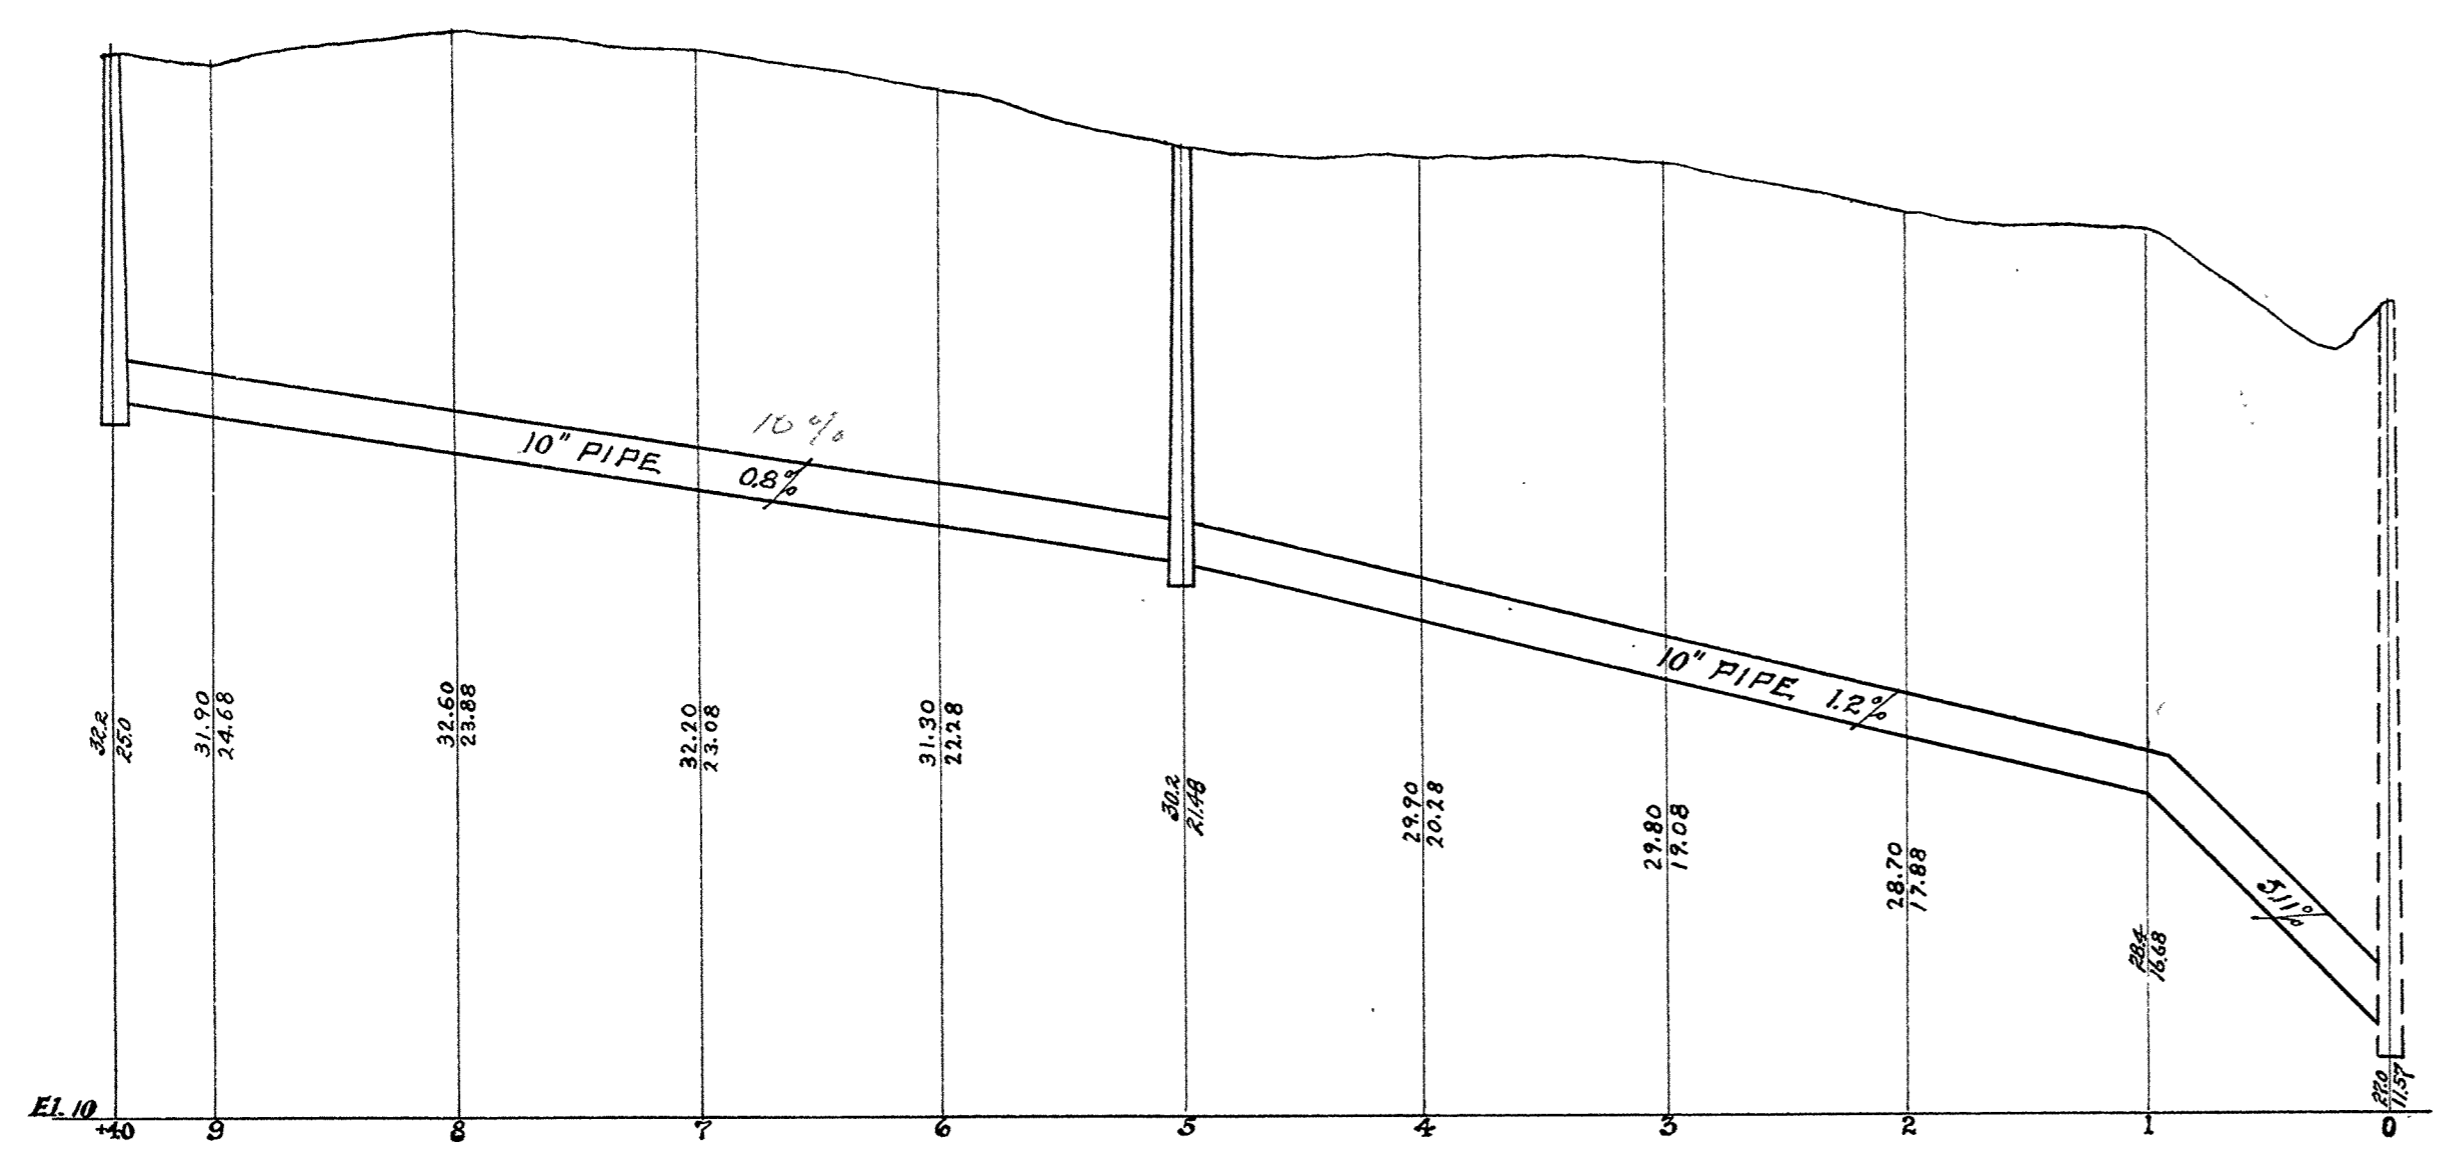

BRECKENRIDGE - 29TH AVE. EAST


63	61	59	57	55	53	51	49	47	45	43	41	39	37	35	33
5+99	5+83	5+57.5	5+33	5+08	4+83	4+58.5	4+34	4+92	4+68	4+43.5	4+19	3+94.5	3+70	3+45.5	3+21
6+01	5+85	5+59.5	5+35	5+10	4+85	4+60.5	4+36	4+11	3+86.5	3+62	3+37.5	3+13	2+89	2+64.5	2+40
64	62	60	58	56	54	52	50	48	46	44	42	40	38	36	34

E. THIRD STREET

NELSON - 30TH AVE. EAST

OLD M.H. 0+00

Horizontal Scale: 1Inch = 80 Ft.
Vertical Scale: 1Inch = 4 Ft.
CONTRACT No 1688
Contract Let Oct. 8th 1924
Contract Completed Dec. 1st 1924
Magnus Peterson Contractor
Byron Kimball Inspector
E. B. Banks City Engineer.

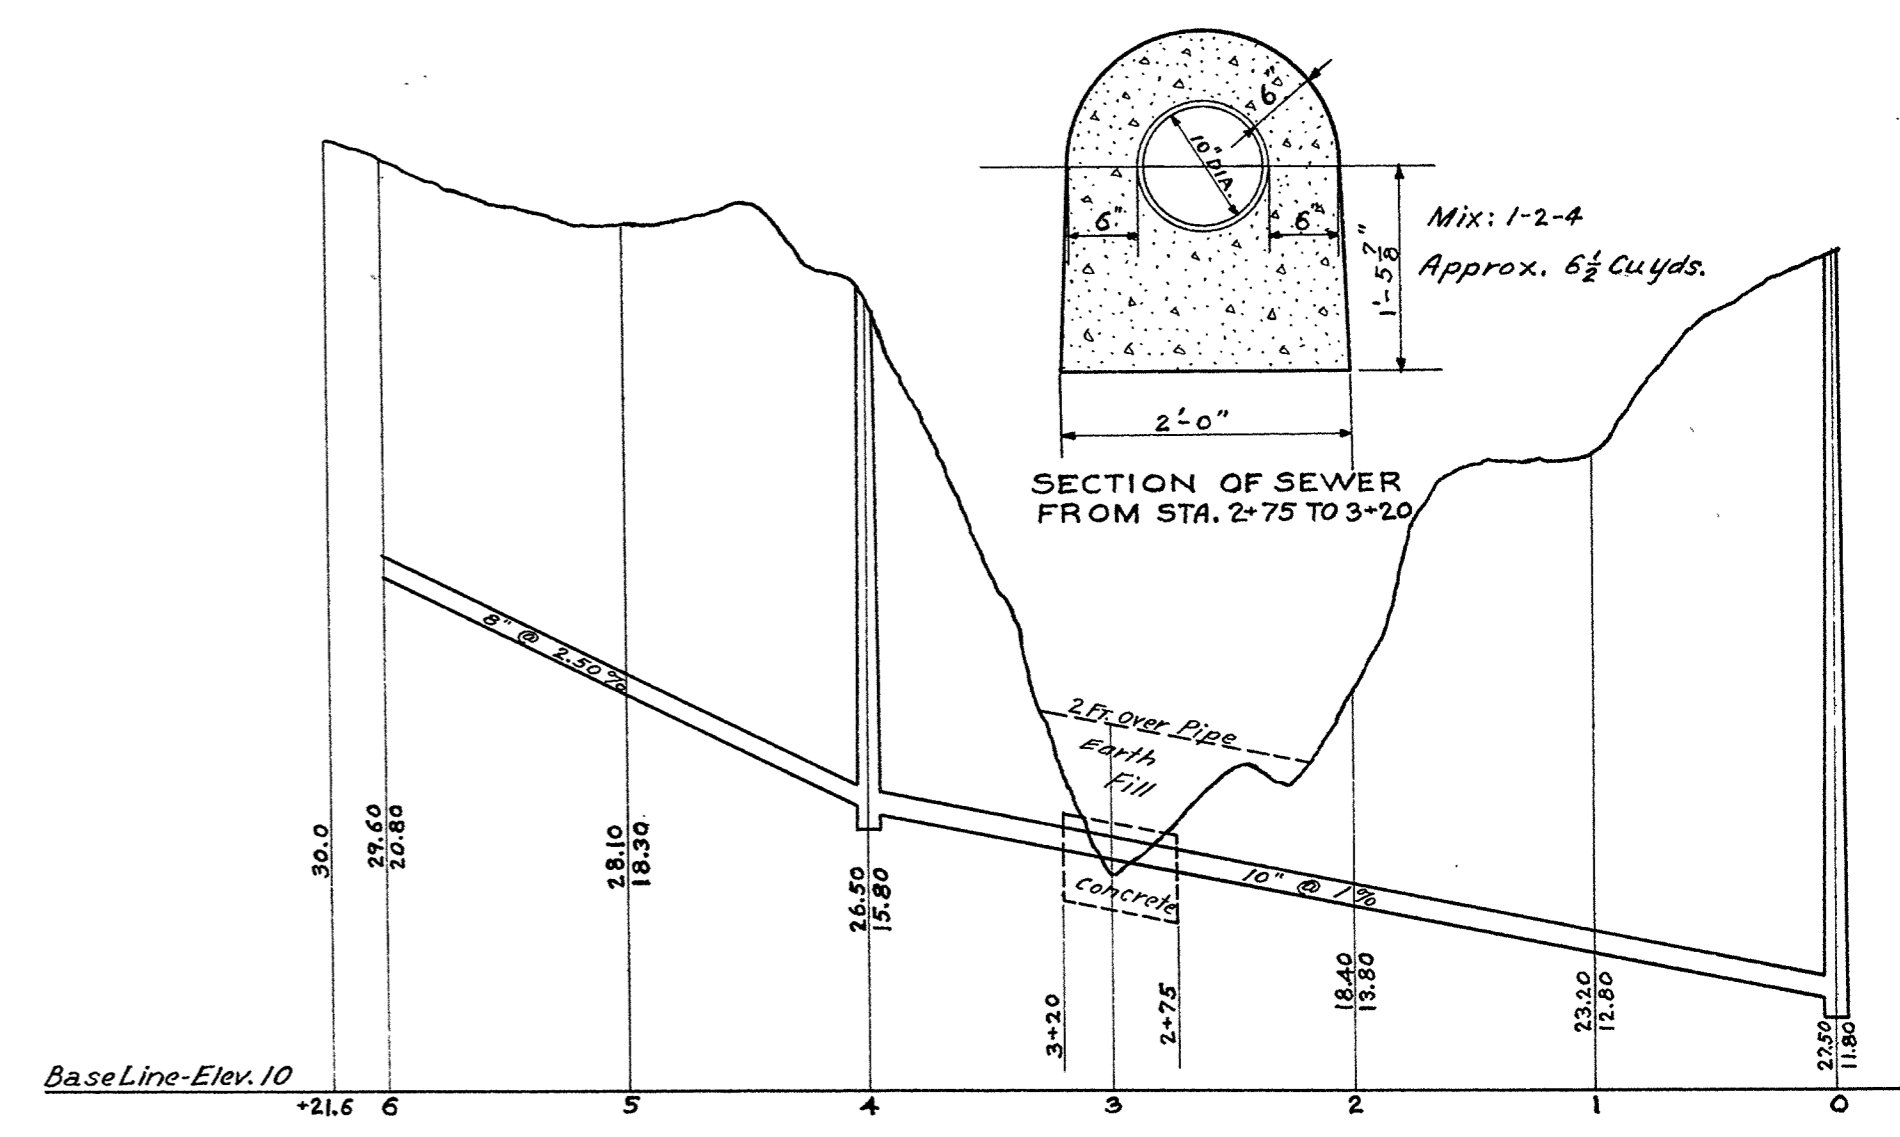

19.21 462

4-31-A