
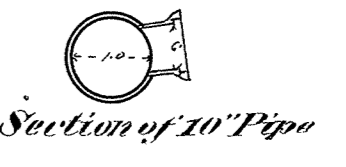
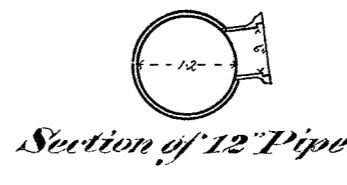
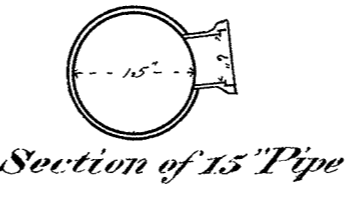



**CITY OF SUPERIOR**

**SEWER PLAN**

Contract let June 1, 1891  
 completed Aug. 7, 1891  
 Stockton & Lundquist, Contractor  
 Jos. P. Duff, Inspector  
 E. B. Banks, City Eng'r.

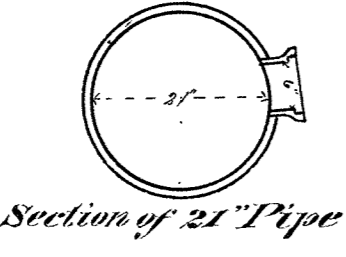

Scale: Horizontal 60ft. = 1 inch  
 Vertical 4" = 1'  
 Section 2" = 1'

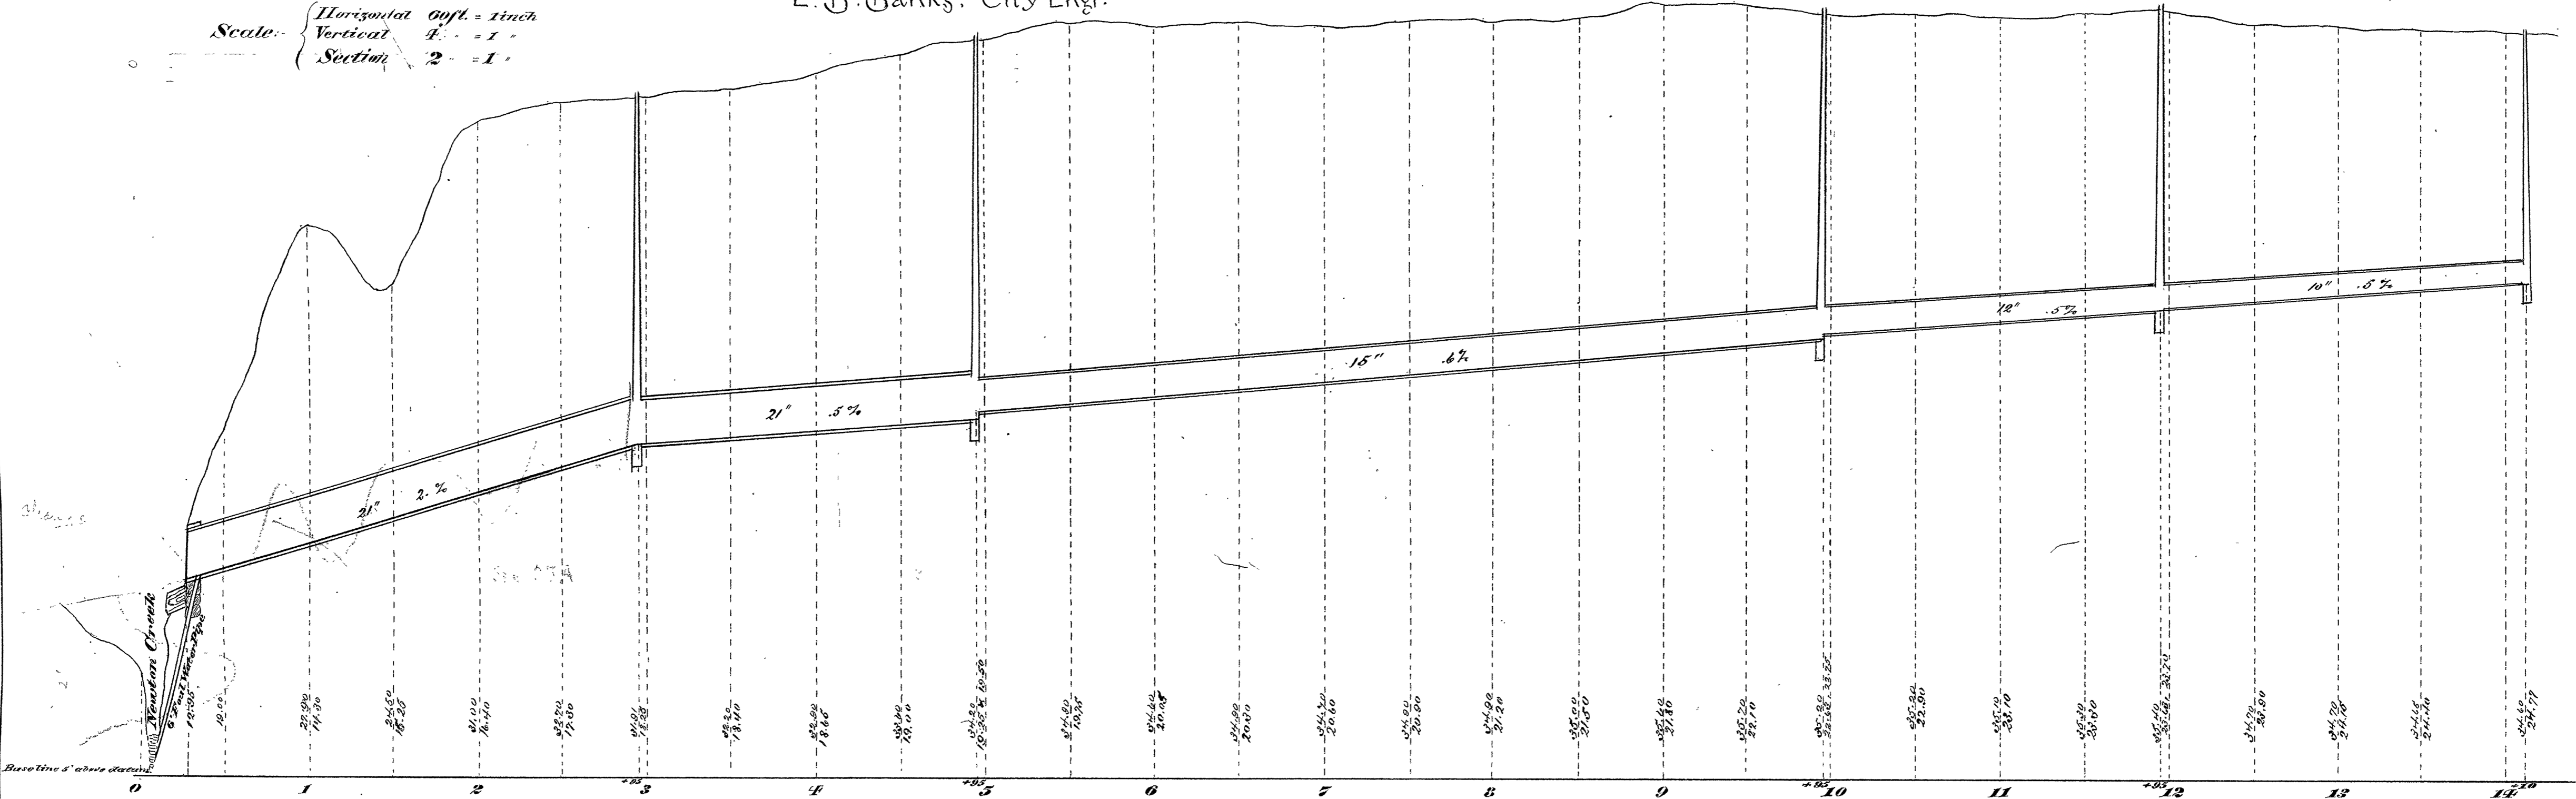

Plan and Profile of Sewer in Alley betw. W. Sixth and W. Seventh Sts. from Newton to Richardson Ave.