


CITY OF SUPERIOR  
SEWER PLAN

HORIZONTAL SCALE: 1" = 60'  
VERTICAL SCALE: 1" = 4'

JOB STARTED: JAN. 6, 1937  
JOB COMPLETED: MAR. 15, 1937  
W. P. A. LABOR  
R. H. DANN INSPECTOR

L. W. PELESKE-CITY ENGINEER

NOTE:  
Detail of sewer outlet & flapgate  
shown on drawing File No. 3-497

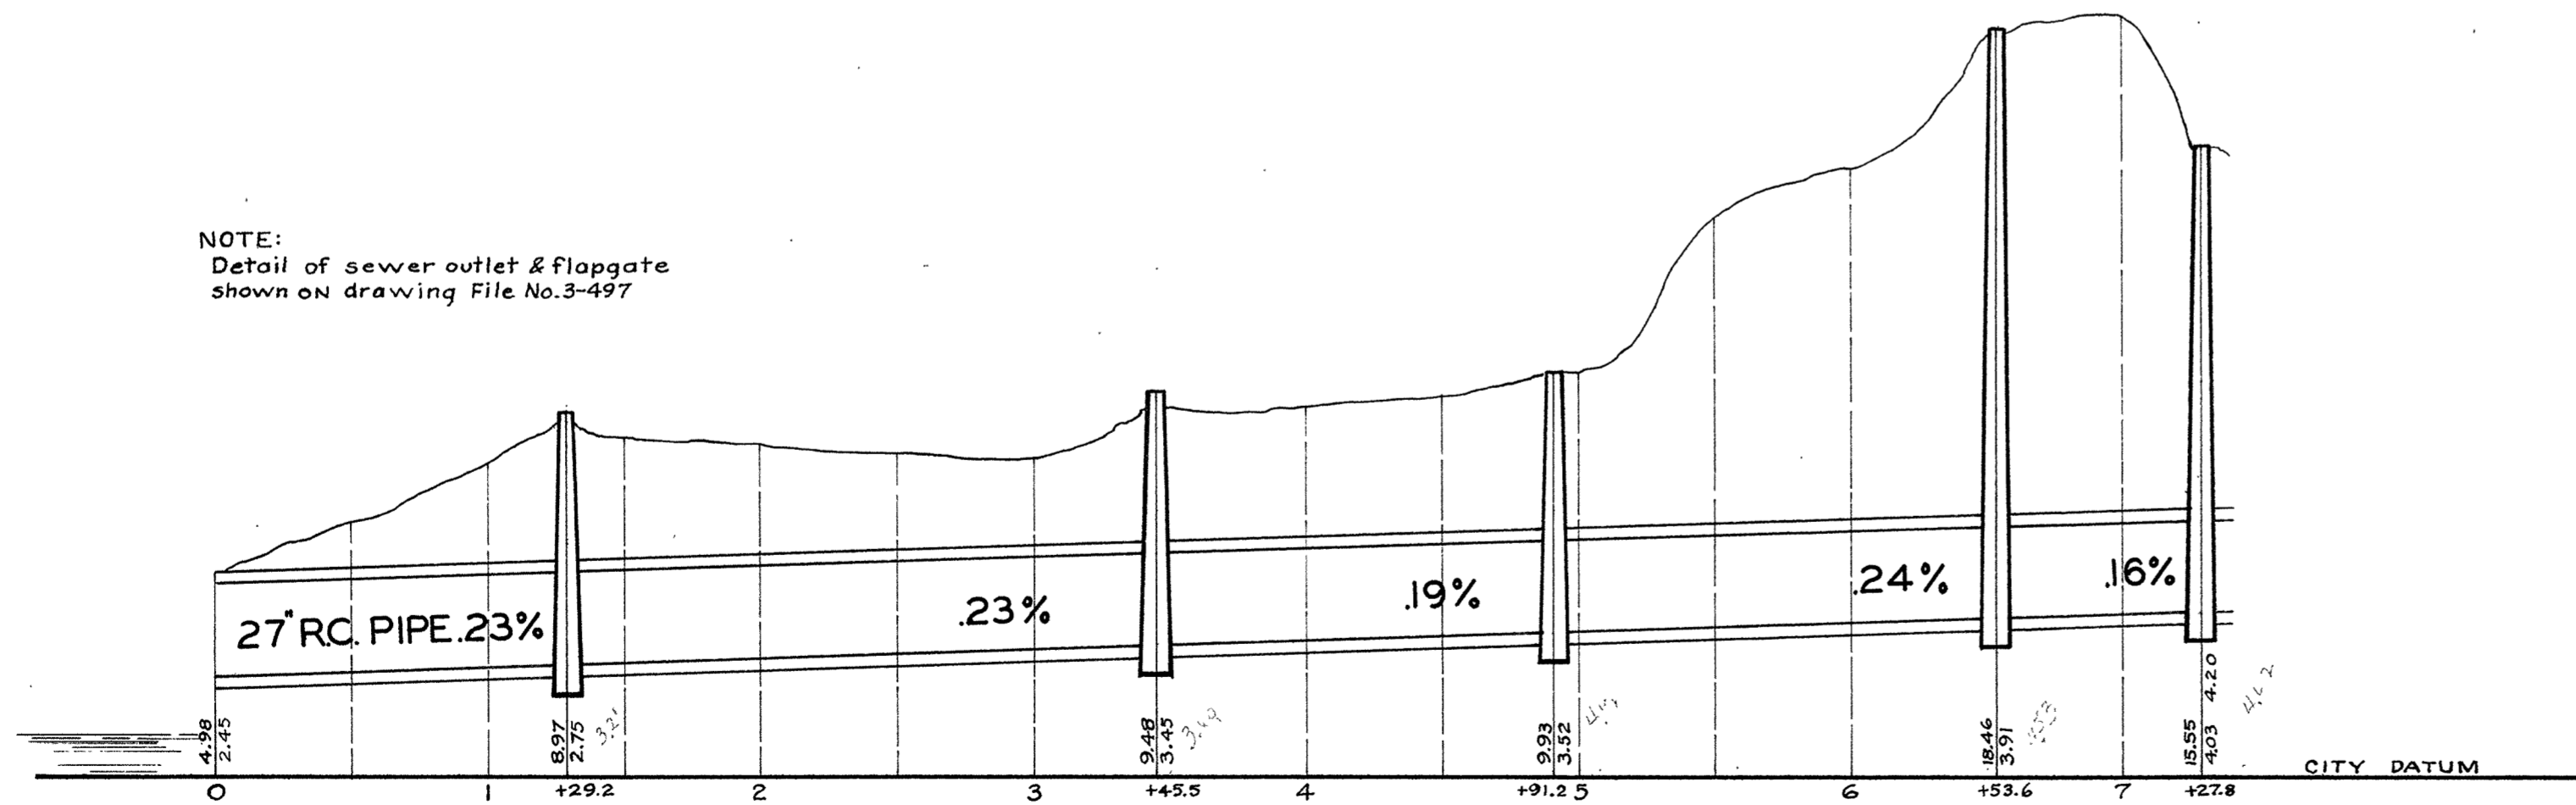

27" R.C. SEWER FROM NEWTON AVE. BETWEEN 2ND & 3RD TO CULVERT UNDER N.P. RY. YARDS