
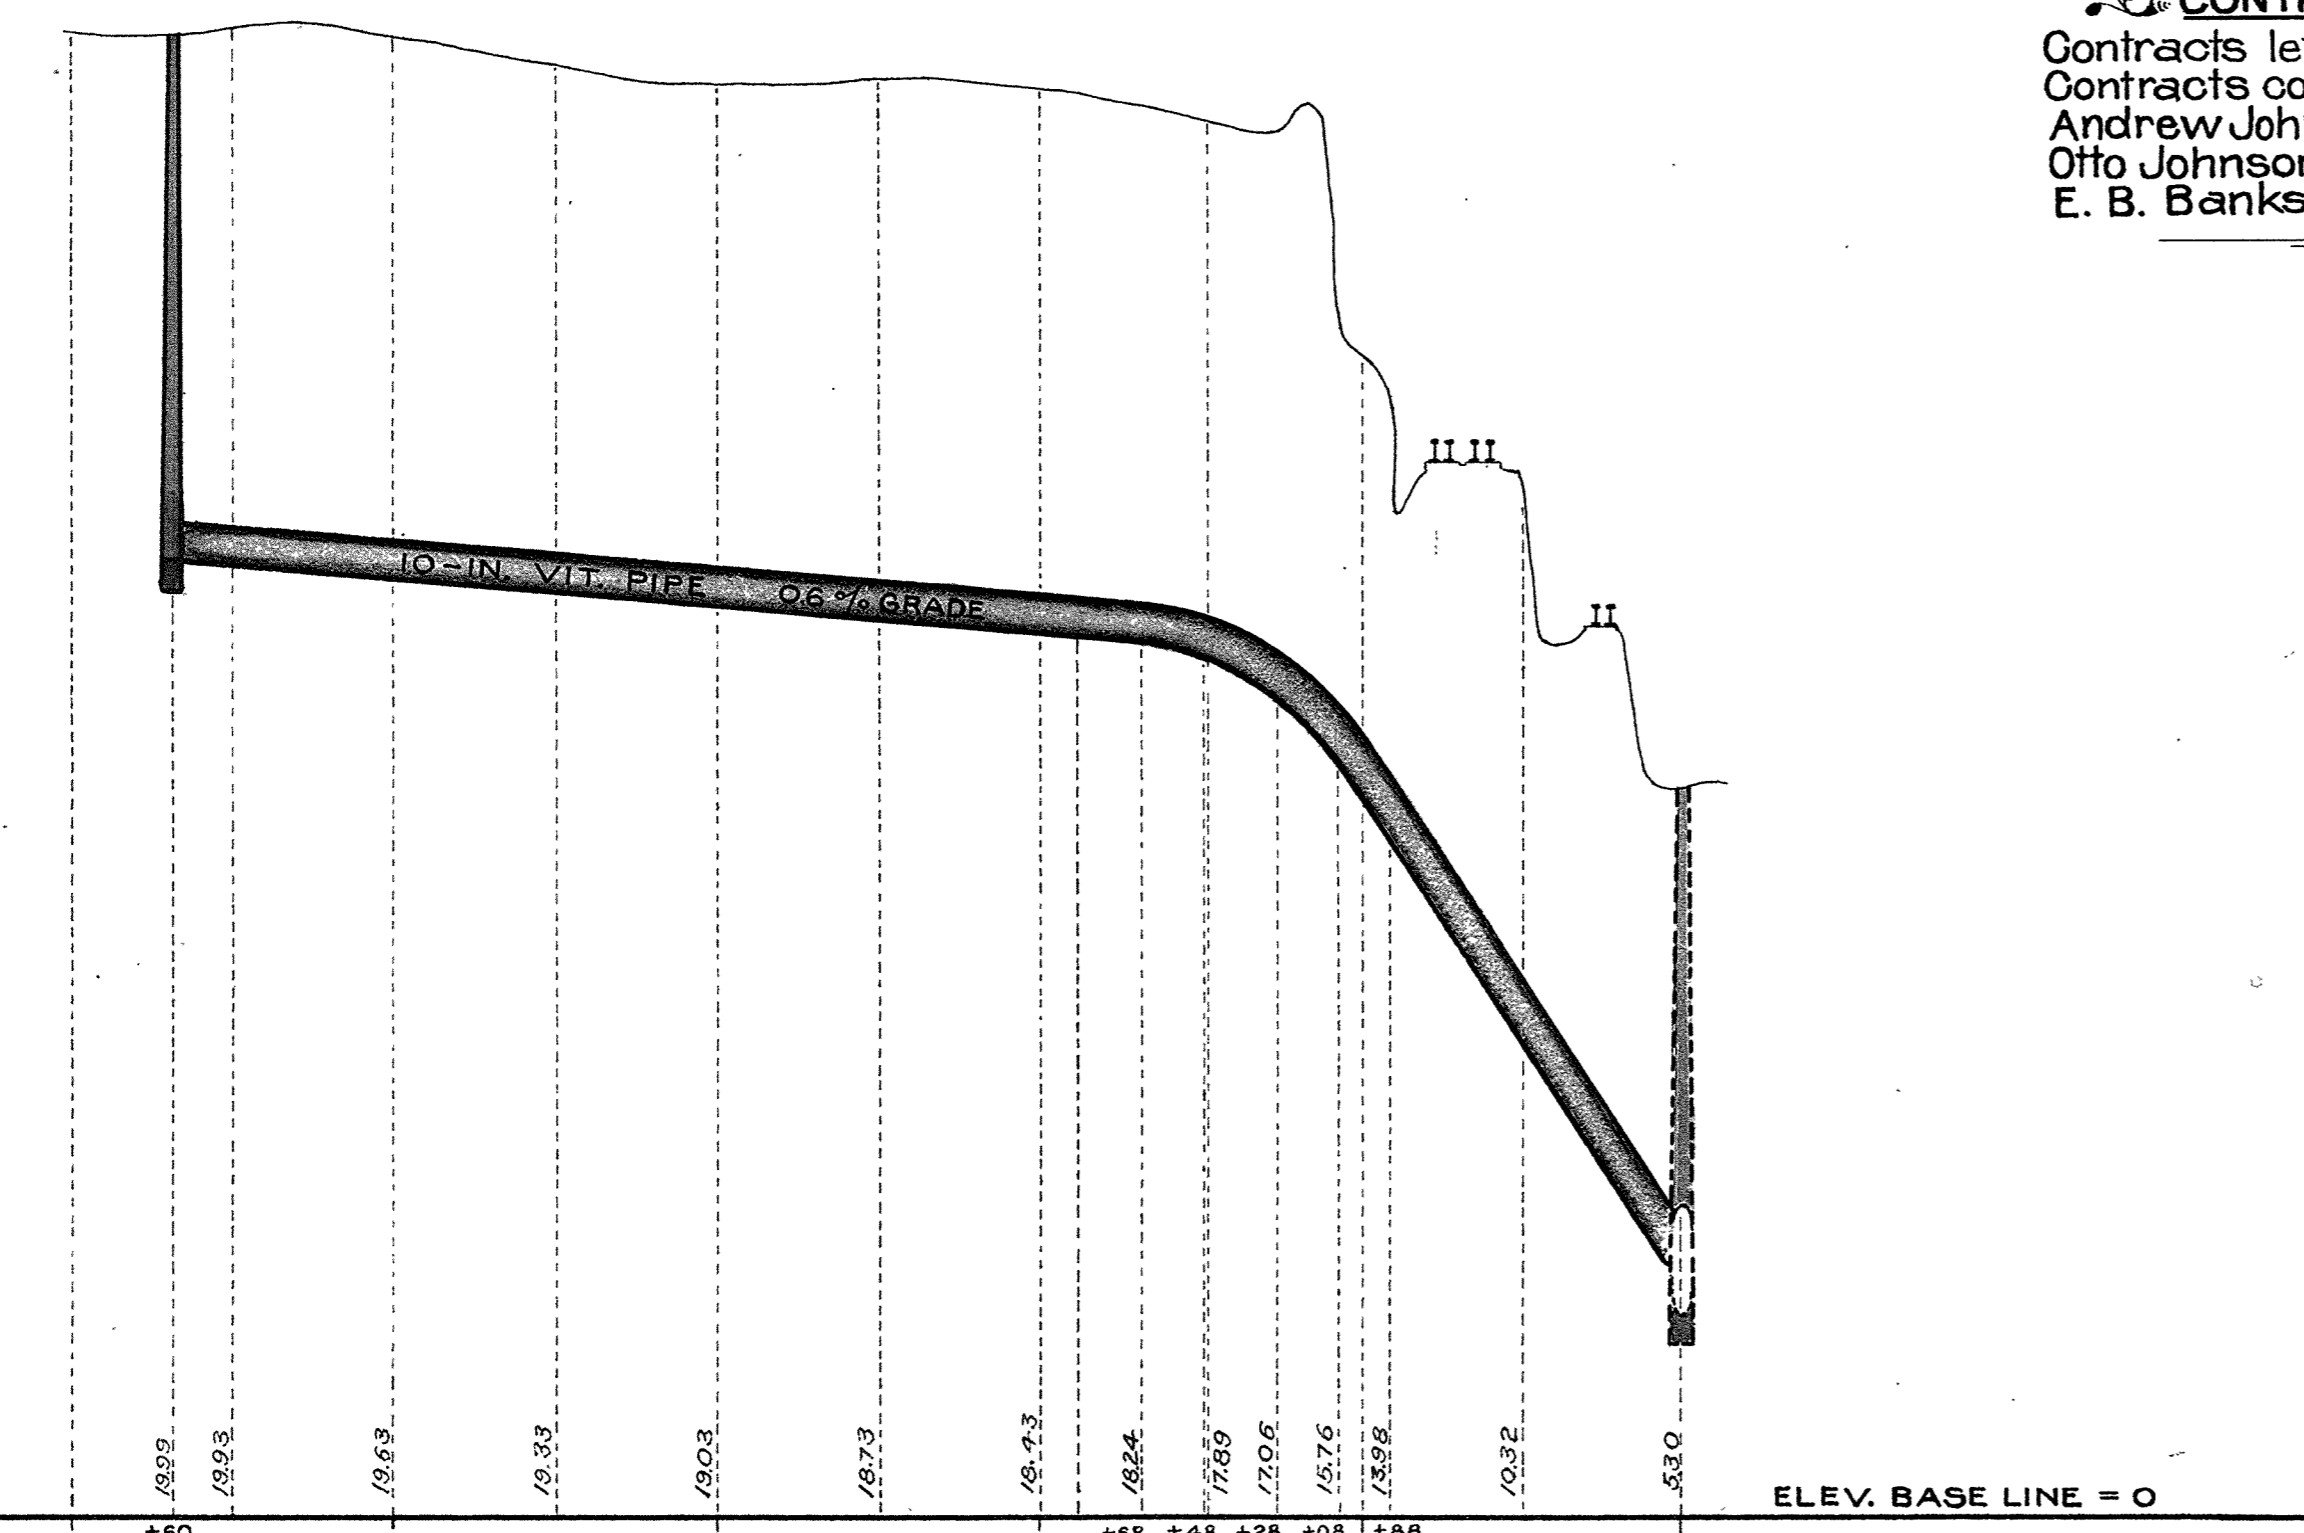



### CITY OF SUPERIOR SEWER PLAN

Horizontal Scale: 1 inch = 60 feet.  
Vertical Scale: 1 inch = 4 feet.

CONTRACT NOS. 1209 & 1210  
Contracts let..... May 20, 1910.  
Contracts completed, July 27 & July 5, 1910.  
Andrew Johnson..... Contractor.  
Otto Johnson..... Inspector.  
E. B. Banks..... City Engineer.

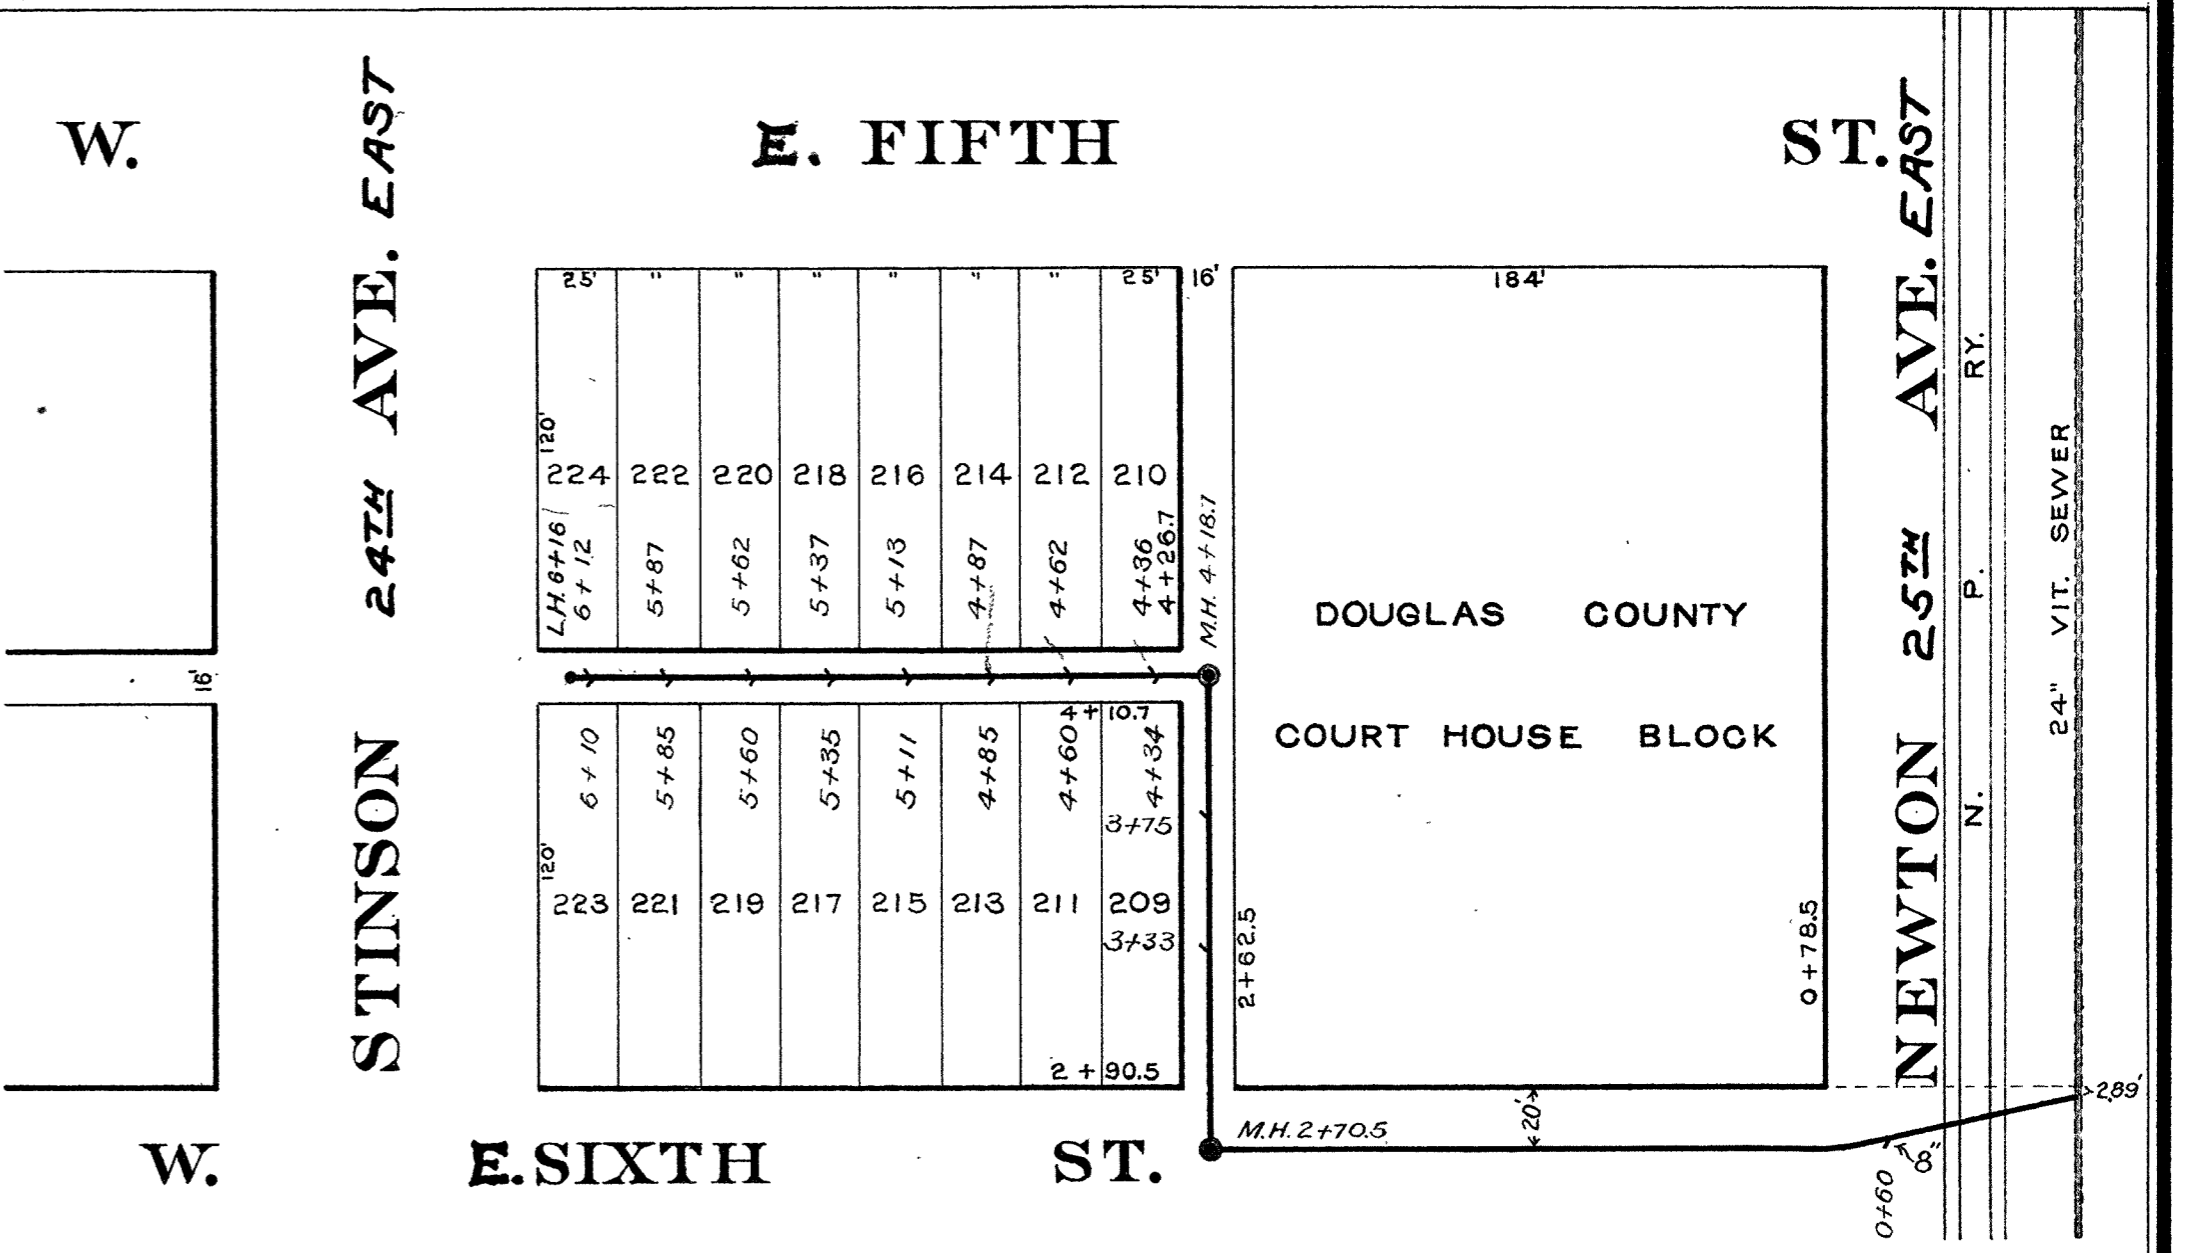

Sewer between W. 2nd. and W. 3rd. St., Stinson to Newton.

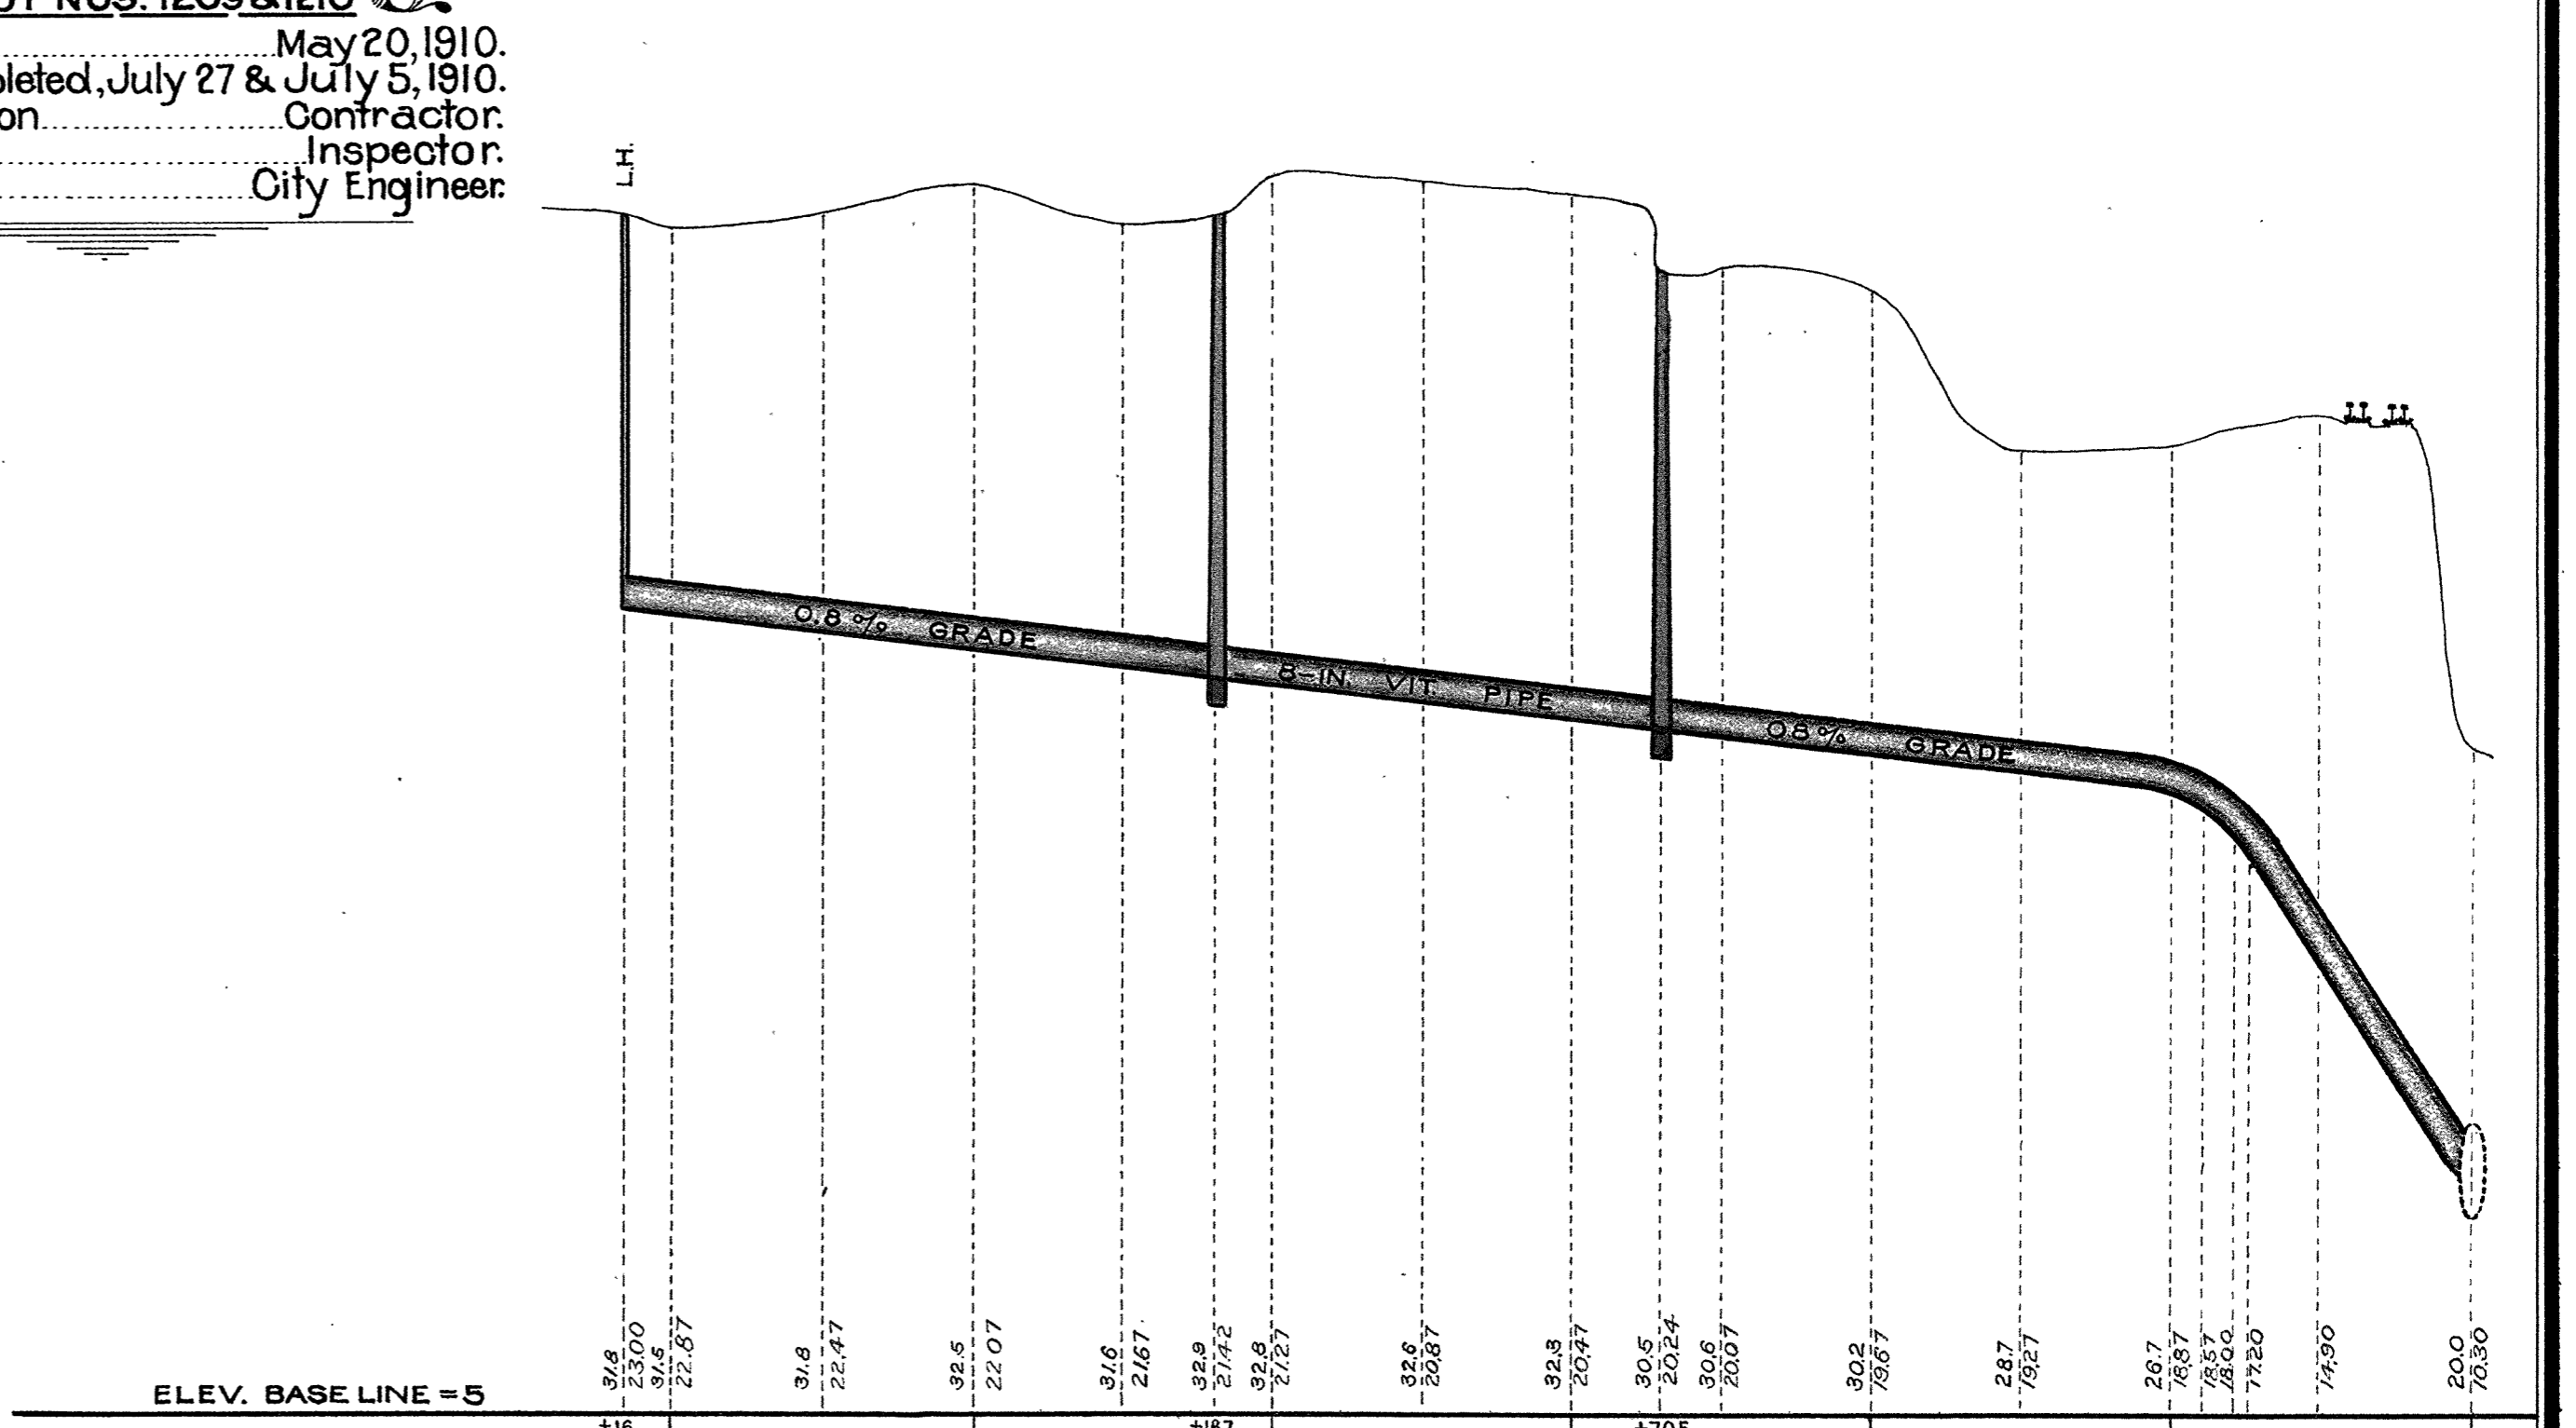

Sewer between W. 5th. and W. 6th. St., Stinson to Newton.