


### CITY OF SUPERIOR SEWER PLAN

Horizontal Scale: 1 in. = 80 ft.  
Vertical Scale: 1 in. = 4 ft.

CONTRACT No 1381

Contract let July 5, 13.  
Contract completed Dec. 12, 13.  
S. A. Riches & Anderson Contractors  
G. Brooks Inspector  
E. B. Banks City Engineer.

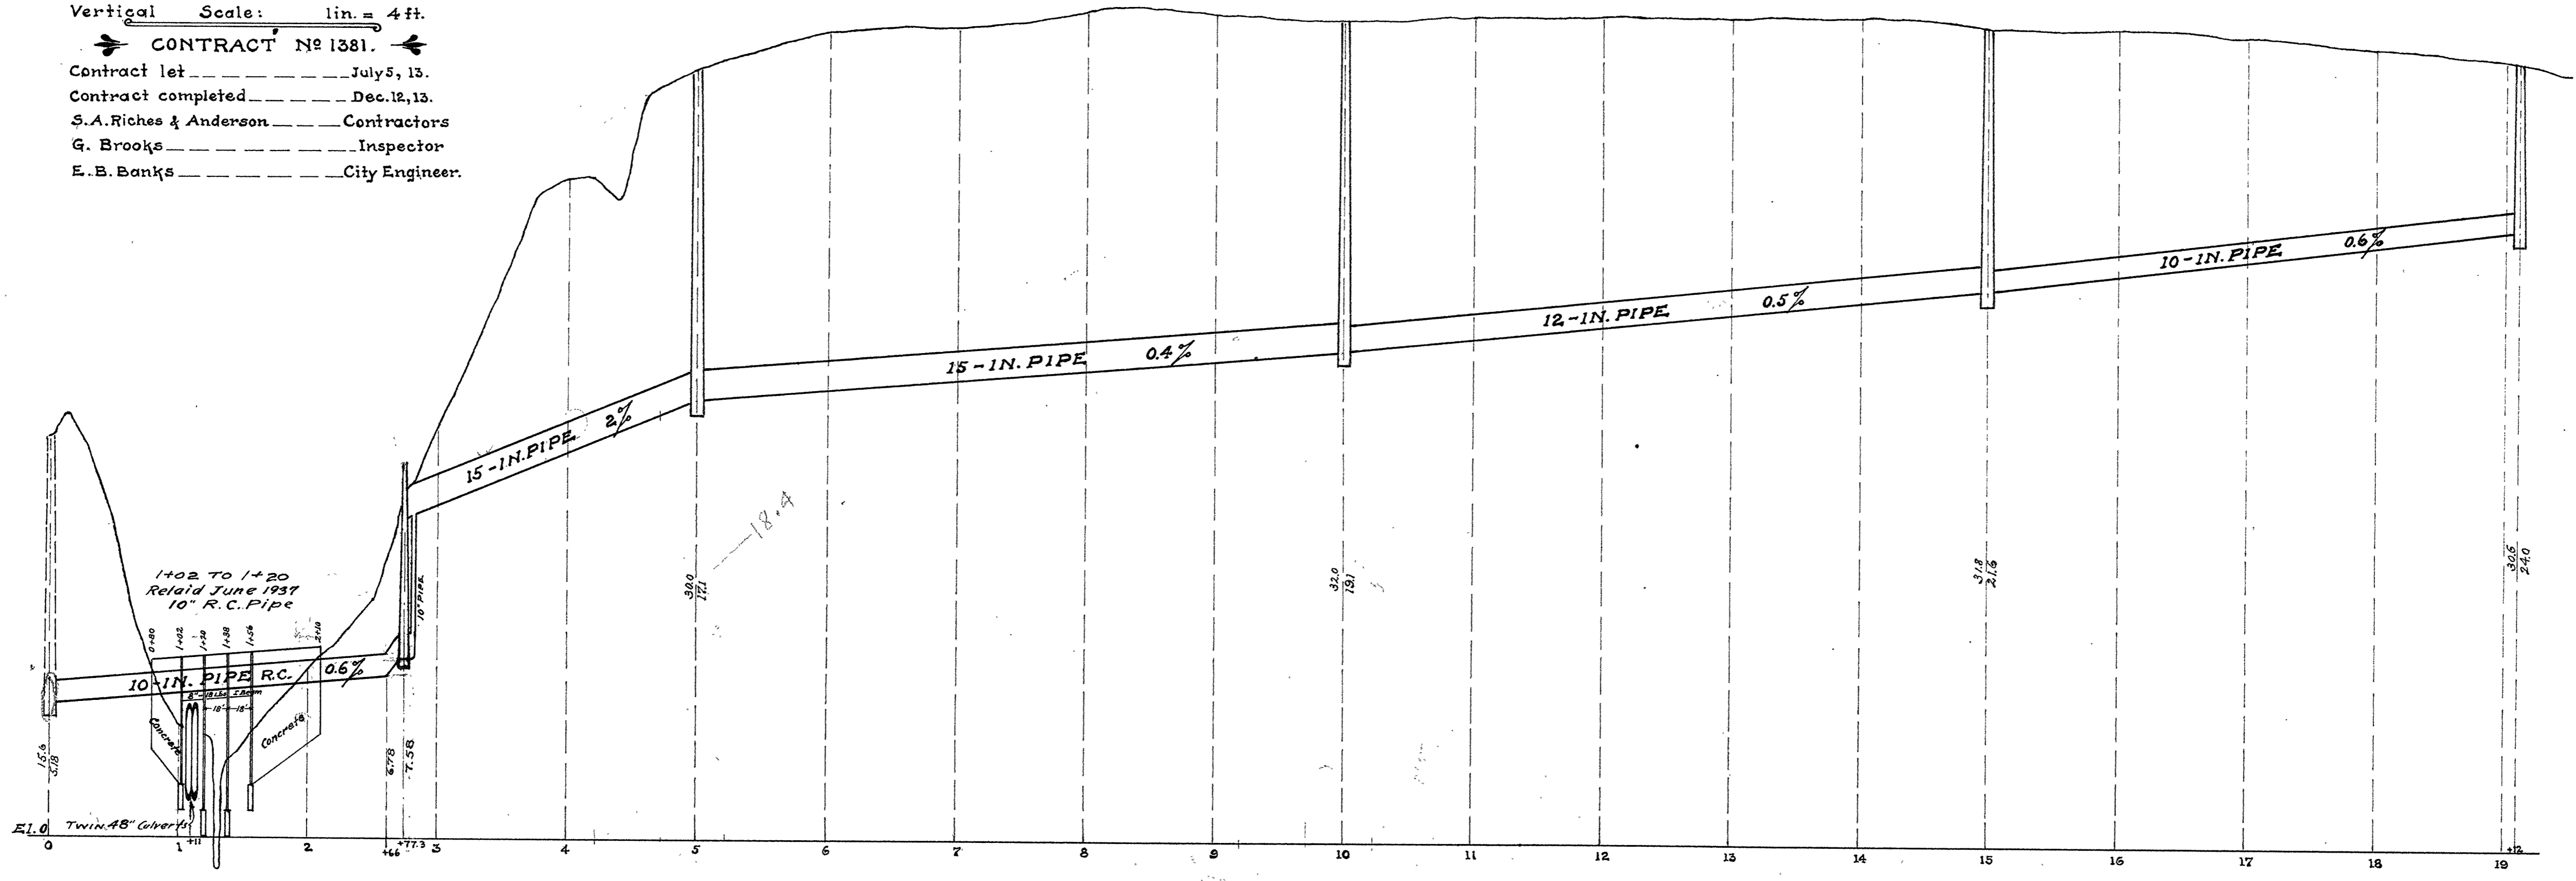

4-41