


FROM STA. 15+62 TO STA. 16+64  
 LOCATIONS OF SPECIALS ARE APPROXIMATE,  
 RECORDS ARE INCOMPLETE AS TO EXACT LOCATIONS.



Horizontal Scale: 1 in = 80 ft.  
 Vertical Scale: 1 in = 4 ft.  
**CONTRACT NO 1504**  
 Contract let Jan 20-1916.  
 Contract completed Apr 1<sup>st</sup>-1916  
 Andrew Johnson Contractor  
 J. B. Graham Inspector  
 E. B. Banks City Engineer

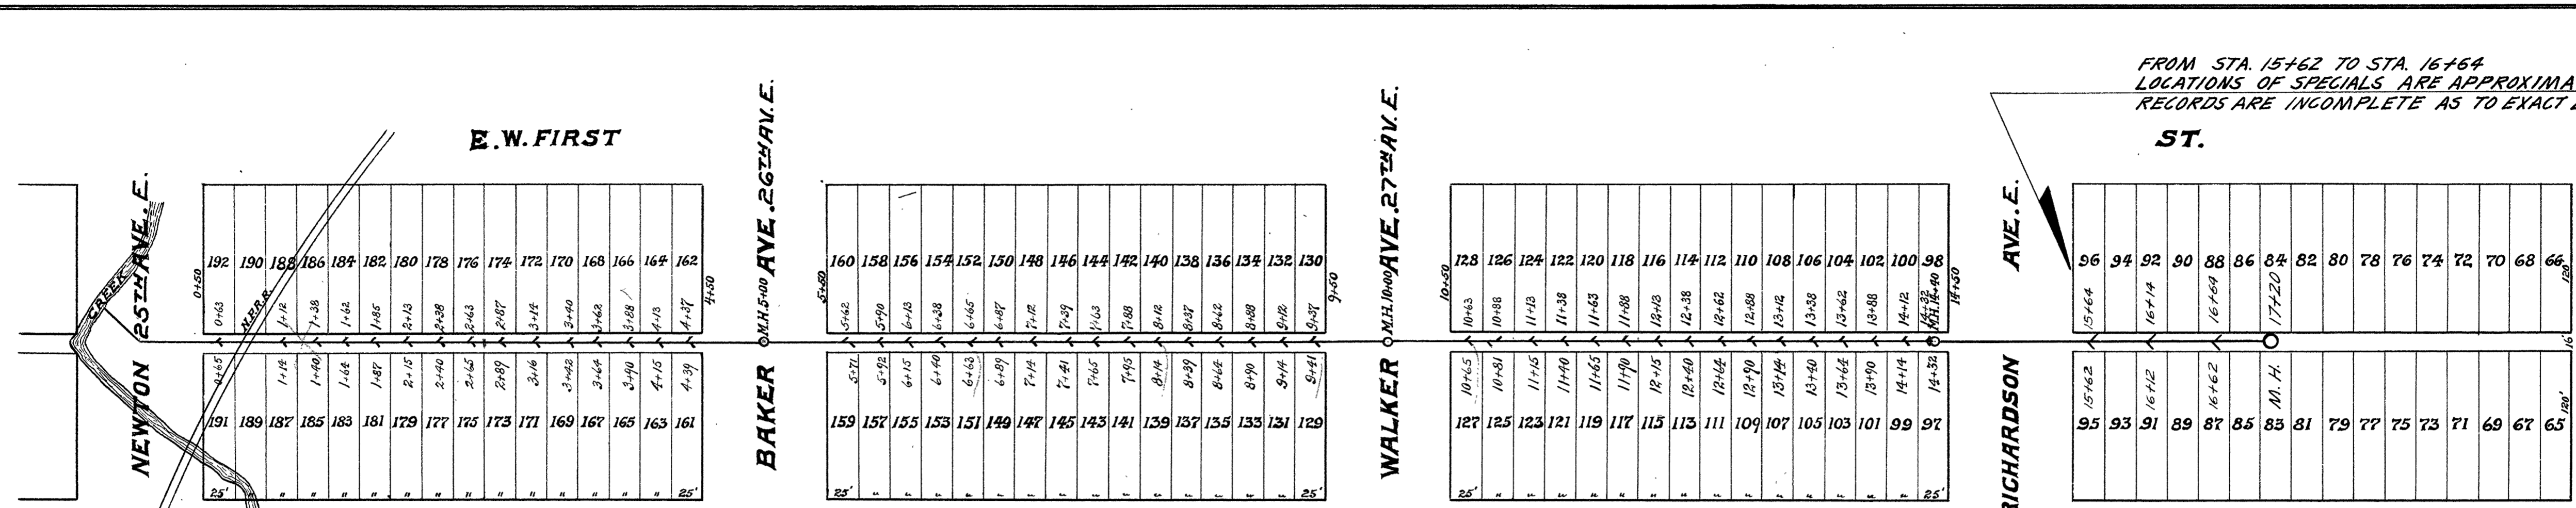