


**CITY OF SUPERIOR
SEWER PLAN**

HORIZONTAL SCALE 1"=60'
VERTICAL SCALE 1"=60'

JOB STARTED JANUARY, 1936
JOB COMPLETED SEPT, 1936
W. P. A. LABOR
SKAMSER-DANN INSPECTOR

L.W. PELESKE CITY ENGINEER

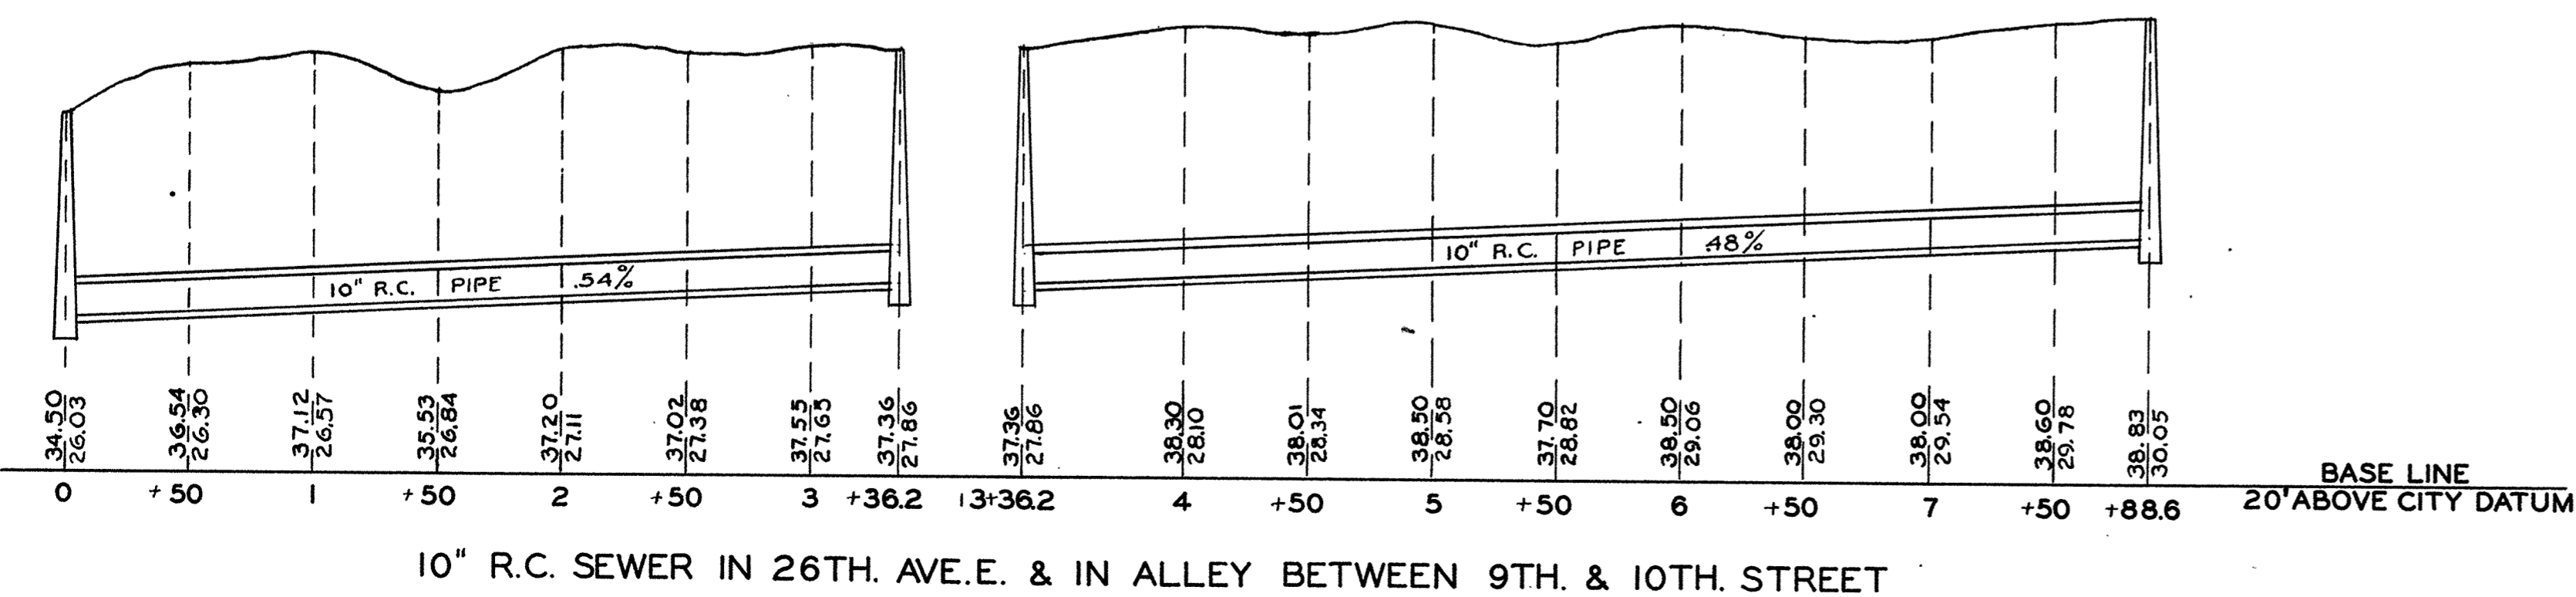

4-49