



CITY OF SUPERIOR SEWER PLAN

Contract let May 26, 1890
relet April 3, 1891
Forrestal Bros. (failed) & F.A. Dole, Contrs.
Contract completed Aug. 1, 1891
Frank Richardson, Inspector
E.B. Banks, City Engr.


Scale { Horizontal 1"=60'
Vertical 1"=4'
Section 1"=4'

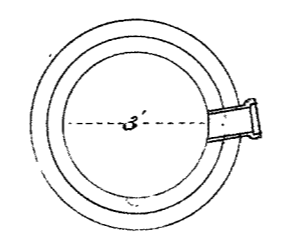


Section of 3' Sewer

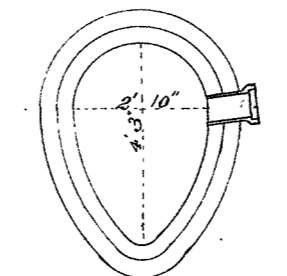


Section of 2'10" x 4'3" Sewer

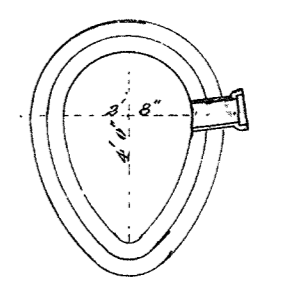


Section of 2'8" x 4'0" Sewer

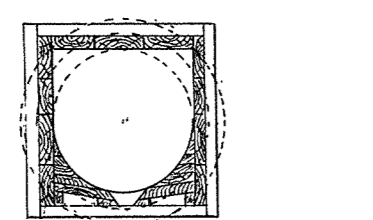

Section of Box at Junction

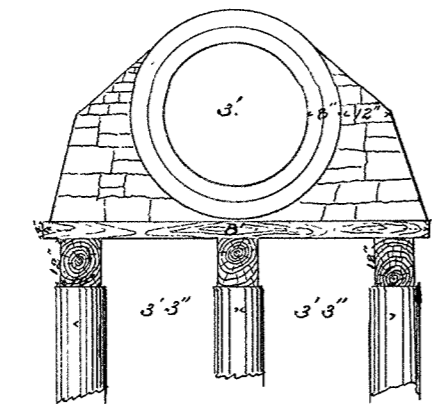

Section of 3' Sewer on Piles

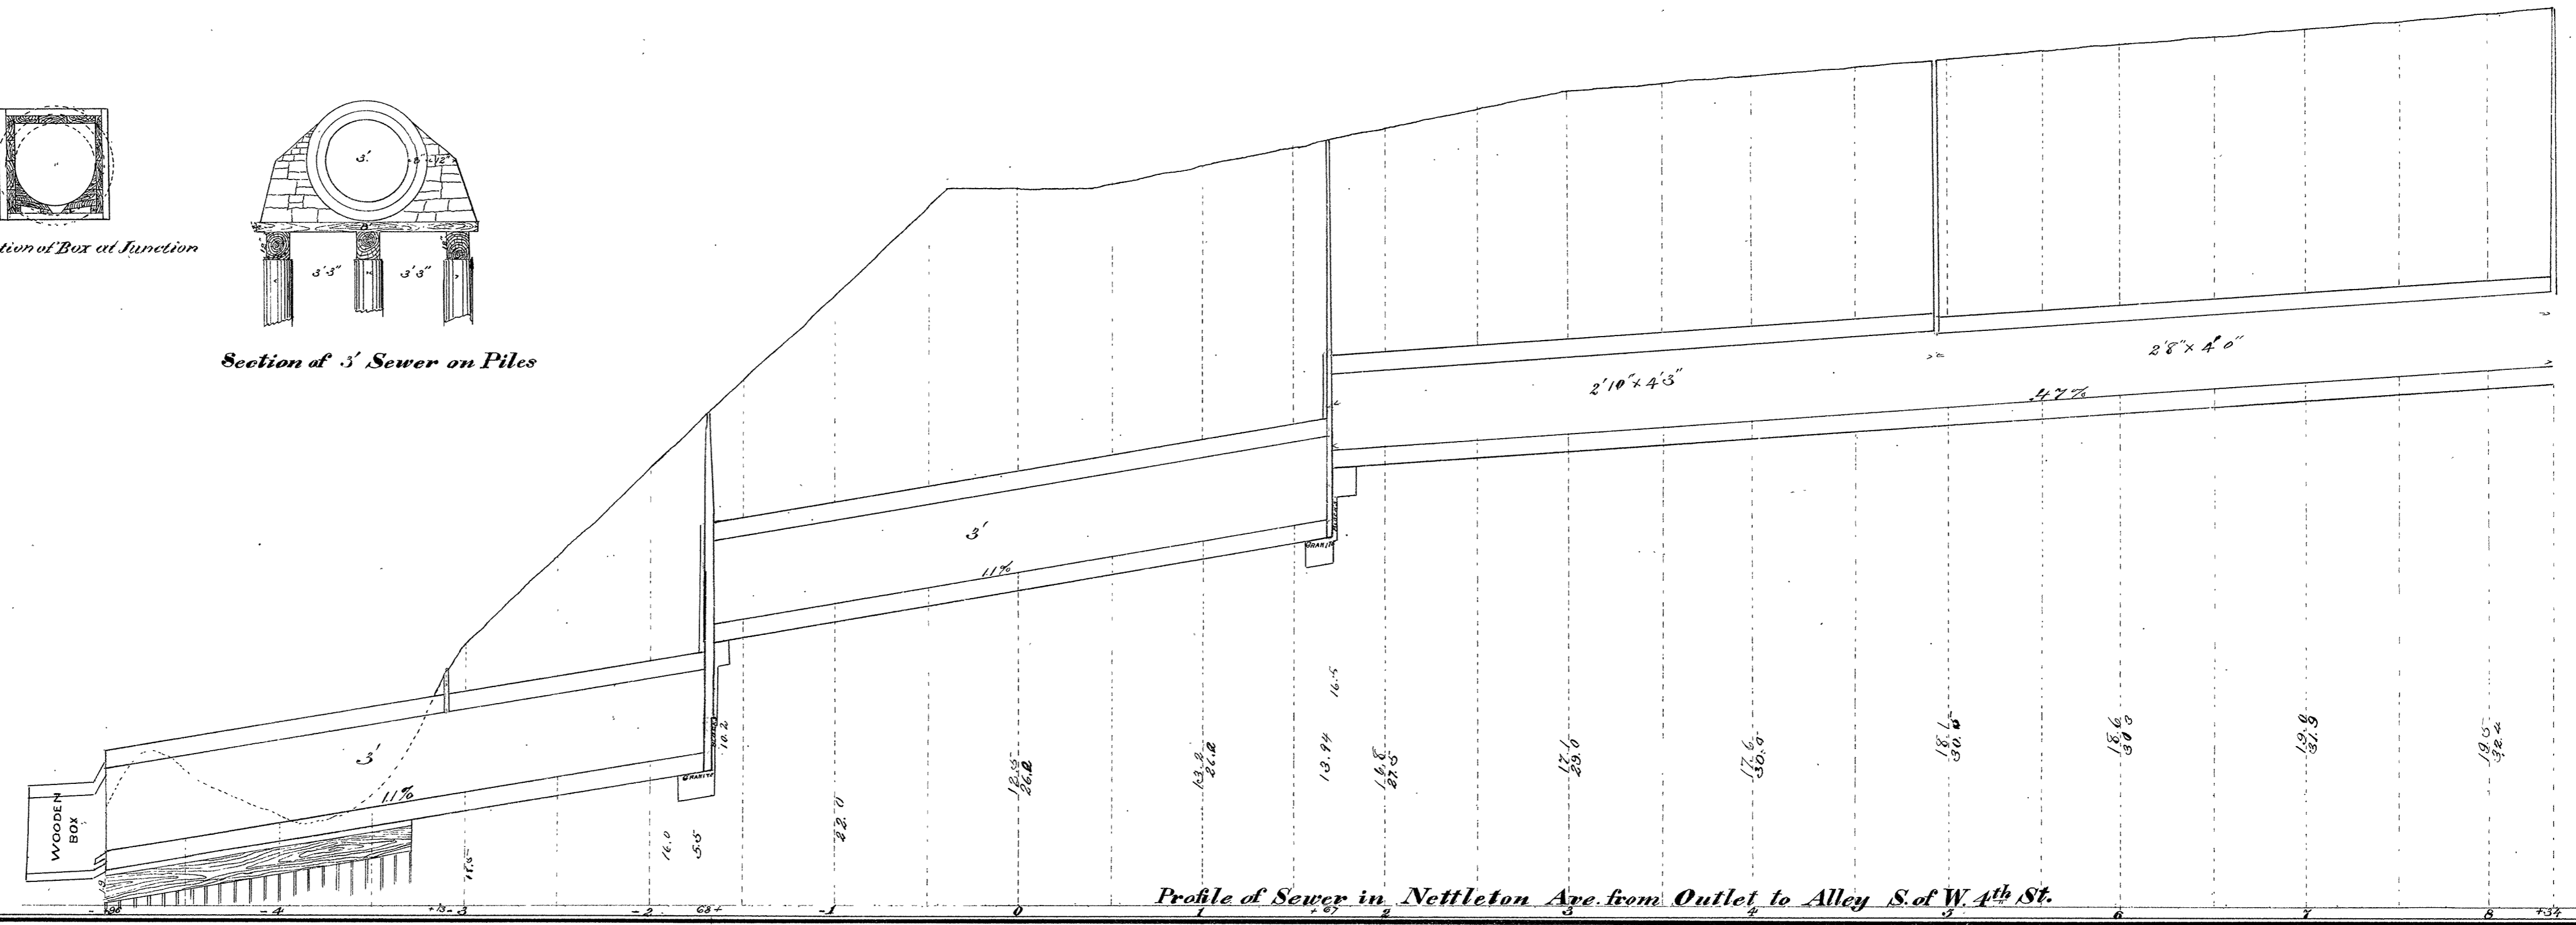

Profile of Sewer in Nettleton Ave. from Outlet to Alley S. of W. 4th St.