




# SUPERIOR

WISCONSIN

Living up to our name.

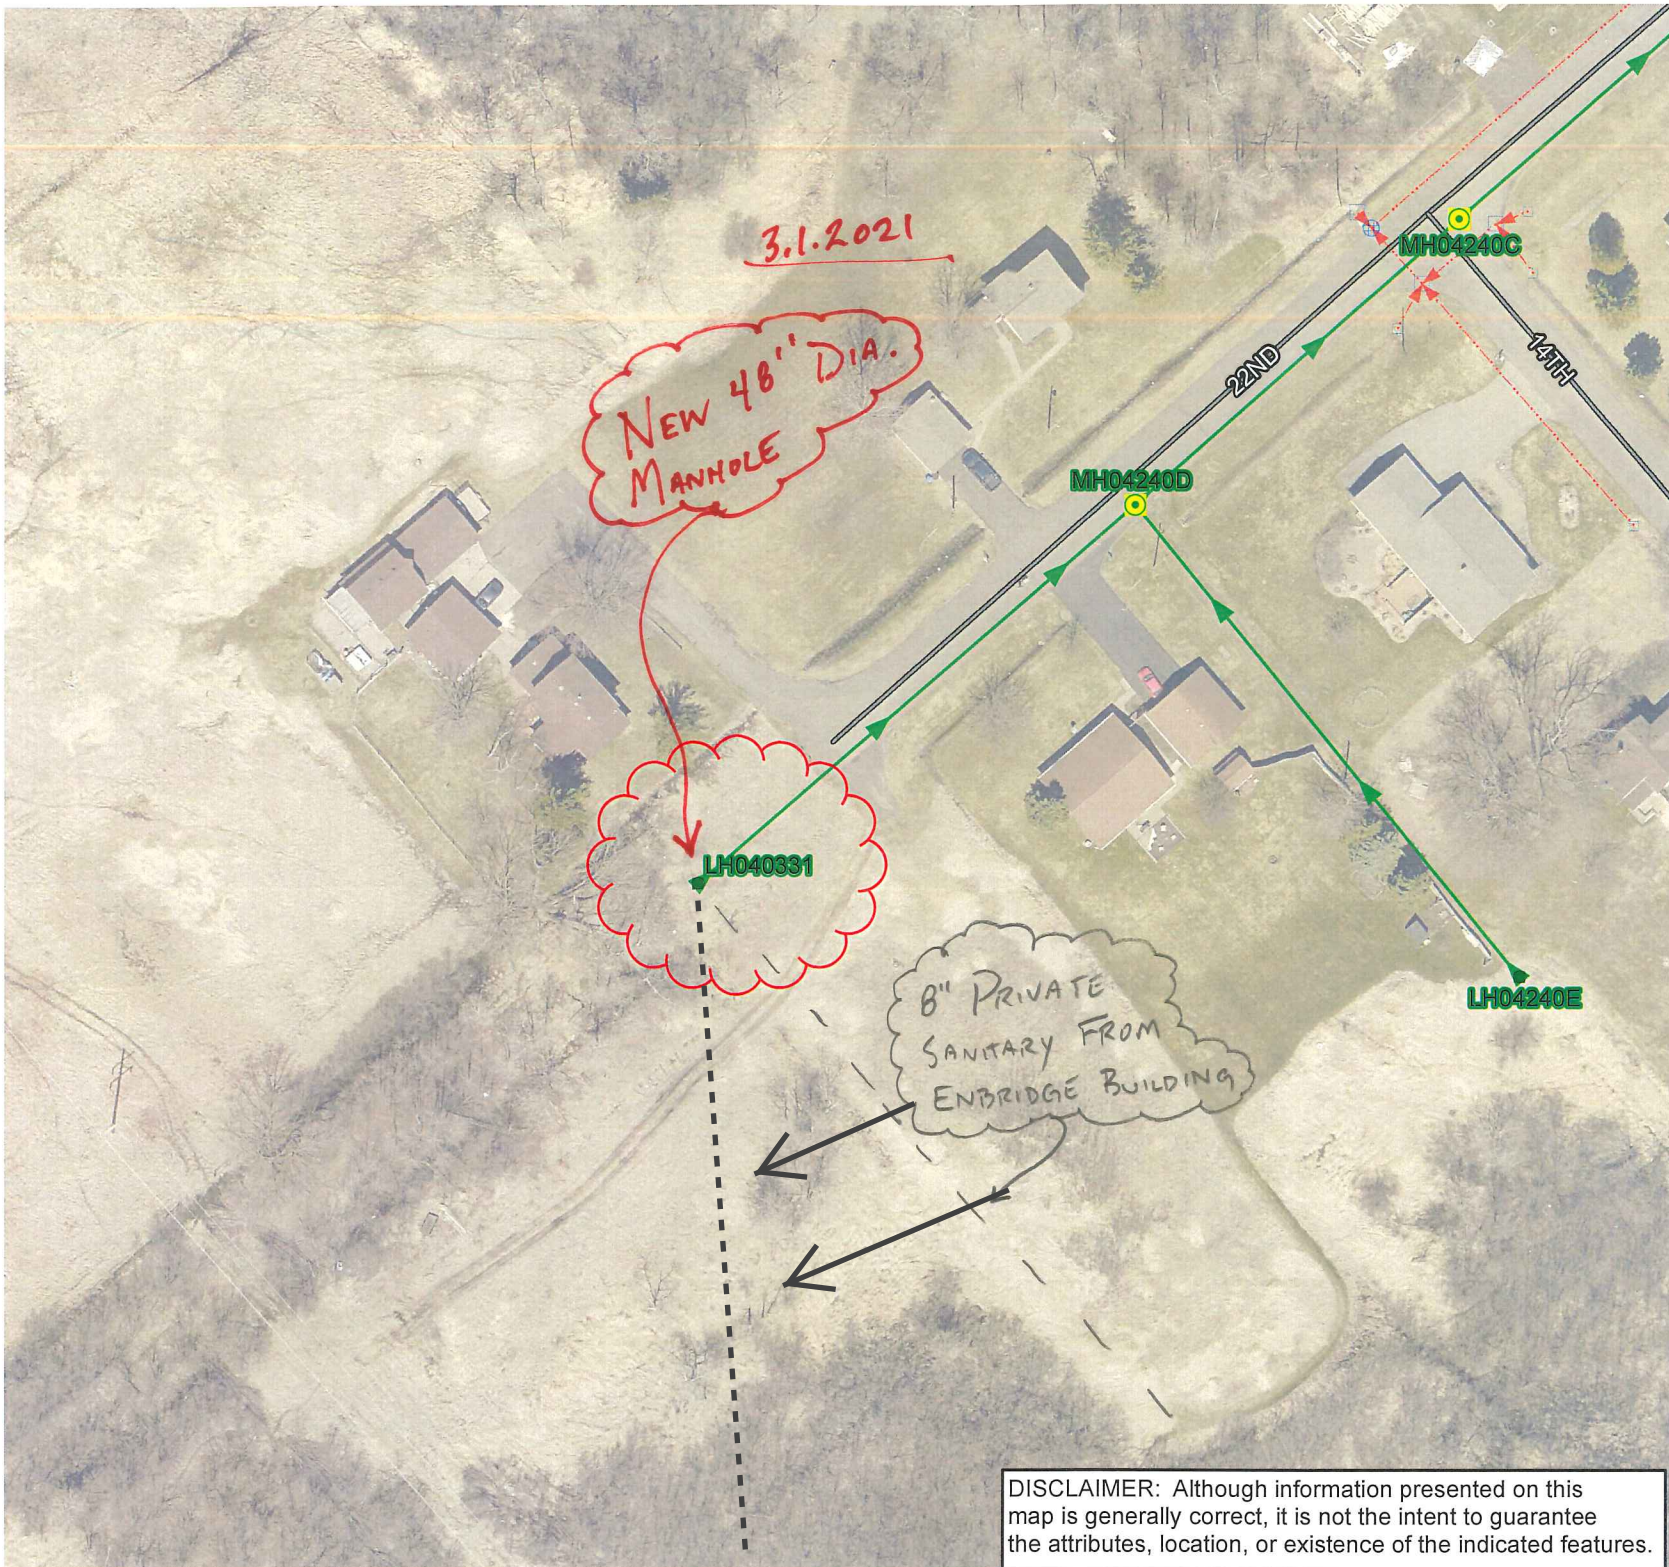

### Legend

#### Sanitary Structures

- Manhole
- Lamp Hole

#### Sanitary Sewers

- Sanitary Branch

#### Storm Structures

- Manhole
- Inlet / Catch Basin
- Surface Drain

#### Storm Sewers

- Active



0 25 50 FEET

3/2/2021 11:59:45 AM

DISCLAIMER: Although information presented on this map is generally correct, it is not the intent to guarantee the attributes, location, or existence of the indicated features.