


STINSON AVE.

OAKES AVE.

AVE.

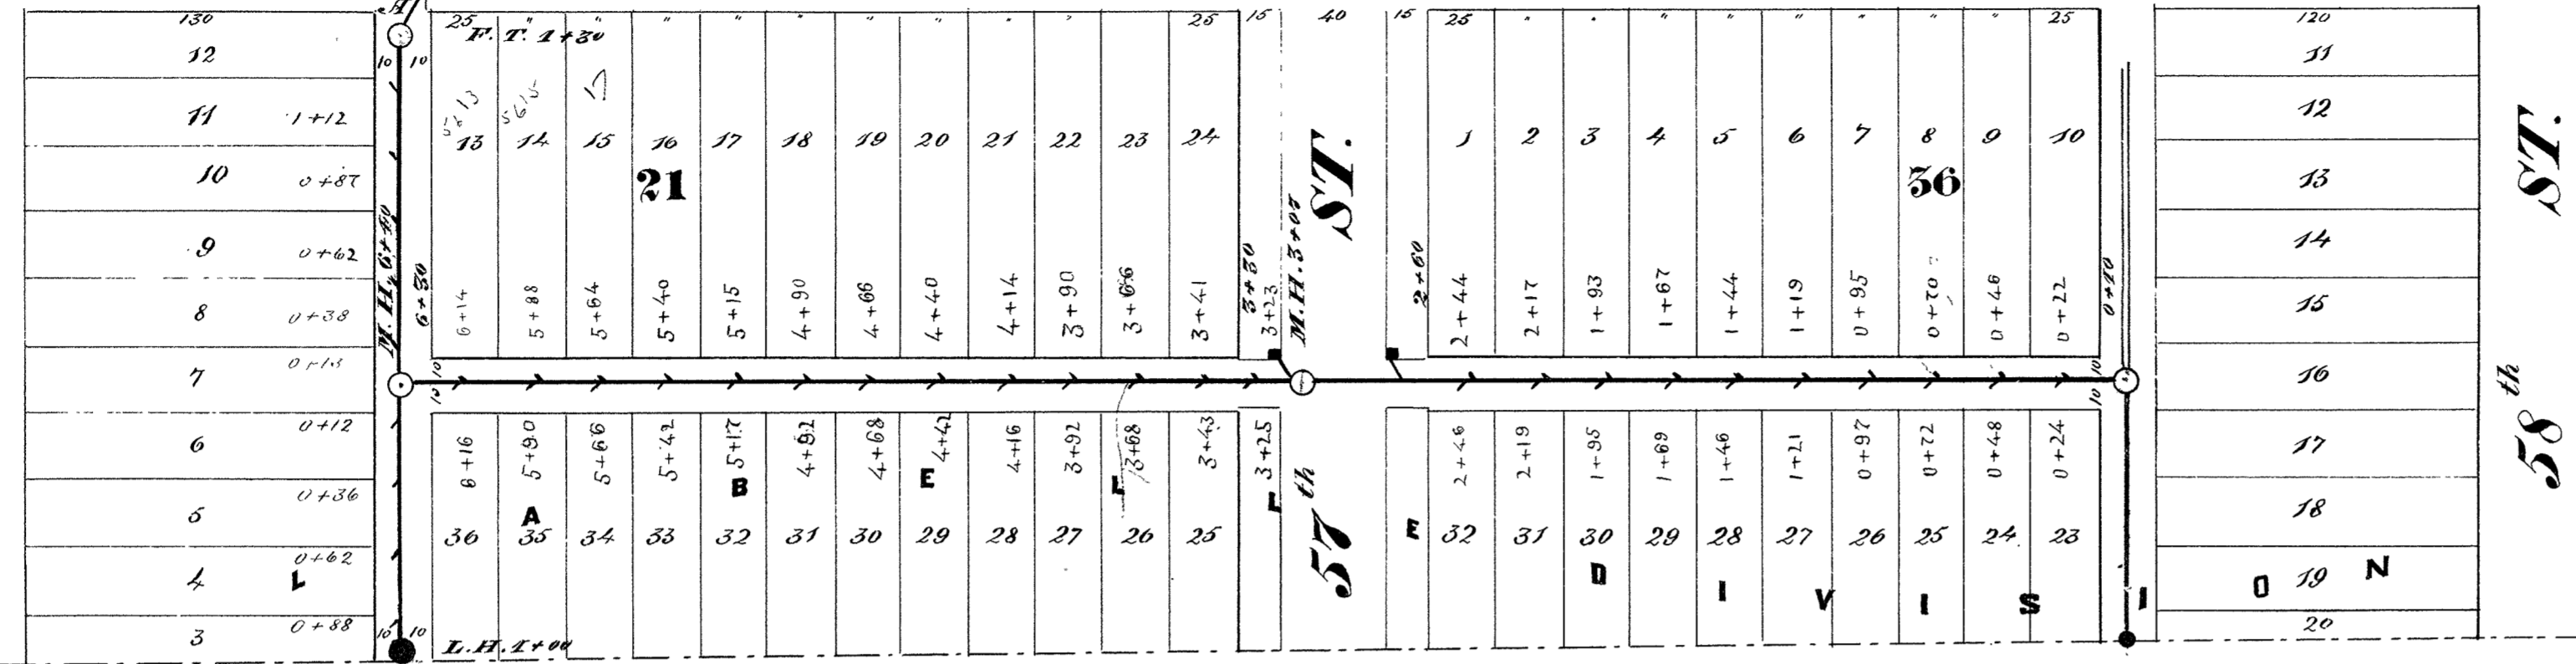


**CITY OF SUPERIOR
SEWER PLAN**


Contract let May 23, 1892
 " completed Nov 1, 1892
 Johnson & Dole, Contractor
 T. A. King, Inspector
 A. S. Cooper, City Engr.

1893


Scale: { Horizontal 60' = 1"
 Vertical 4' = 1"
 Section 2' = 1"

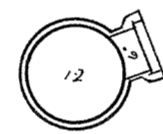


Section of 12" Pipe

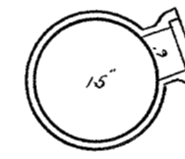


Section of 15" Pipe

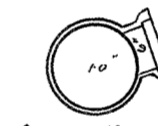

Section of 10" Pipe

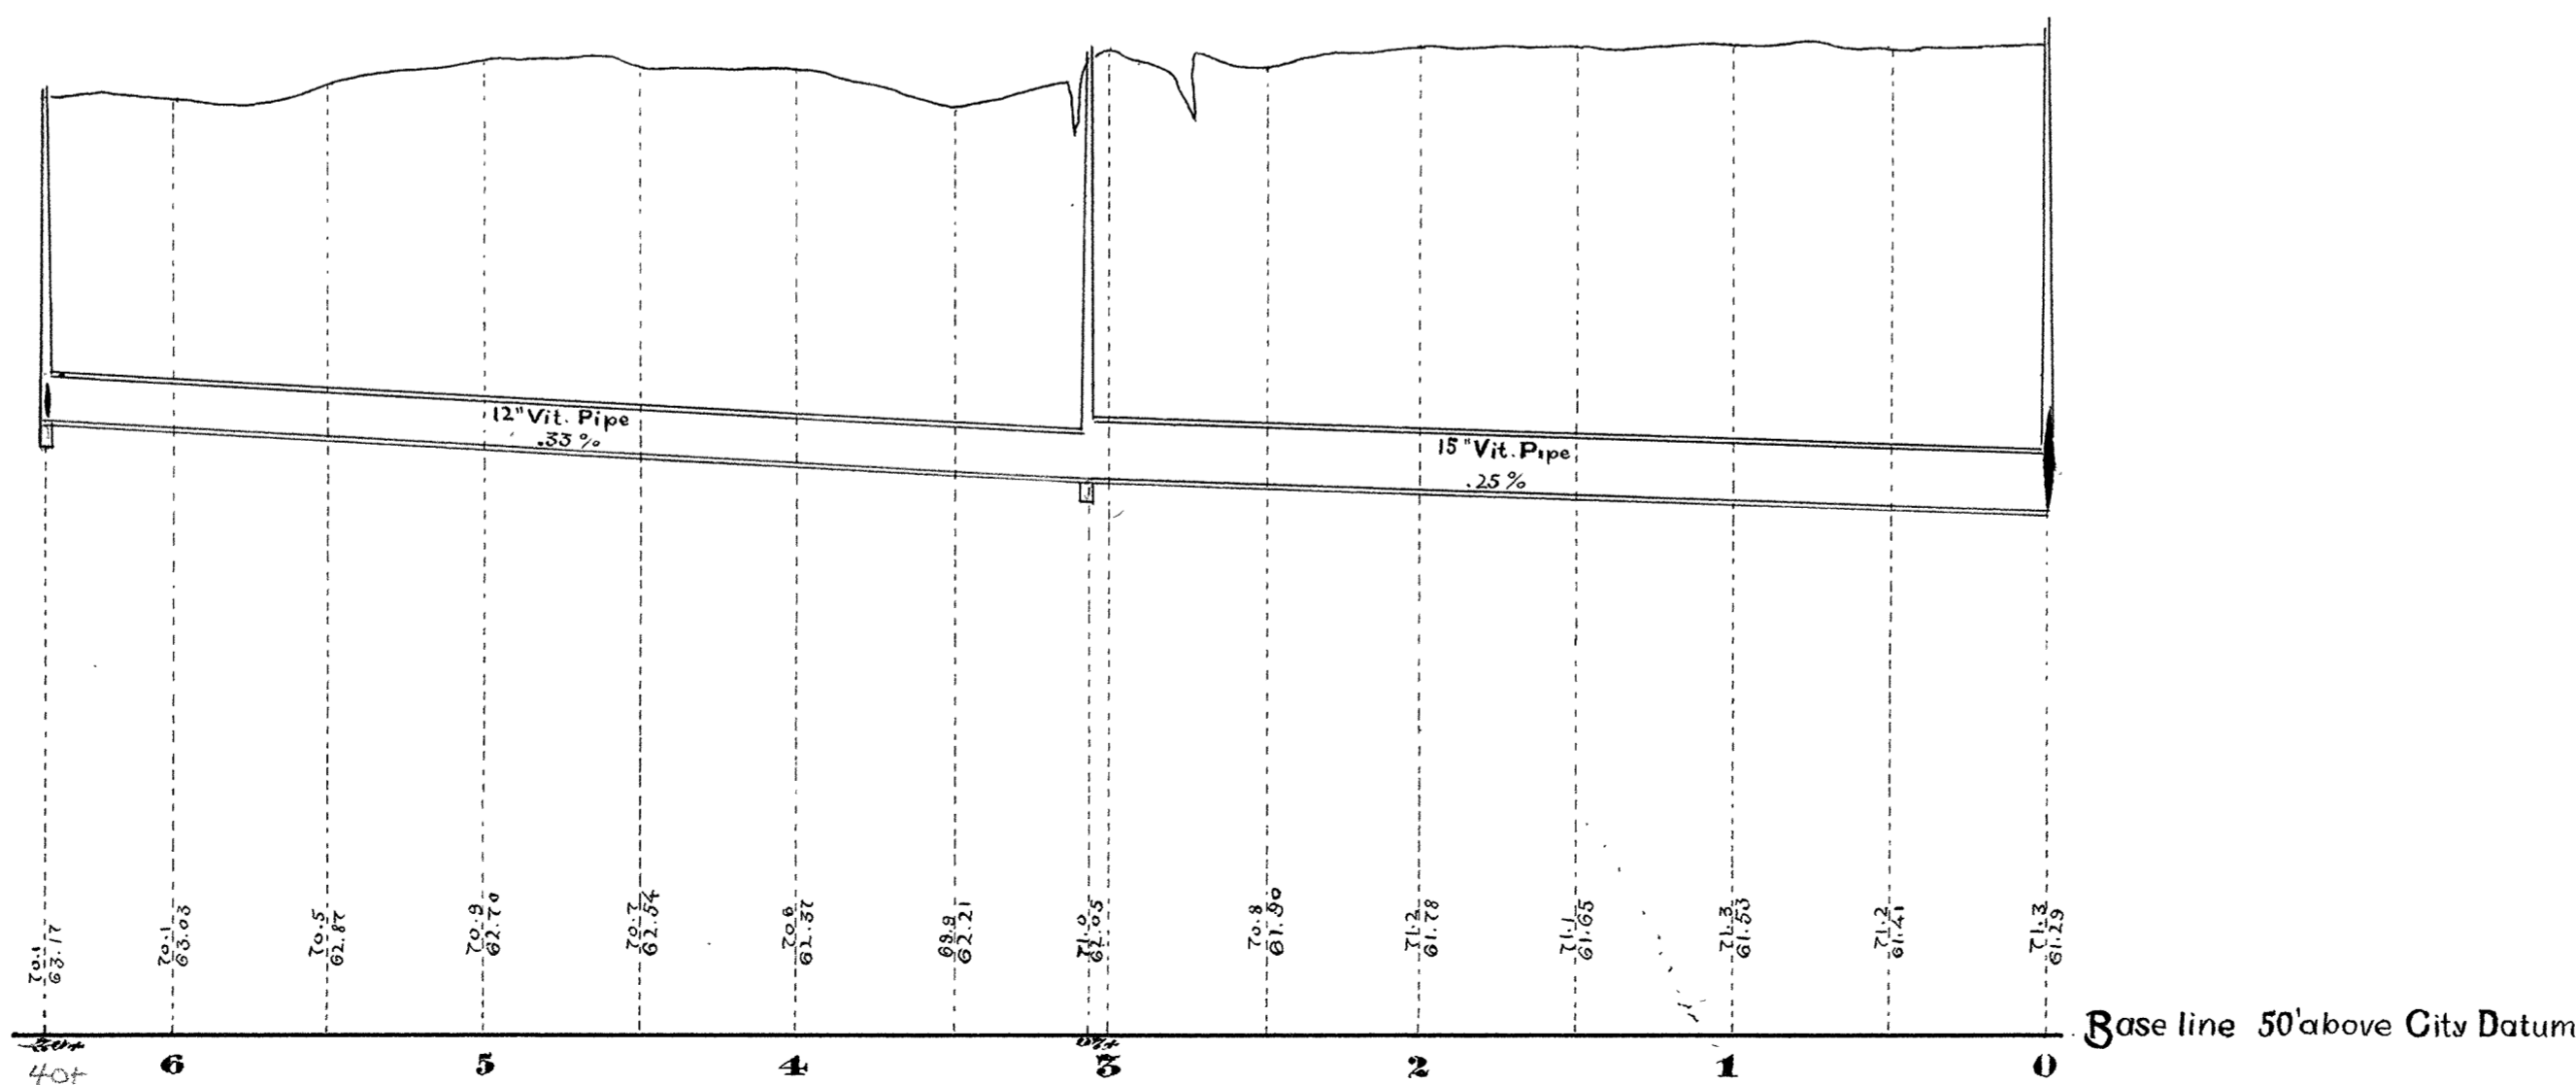

Plan & Profile of Sewer in Alley West of Oakes Ave. from 58th St. to Stinson Ave.

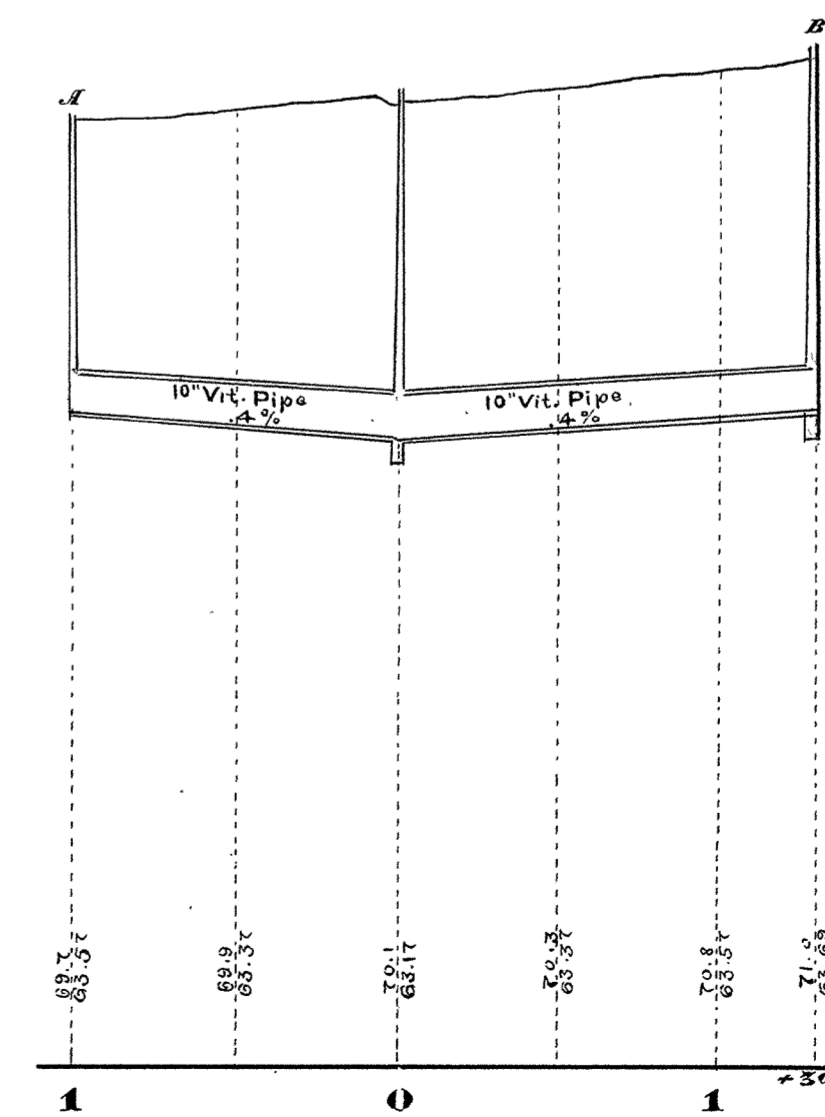

Profile of Sewer from A to B

5-1