
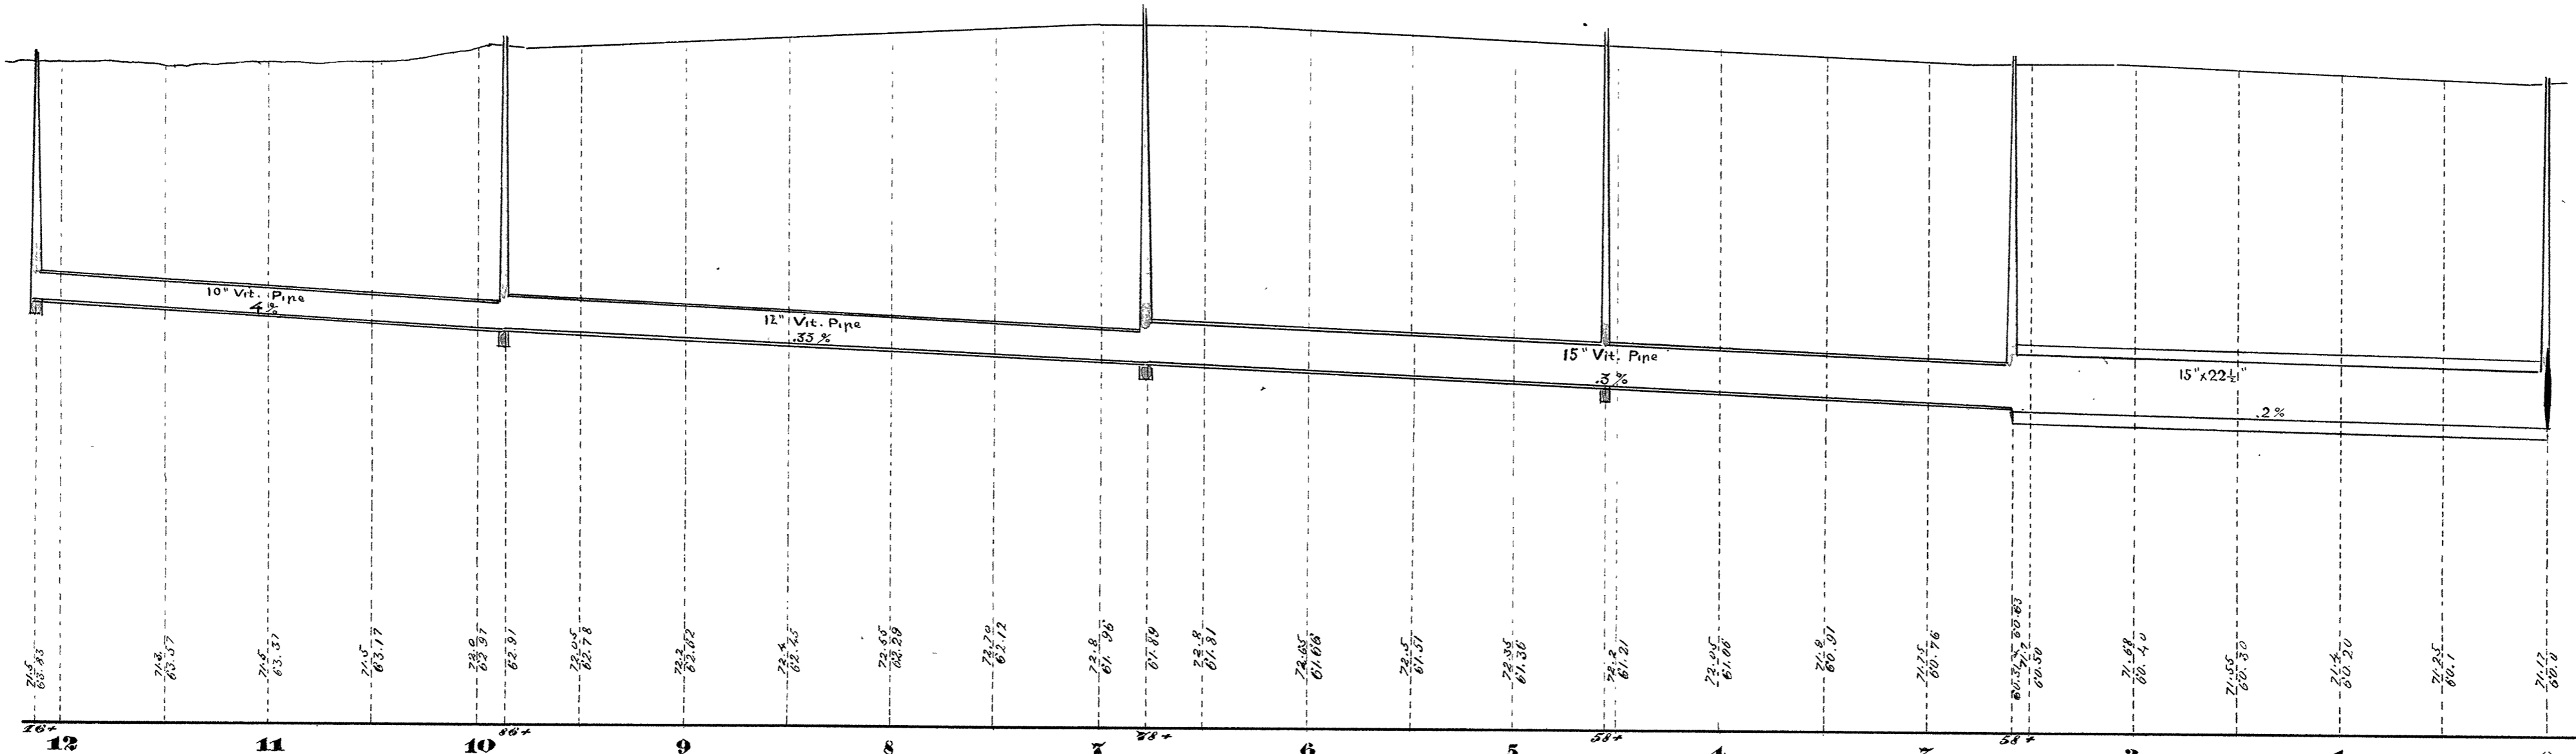


1893

**CITY OF SUPERIOR  
SEWER PLAN**

Contract let Feb. 4, 1892  
 completed Sept. 1, 1892  
 Wolf & Kihl, Contractor  
 Duff, Carlson & Lanigan, Inspts.  
 A. S. Cooper, City Engr.

Scale: { Horizontal 60' = 1"  
 Vertical 4' = 1"  
 Section 2' = 1"

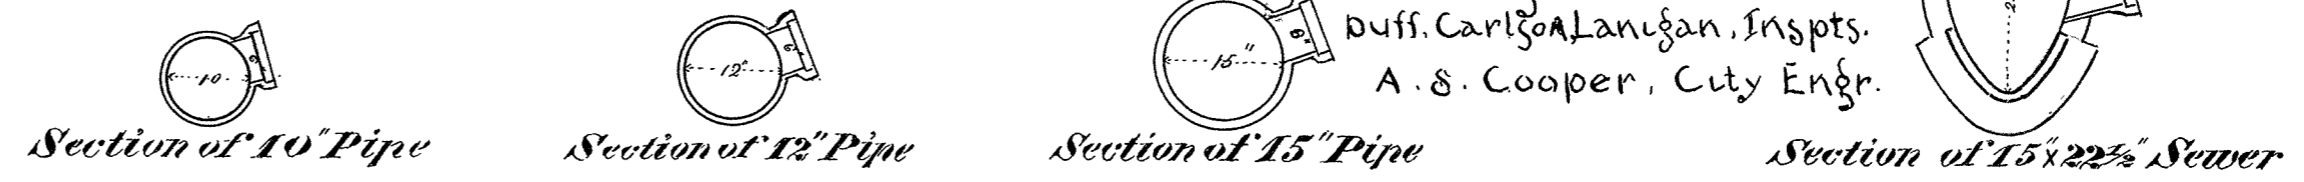

Plan & Profile of Sewer in Oakes Ave. from Central Ave. to Fiftyeighth Street and Lateral

Base line 50ft. above City Datum