

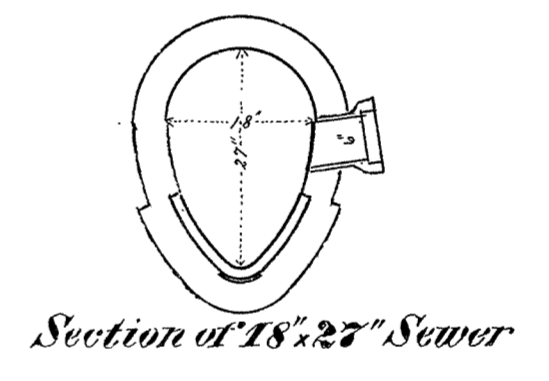
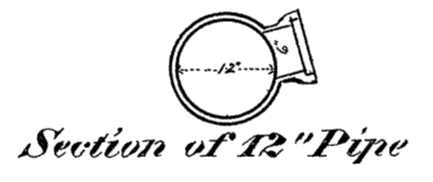


CITY OF SUPERIOR 1893
SEWER PLAN

Contract let Feb. 4, 1892
 completed Sept. 1, 1892
 Wolf & King, Contractor
 Lanagan, Carlson & Dailey, Inspts.
 A. S. Cooper, City Engr.

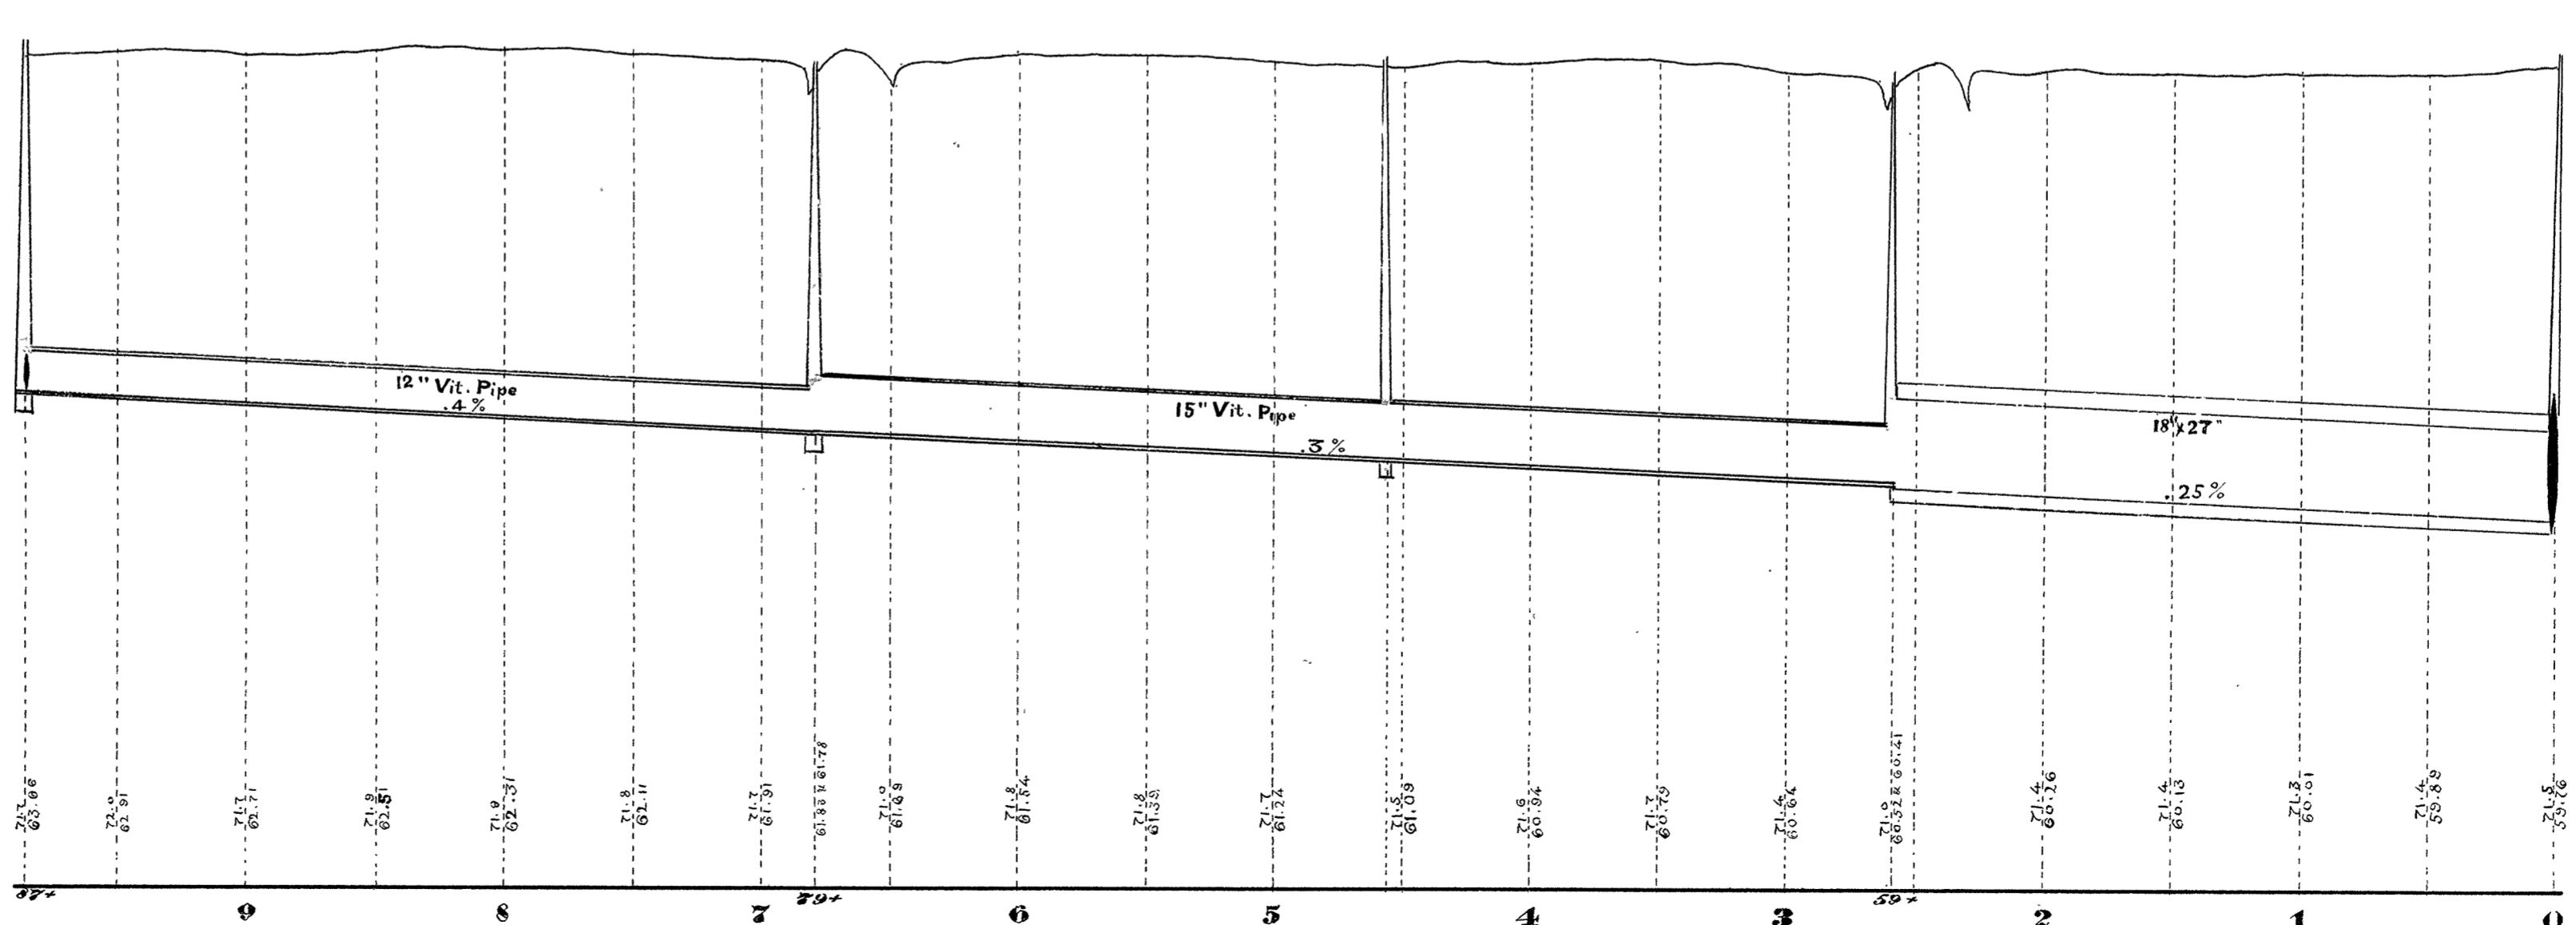

Scale: Horizontal 60' = 1"
 Vertical 4' = 1"
 Section 2' = 1"

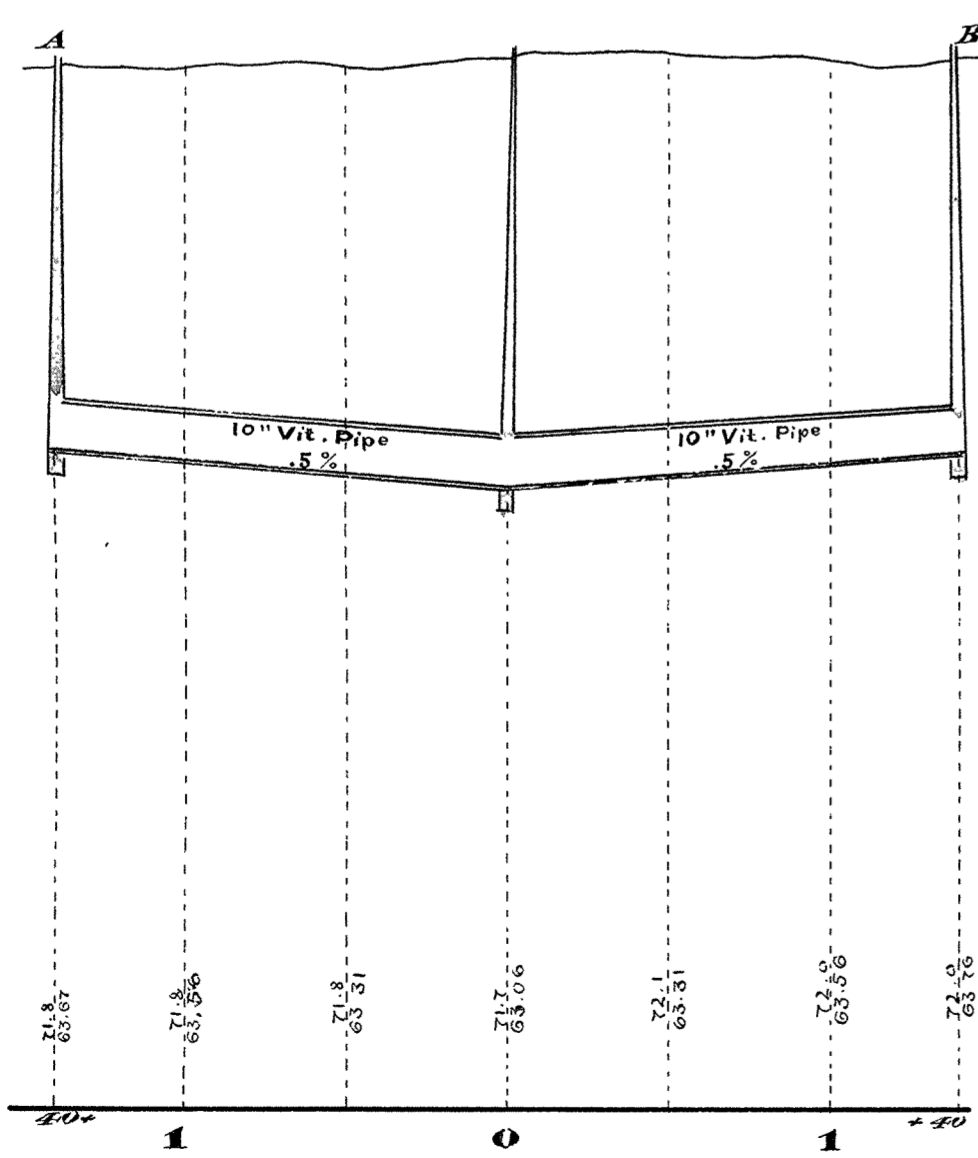

Base line 50' above City Datum